


Lat. N - Dist. 0 - S.S. No. 12  
W.B. Carter - 1937

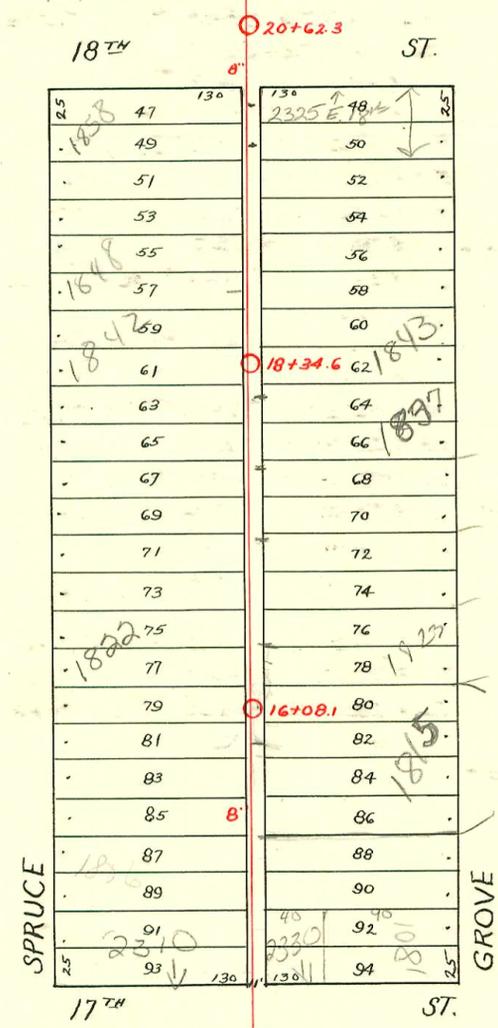

17<sup>TH</sup> ST. ST. ST.

13+82.0

C 202

CONSTRUCTION RECORD						SERVICE RECORD						
STATION	ELEVATION		Depth	MANHOLE	4-INCH "Y" BRANCHES		No. of Permit		House Number		DATE OF PERMITS	
	Ground	Grade			North West	South East	North West	South East	North West	South East	North West	South East
13+82	124.30	115.10	9.12	13+82.0								
14+00	124.50	115.20	9.30		14+37.2	14+34.2	#971	#1595	1802 N. Spruce	1801 N. Grove	2-4-42	5-25-39
					+62.2	+59.2		#1441		2330 E. 17th		5-29-52
					+86.7	+83.7						
15+00	123.90	115.30	8.60		15+08.1	15+08.1	#2071	#10474	1806 N. Spruce	1805 N. Grove	5-23-45	9-12-68
					+35.4	+32.4	#25		1812 N. Spruce		5-14-47	
					+60.1	+57.1		#4373		1813 N. Grove		4-16-51
					+84.1	+81.1		#3571		1815 N. Grove		11-20-63
												5-21-41
16+00	124.10	115.40	8.70	16+08.1	16+17.8	16+14.8	#1981	#1673	1822 N. Spruce	1823 N. Grove	4-12-48	2-29-48
					+42.3	+39.3					4-6-48	
					+67.3	+64.3						
					+91.7	+88.7					4-6-48	
17+00	124.20	115.50	8.70		17+13.1	17+10.1		#1958	1826 N. Spruce	1827 N. Grove	4-6-48	2-17-49
					+37.4	+34.4						
					+62.0	+59.0	#1814	#1959	1832 N. Spruce	1831 N. Grove	9-27-49	2-17-49
					+86.5	+83.5	#1979		1838 N. Spruce		4-6-48	
18+00	124.40	115.60	8.80		18+10.6	18+07.6		#1674	1837 N. Grove	1837 N. Grove	4-6-48	11-4-42
						+25.7		#563	1737 N. Grove			2-27-48
					18+34.6	18+40.9	#1978		1842 N. Spruce	1843 N. Grove	4-6-48	10-13-48
					+59.5	18+56.5		#1675	1848 N. Spruce			2-27-48
					+83.7	+80.7	#1977				4-6-48	
19+00	124.50	115.70	8.80		19+11.2	19+08.2		#1676	1847 N. Grove			2-27-48
					+35.2	+32.5	#1976		1852 N. Spruce		4-6-48	
					+59.8	19+56.8		#1677	1853 N. Grove			2-27-48
					19+84.3	+81.3	#1975		1858 N. Spruce		4-6-48	
20+00	124.80	115.80	9.00		20+08.5	20+05.5	#6680		2325-27 E. 18th		12-3-51	
					20+62.3	20+96.7	#2059	#1369	1902 N. Spruce	1903 N. Grove	4-13-48	10-11-42
						21+20.8						6-23-50
21+00	125.40	115.90	9.50		21+20.8	21+17.8	#2060		1908 N. Spruce		4-13-48	
					+45.3	+42.3						
					+73.0	+70.0						
					+97.0	+94.0	#2061	#909	1912 N. Spruce	1907 N. Grove	4-13-48	1-24-42
22+00	126.00	116.00	10.00		22+21.9	22+18.9	#2062	#2602	1918 N. Spruce	1915 N. Grove	4-13-48	8-28-42
					+46.3	+43.3						
					+70.7	+67.7						
					+98.8	+95.3	#2063	#3462	1922 N. Spruce	1919 N. Grove	4-13-48	12-26-50
23+00	126.50	116.10	10.40		23+22.7	23+19.7	#2064	#1948	1928 N. Spruce	1925 N. Grove	4-13-48	4-3-48
					+46.9	+43.9						
					+71.7	+68.7						
					+95.8	+92.8	#2065	#1947	1932 N. Spruce	1929 N. Grove	4-13-48	6-3-48
24+00	127.20	116.20	11.00		24+23.3	24+20.3	#2066	#1946	1938 N. Spruce	1935 N. Grove	4-13-48	4-3-48
					+47.7	+44.7						
					+72.0	+69.0						
					+96.4	+93.4						
25+00	128.60	116.30	12.30		25+24.0	25+21.0	#178		1942 N. Spruce	1939 N. Grove	6-10-48	4-3-48
					+48.4	+45.4						
					+73.3	+70.3	#1848	#1846	1950 N. Spruce	1949 N. Grove	1-3-49	1-3-49
					+97.2	+94.2						
26+00	129.30	116.40	12.90		26+22.2	26+19.2	#1849	#1847	1956 N. Spruce	1955 N. Grove	1-3-49	1-3-49
					+47.4	+43.4						
26+60.5	128.90	116.46	12.44	26+60.5								

2002-02922-114102 1837 N Grove - Glover Ent - 4" SCH 40 Mission Band 21' from main

#1219 Tap - 2330 E. 17th - 6-6-50 - Ray  
 #92-35014-7 - 1903 N. Grove - 4" SCH 35 - 74' rail - Replaced Clay tile from house to main 10ft of main - Alloy Cut  
 94 8467 53194 (2310 E 17th) - Board man - 3/8 G.I. N (H 4450) of MH #1342.0 - 3/4" off w/ contents