


WICHITA UNIVERSITY PRIVATE SEWER
Utility Cont., Inc. - Nov. 1952
BK. JT. 58

0+0 existing M.H. 10' North of N.P.L. 18" Dia. Begin W.U. Private Sewer
M.H. 1+77.9
D.H. 3+31.9
6" N. of N.P.L. End W.U. Private Sewer
8" 6" 1' ±

N 30' of 18th ST VACATED By DIST COURT Case # 19,980

18th ST VACATED By ORD # 36-051 PUE Retained
Alley vacated

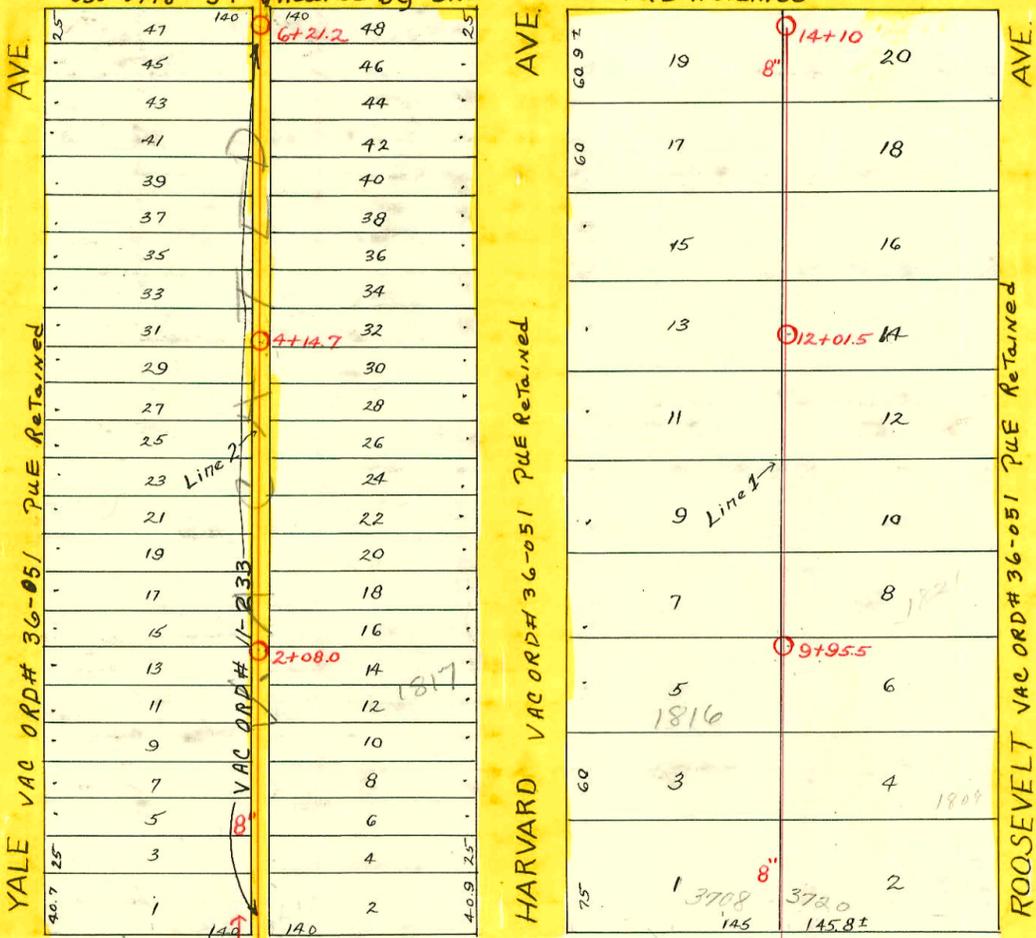

Priv. line on Priv. Prop. No. Rec. North

Depth 6 3/4 to Flg
1816
1817
1809
1816
1817
1809
1816
1817
1809

CONSTRUCTION RECORD

SERVICE RECORD

Line East
in 17th &
No. Bet.
Harvard &
Roosevelt

Line North
bet. Yale &
Harvard.

Wichita Univ.
Private Sewer

STATION	ELEVATION		Depth	MANHOLE	4-INCH "Y" BRANCHES		No. of Permit		House Number		DATE OF PERMITS	
	Ground	Grade			North West	South East	North West	South East	North West	South East	North West	South East
0+42	197.70	189.50	8.20	0+42.5								
1+00	196.80	189.56	7.24									
2+00	196.30	189.66	6.64									
3+00	196.40	189.76	6.64	3+95								
4+00				4+30								
5+00	198.30	190.18	8.12									
6+00	199.40	190.29	9.11									
7+00	200.60	190.38	10.22	7+88								
8+00	203.10	190.64	12.46		8+13	8+10						
					+49.5	+46.5	#2130	SD	370 E.			10-21-49
					+89.0	+86.0	#4916	#7144	3708 E	17th	1809 N.	4-22-75
							#1037	#5292	17th	Roosevelt		4-26-79
9+00	203.00	190.84	12.16		9+16	9+13	#7144		1810		10-31-41	5-21-53
					+47	+44	#915		Harvard		9-13-48	
					+77	+74	#4379	#7144	1812		3-9-53	4-26-79
								#6963	Harvard	1815 N.		11-12-53
										Roosevelt		
10+00	203.80	191.09	12.71	9+95.5		10+03.5	#6964	#6964	1821 N.		8-23-78	11-12-53
					10+23		#2879		1822 S.		6-1-74	
					+37	+34			Harvard		11-18-40	
					+68	+65						
					+96	+93	#6393		1828 S.		4-23-77	
					+60	+57	#3676		Harvard		6-12-41	
11+00	205.30	191.81	13.49		11+26	11+23	#2972		1834 S.		12-23-40	9-9-76
					+87.5	+84.5	#55763		1840 S.		50-6-7-76	
							#3175		Harvard			
12+00	207.20	192.53	14.67	12+01.5	12+17	12+14						
					+48	+45						
					+78.5	+75.5						
13+00	208.50	193.25	15.25		13+08	13+05						
					+38.5	+35.5	#55766		1854 S.		6-7-76	
					+69.5	+66.5	#855		Harvard		1-2-42	
					+99.5	+96.5						
14+00	209.60	194.00	15.60	14+10								
0+0	197.70	190.20	7.50	0+0	0+27	0+24	#2898		3426 E.			11-23-40
					+53	+50			1805 S.			4-26-79
					+78.1	+75.1	#2952		Harvard			12-12-40
					+99.3							
1+0	199.50	190.30	9.20	1+02.3	1+27	1+24	#7144	#2861	1812 N.	1811 S.		4-26-79
					+50.6	+47.6	#1269		Yale	Harvard		11-20-40
					+76.3	+73.3	#7144	#304	1818 N.	1817 S.		4-13-42
					+99.9	+96.9	#1268		Yale	Harvard		3-23-42
2+0	198.50	190.40	8.10	2+08	2+24.1	2+21.1	#1267	#152	1822 N.	1825 S.		4-76-79
					+51.9	+48.9			Yale	Harvard		10-10-78
					+76.2	+73.2	#1267					3-11-52
						+97.7						7-10-78
3+0	199.30	190.50	8.80	3+00.7	3+24.7	3+21.7	#1266	#3117	1828 N.	1829 S.		4-13-42
					+49.3	+46.3			Yale	Harvard		3-23-42
					+74.3	+71.2	#1265		1832 N.			9-9-76
					+98.8				Yale			11-14-50
4+0	200.60	190.60	10.00	4+01.8	4+27.9	4+24.9	#1264	#1241	1838 N.	1839 S.		7-10-78
					+52.3	+49.3	#949		Yale	Harvard		3-23-42
					+76.4	+73.4	#3767		1842 N.	1845 S.		7-10-78
					+98.3				Yale	Harvard		4-13-42
5+0	201.80	190.70	11.10	5+01.3	5+25.8	5+22.8	#948	#933	1848 N.	1851 S.		3-23-42
					+50.2	+47.2				Harvard		2-2-42
					+74.3	+71.3						10-6-76
					+99.1							1-24-51
6+0	202.10	190.80	12.70	6+02.1								9-14-48
0+0	203.1	191.90	11.2	6+21.2			#7212	#3619				6-17-58
1+0	204.2	192.30	11.9									
	205.4	192.61 out	12.8	1+77.9								
		201.11 in	4.3									
2+0	205.6	201.60	4.0									
3+0	207.4	203.80	3.6		3+20.5		#5495		3600 E.			6-8-53
	208.1	204.50	3.6	3+31.9 (p.H)					18th			

8.0 59697-9-9-76-Al Henning 1816 N. Harvard (12+00.5)

Tap #1447 - 1838 N. Yale - 4-13-42 - Pray P/bg. Co.
 Tap #1448 - 1842 N. Yale - 4-13-42 - Pray P/bg. Co.
 Tap #1446 - 1832 N. Yale - 4-13-42 - Pray P/bg. Co.
 #722 - Private Line - Engineering Bldg. - Wichita Univ. - 9-27-46 - Pray Bros.
 #1806 - Tap - 1844 Harvard - 7-29-50 - Howard F. Cowan
 #6374 - Setting Wye - 1822 N. Yale - 9-8-53 - C.R. Leidy - Trailer
 #7451 - Private Line - 1822 N. Yale - 1-25-54 - C.R. Leidy - Trailer
 #1778 - Tap - 3602-04-06-08 - E. 17th - 4-26-54 - Phipp. P/bg. Co.
 #68886 (1816 Harvard) Seal off - Henning - 10-12-78
 50' 71441 - (51071 Yale) - 4-26-79 - Henning
 50' 71442 - (18105 N. Yale) - 4-26-79 - Henning
 #71451 - Seal off 4-26-79 - Al Henning (0+42.0)
 C 71451 - 3624 E. 17th - Seal off 4-26-79 - Al Henning (0+75.0)