



SEE P-138

8' of 15" PVC placed in 24" Pipe through Manhole 1990 San. Sew. Reconst. Phs I

WESLEY INTERCEPTOR  
MID STATES CONSTRU. CO.  
Booked - IH 6 - Project C28-41  
3-3-69

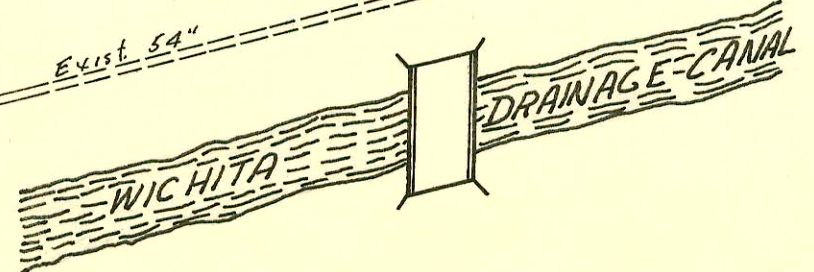

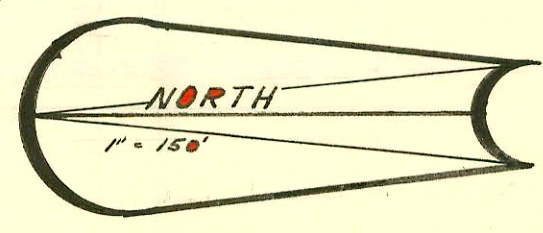

C-247B

Form 42-020

CONSTRUCTION RECORD						SERVICE RECORD						
STATION	ELEVATION		Depth	MANHOLE	4-INCH "Y" BRANCHES		No. of Permit		House Number		DATE OF PERMITS	
	Ground	Grade			North West	South East	North West	South East	North West	South East	North West	South East
49+00												
50+00												
	143.7	124.9	14.7	50+89 <sup>3</sup>								
51+00												
	144.0	129.4	14.6	51+30 <sup>3</sup>	21" stub E.							