

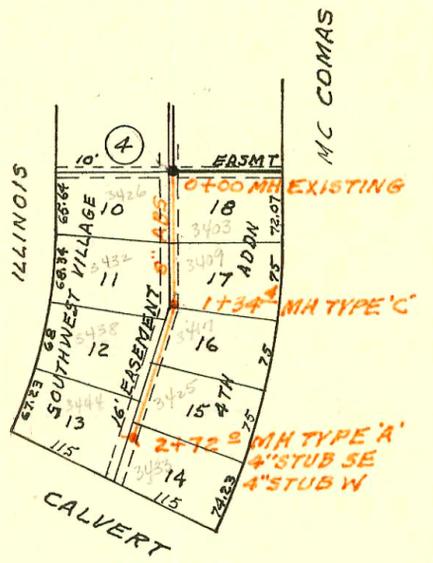
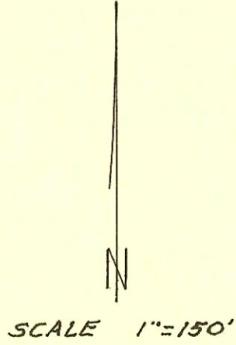




LATERAL 4 MAIN 23 S.S. N<sup>o</sup>22  
BUILT BY: SHAWNEE CONST. CO.  
PROJ. N<sup>o</sup> DBKL575011  
BOOKED 6-20-77 FROM G2

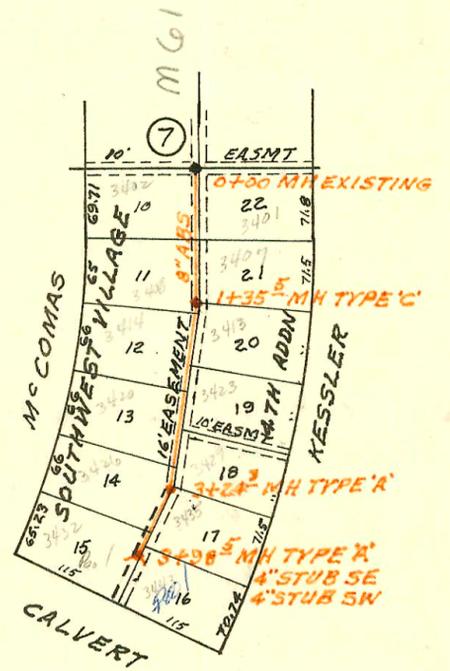

LATERAL 9 MAIN 23 S.S. N<sup>o</sup>22  
BUILT BY: SHAWNEE CONST. CO.  
PROJ. N<sup>o</sup> DBKL575016  
BOOKED 6-21-77 FROM G2

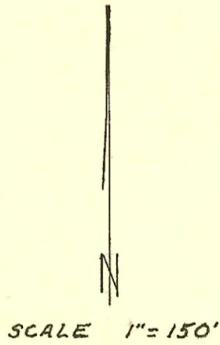

LATERAL 44 MAIN 1 SOUTHWEST INTERCEPTOR  
BUILT BY: DULLING CONST. CO.  
PROJ. N<sup>o</sup> DBKL576062  
BOOKED 6-21-77 FROM SRL 7

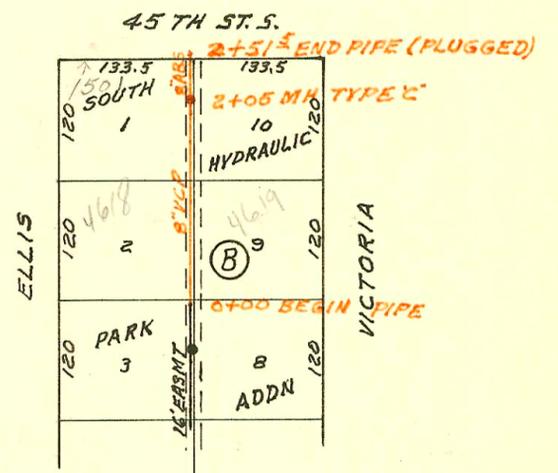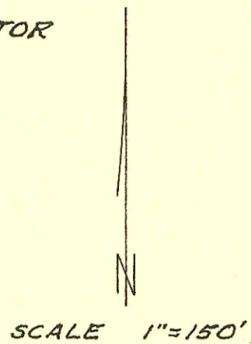

CONSTRUCTION RECORD

SERVICE RECORD

STATION	ELEVATION		Depth	MANHOLE	4-INCH "Y" BRANCHES		No. of Permit		House Number		DATE OF PERMITS	
	Ground	Grade			North West	South East	North West	South East	North West	South East	North West	South East
LATERAL 44 SW1 (CONT.)												
LINE 7 0+00	134.9	121.62	13.3	0+00=18+61 <sup>2</sup> LINE 1								
1+00	135.2 135.1	121.92 122.18	13.3 12.9	1+85.8	6" STUB N 6" STUB W	6" STUB S 5'0" Sec Below	# 02977		1423 S. Kings Rd.			3-31-81
LINE 8												
0+00	139.4	126.96	12.4	0+00=31+43 <sup>4</sup> LINE 1								
1+00	139.3 139.3	127.61 127.97	11.7 11.3	1+56.4	8" STUB W	6" STUB SW						
LINE 9												
0+00	140.0	129.54	10.5	0+00=47+67 <sup>3</sup> LINE 1								
	139.2	129.70	9.5	0+57.1	6" SDR 35 6" STUB S		91-395047		7761 W Kellogg	Leak Jet		12-30-91
LATERAL 4 MAIN 23 SS N <sup>o</sup> 22												
0+00	101.0	92.17	8.8	0+00 EXISTING	0+63.6	0+55.9	C65229	C65216	3422 S. McComas	3403 S. McComas		3-6-78
1+00	98.7	92.57	6.1		1+28.4	1+26.4	C61013	C65219	3432 S. McComas	3409 S. McComas		3-6-78
	98.4	OUT 92.71 IN 92.81	5.7 5.6	1+34.4	1+94.0	1+94.0	C61012	C63612	3438 S. McComas	3417 S. McComas		5-4-77
	98.6	92.97	5.6		2+26.5	2+37.4	C64708	C62896	3438 S. McComas	3425 S. McComas		1-3-78
2+00	98.3	93.22	5.1	2+72.0	4" STUB W	4" STUB SE			3433 S. McComas	3433 S. McComas		9-7-77
LATERAL 9 MAIN 23 SS N <sup>o</sup> 22												
0+00	100.3	91.47	8.8	0+00 EXISTING	0+74.7	0+54.1	C61805	C65221	3402 S. McComas	3401 S. McComas		7-13-77
1+00	100.0	91.87	8.1		1+24.4	1+26.5	C64175	C62711	3408 S. McComas	3407 S. McComas		11-23-77
	99.7	OUT 92.01 IN 92.11	7.7 7.6	1+35.5								
2+00	99.2	92.27	6.9		2+09.2	1+88.9	C62899	C64177	3420 S. McComas	3414 S. McComas		9-14-77
3+00	98.6	92.52	6.1		3+09.5	3+09.5	C65223		3423 S. McComas	3422 S. McComas		10-19-77
	98.4	OUT 92.59 IN 92.69	5.8 5.7	3+24.3	3+18.4	3+18.4	C64199		3427 S. McComas	3427 S. McComas		3-6-78
	98.3	92.87	5.4	3+98.5	3+77.5	3+77.5	C62900	C64705	3426 S. McComas	3425 S. McComas		11-23-77
					3+53.0	3+77.5	C64178		3426 S. McComas	3425 S. McComas		9-15-77
					3+98.5	3+77.5			3426 S. McComas	3425 S. McComas		11-23-77
LATERAL 44 MAIN 1 SW1												
0+00	85.0	75.34	9.7		0+75 <sup>5</sup>	1+77	61879	C61960	1501 E. 45th St.	4419 Victoria		7-5-77
1+00	84.8	75.58	9.2									7-11-77
2+00	85.5 85.6	75.82 75.84	9.7 9.8	2+05.0								
2+51.5	85.0	75.95	9.1									

Seal off - 99-3922-7- 3/8/79 - Afternooning - 4" clay MH slo, stubbed west - This MH is located in front of bldg