



LATERAL 13 MAIN 16 WAR INDUSTRIES SEWER  
 BUILT BY: SHAWNEE CONST. CO.  
 PROJ. N° DBKL 575080  
 BOOKED 6-27-77 FROM SRL 10

on map

SCALE 1"=150'

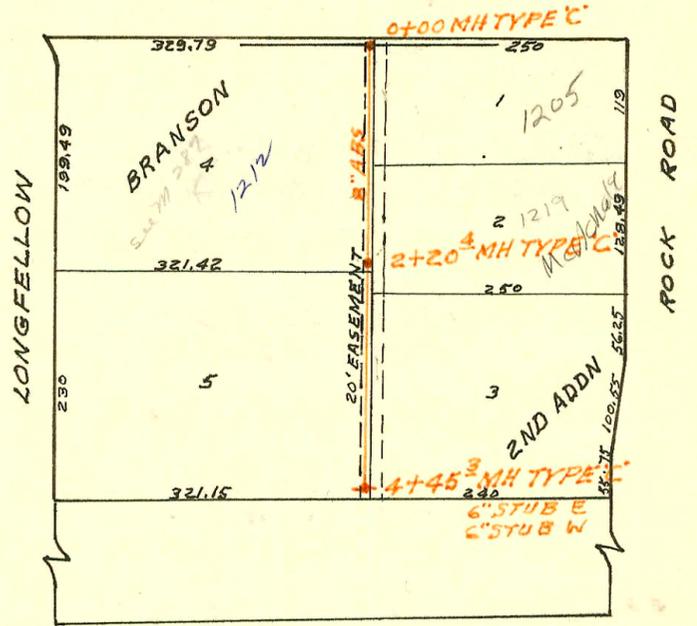

HARRY

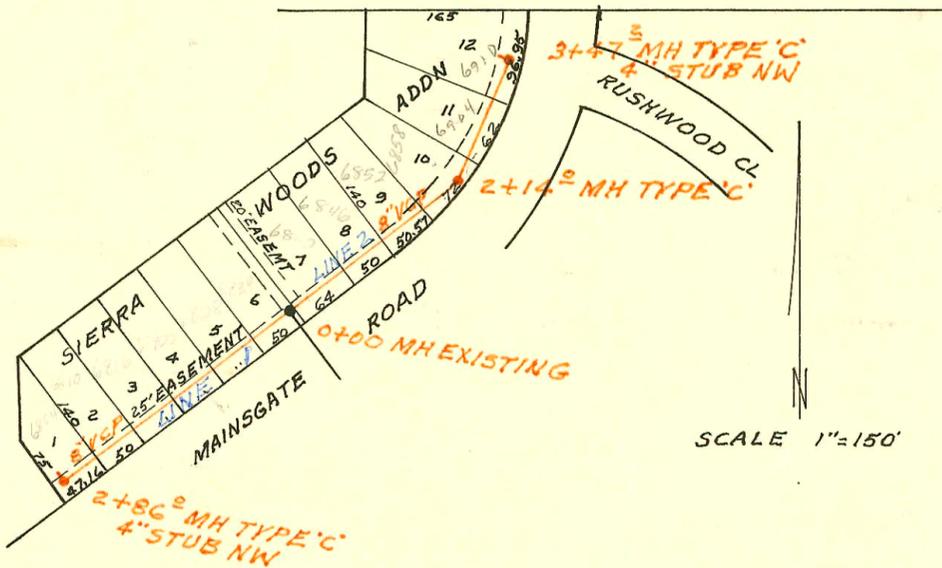

SCALE 1"=150'


LATERAL 9 MAIN 6 SS N°23  
 BUILT BY: MID STATES CONST. CO.  
 PROJ. N° DBKL 576025  
 BOOKED 6-29-77 FROM 1H 92

on map

LATERAL 8 MAIN 23 SS N°22  
 BUILT BY: SHAWNEE CONST. CO.  
 PROJ. N° DBKL 575015  
 BOOKED 6-29-77 FROM 62

on map

SCALE 1"=150'

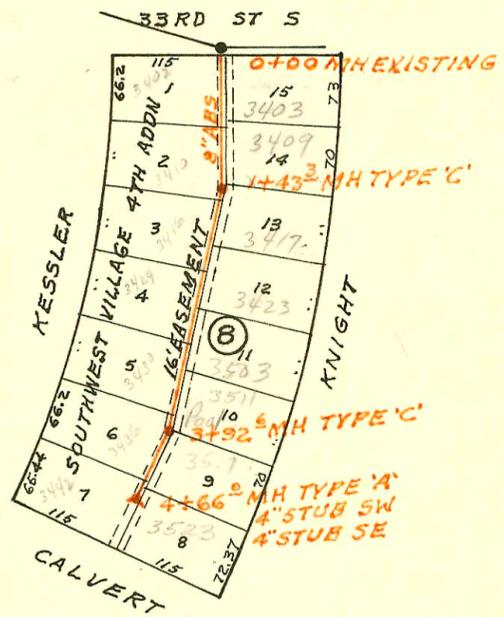

7

CONSTRUCTION RECORD

SERVICE RECORD

| STATION                           | ELEVATION      |                         | Depth             | MANHOLE            | 4-INCH "Y" BRANCHES        |                            | No. of Permit |                            | House Number |  | DATE OF PERMITS   |   |         |
|-----------------------------------|----------------|-------------------------|-------------------|--------------------|----------------------------|----------------------------|---------------|----------------------------|--------------|--|-------------------|---|---------|
|                                   | Ground         | Grade                   |                   |                    | North West                 | South East                 | North West    | South East                 | North West   | South East   | North West        | South East  |         |
|                                   |                |                         |                   |                    |                            |                            |               |                            |              |  |                   |   |         |
| <b>LATERAL 13 MAIN 16 WIS</b>     |                |                         |                   |                    |                            |                            |               |                            |              |  |                   |   |         |
| 0+00                              | 140.5          | 133.12                  | 7.4               | 0+00               |                            | 4" sch 40 pipe<br>0+77.110 |               | 96-4297                    |              | 1205 SNE<br>Rock Rd  |                   | 4-1-96  |         |
| 1+00                              | 141.6          | 133.52                  | 8.1               |                    |                            | 6" sch 40<br>1+59.90       |               | 135-27<br>13272<br>C69836  |              | 1219<br>Rock Rd<br>1219 S<br>Rock Rd   |                   | 4-19-85<br>3-20-85<br>12-15-78                      |         |
| 2+00                              | 143.0<br>143.8 | 133.92<br>134.00        | 9.1<br>9.8        | 2+20.4             |                            | 2+00.6                     |               |                            |              |  |                   |   |         |
| 3+00                              | 145.2          | 134.32                  | 10.9              |                    |                            |                            |               |                            |              |  |                   |   |         |
| 4+00                              | 146.3<br>146.7 | 134.72<br>134.90        | 11.6<br>11.8      | 4+45.3             | 6" STUB W                  | 6" STUB E                  |               | C60223                     |              | 1201 S<br>Rock Rd  |                   | 3-7-77  |         |
| <b>LATERAL 9 MAIN 6 SS N° 23</b>  |                |                         |                   |                    |                            |                            |               |                            |              |  |                   |   |         |
| LIN 1 0+00                        | 196.0          | 186.00                  | 10.0              | 0+00 EXISTING      | TAP<br>0+06                |                            |               | C62257                     |              | 6834<br>Manngate   |                   | 7-26-77   |         |
| 1+00                              | 196.0          | 186.40                  | 9.6               |                    | 0+90.6                     |                            |               | C62256                     |              | 6828<br>Manngate   |                   | 7-26-77   |         |
| 2+00                              | 197.0<br>198.0 | 186.80<br>187.14        | 10.2<br>10.9      | 2+86.0             | 0+98.0<br>1+51.0<br>1+92.0 | 4" STUB NW                 |               | C62255<br>C62254<br>C62253 |              | 6822<br>Manngate<br>6816<br>Manngate<br>6810<br>Manngate<br>6804<br>Manngate |                   | 7-26-77<br>7-26-77<br>7-26-77<br>7-26-77<br>7-26-77 |         |
| LIN 2 0+00                        | 196.0          | 186.00                  | 10.0              | 0+00 = 0+00 LINE 1 | TAP<br>0+22                |                            |               | C62115                     |              | 6840<br>Manngate   |                   | 7-18-77   |         |
| 1+00                              | 196.0          | 186.40                  | 9.6               |                    | 1+08                       |                            |               | C62114                     |              | 6840<br>Manngate   |                   | 7-18-77   |         |
| 2+00                              | 196.5<br>196.6 | 186.80<br>186.96        | 9.7<br>9.6        | 2+14.0             | 1+23.7                     |                            |               | C62113                     |              | 6852<br>Manngate   |                   | 7-18-77   |         |
| 3+00                              | 196.1          | 187.30                  | 8.8               |                    | 2+30.5                     |                            |               | C62112                     |              | 6858<br>Manngate   |                   | 7-18-77   |         |
|                                   | 196.0          | 187.50                  | 8.5               | 3+47.2             | 2+54.6                     | ← stub                     |               | C61667                     |              | 6904<br>Manngate   |                   | 6-17-77   |         |
|                                   |                |                         |                   |                    |                            |                            |               | C61666                     |              | 6910<br>Manngate   |                   | 6-17-77   |         |
| <b>LATERAL 8 MAIN 23 SS N° 22</b> |                |                         |                   |                    |                            |                            |               |                            |              |  |                   |   |         |
| 0+00                              | 99.2           | 90.77                   | 8.4               | 0+00 EXISTING      | 0+51.8                     |                            |               | C61025                     |              | 3402 S.<br>Kessler   |                   | 5-4-77  |         |
| 1+00                              | 99.5<br>99.6   | 91.17<br>91.34<br>91.44 | 8.3<br>8.3<br>8.2 | 1+43.3             | 1+34.0                     |                            |               | C64176                     | C62064       | 3410 S.<br>Kessler   | 3409 S.<br>Knight | 11-23-77  | 7-14-77 |
| 2+00                              | 98.3           | 91.58                   | 6.7               |                    | 2+18.8                     |                            |               | C64363                     | C66950       | 3416 S.<br>Kessler   | 3417 S.<br>Knight | 12-7-77   | 6-20-78 |
| 3+00                              | 98.7           | 91.83                   | 6.9               |                    | 2+60.1                     |                            |               | C68406                     |              | 4423 S.<br>Knight  |                   | 9-18-78   |         |
| 4+00                              | 97.9<br>97.8   | 92.06<br>92.16<br>92.18 | 5.8<br>5.7<br>5.6 | 3+92.6             | 3+03.9<br>3+22.5           |                            |               | C63427                     | C65830       | 3424 S.<br>Kessler   | 3503 S.<br>Knight | 10-18-77  | 4-11-78 |
|                                   |                |                         |                   |                    | 3+21.8                     |                            |               | C65404                     |              | 3511 S.<br>Knight  |                   | 9-18-78   |         |
|                                   |                |                         |                   |                    | 3+21.7                     |                            |               | C68405                     |              | 3517 S.<br>Knight  |                   | 9-18-78   |         |
|                                   |                |                         |                   |                    | 4+46.6                     |                            |               | C64364                     |              | 3426 S.<br>Kessler   |                   | 12-7-77   |         |
|                                   | 98.0           | 92.34                   | 5.7               | 4+66.0             | 4" stub<br>SW              |                            |               | C62901                     | C64706       | 3442 S.<br>Kessler   | 3528 S.<br>Knight | 9-7-77  | 1-3-78  |