



LATERAL 5 MAIN 23 SS N^o 22
BUILT BY: CARTER CONST. CO.
PROJ. N^o DBKL 575012
BOOKED 7-27-77

SCALE 1"=150'

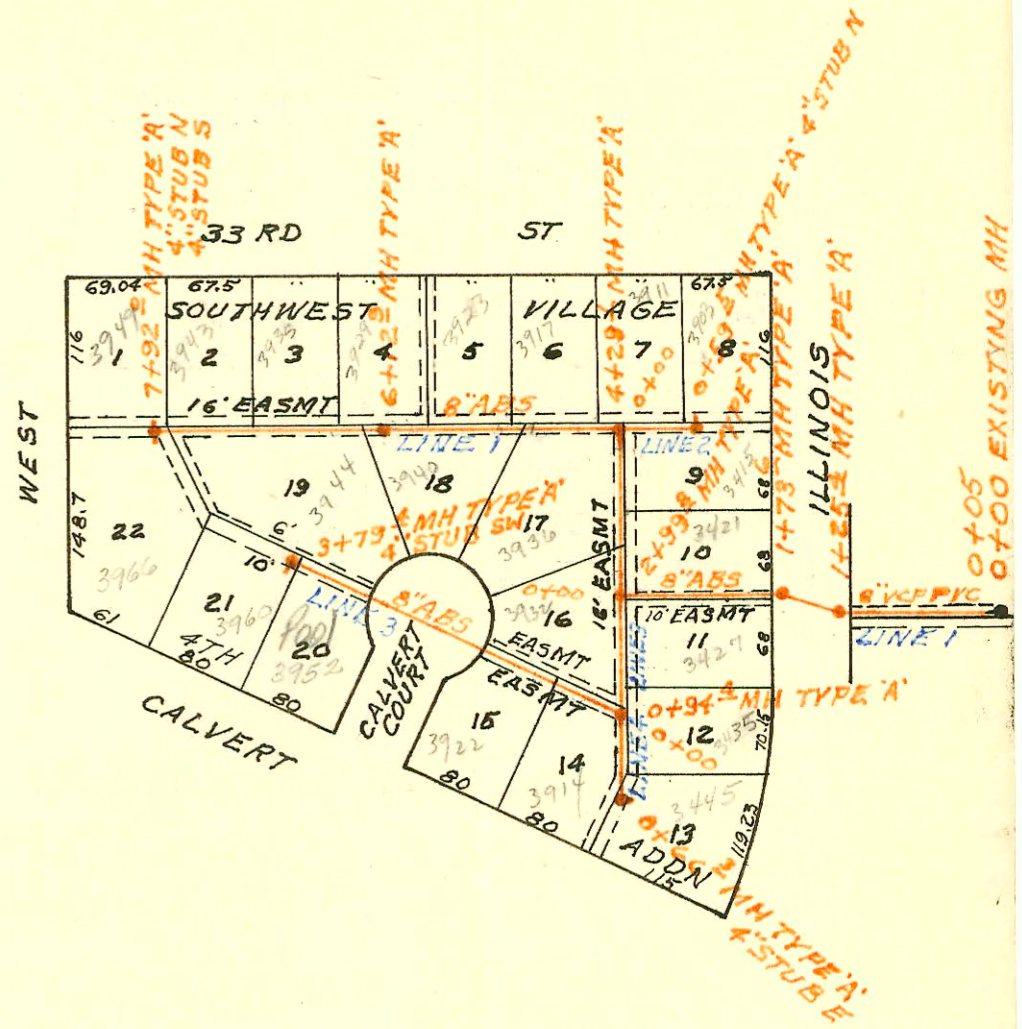

LATERAL 34 MAIN 5 SS N^o 23
BUILT BY: UTILITY CONT. INC.
PROJ. N^o DBKL 577013
BOOKED 7-29-77 FROM 1H 88


SCALE 1"=150'

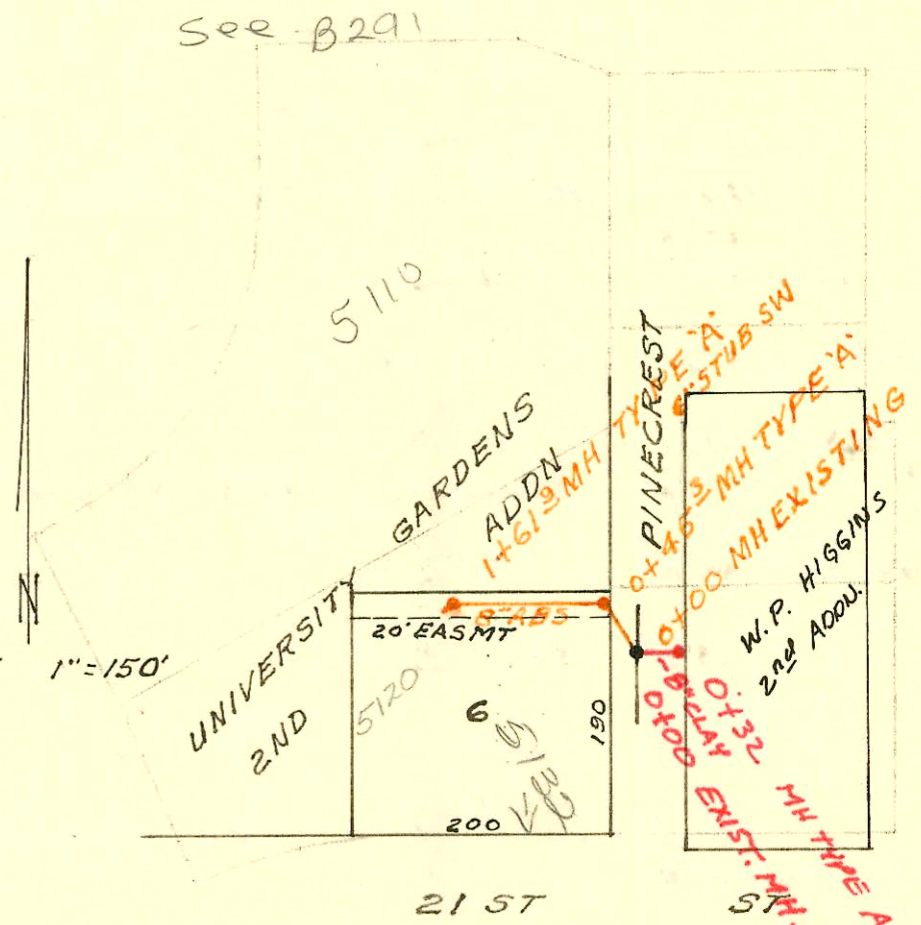

LAT 24, MAIN 5, SS # 23
BOOKED FROM PLAN 1-19-84

LATERAL 6 MAIN 6 SS N^o 23
BUILT BY: SHAWNEE CONST. CO.
PROJ. N^o DBKL 576001
BOOKED 8-1-77 FROM 1H 94
(SEE PAGE M226)

SCALE 1"=150'

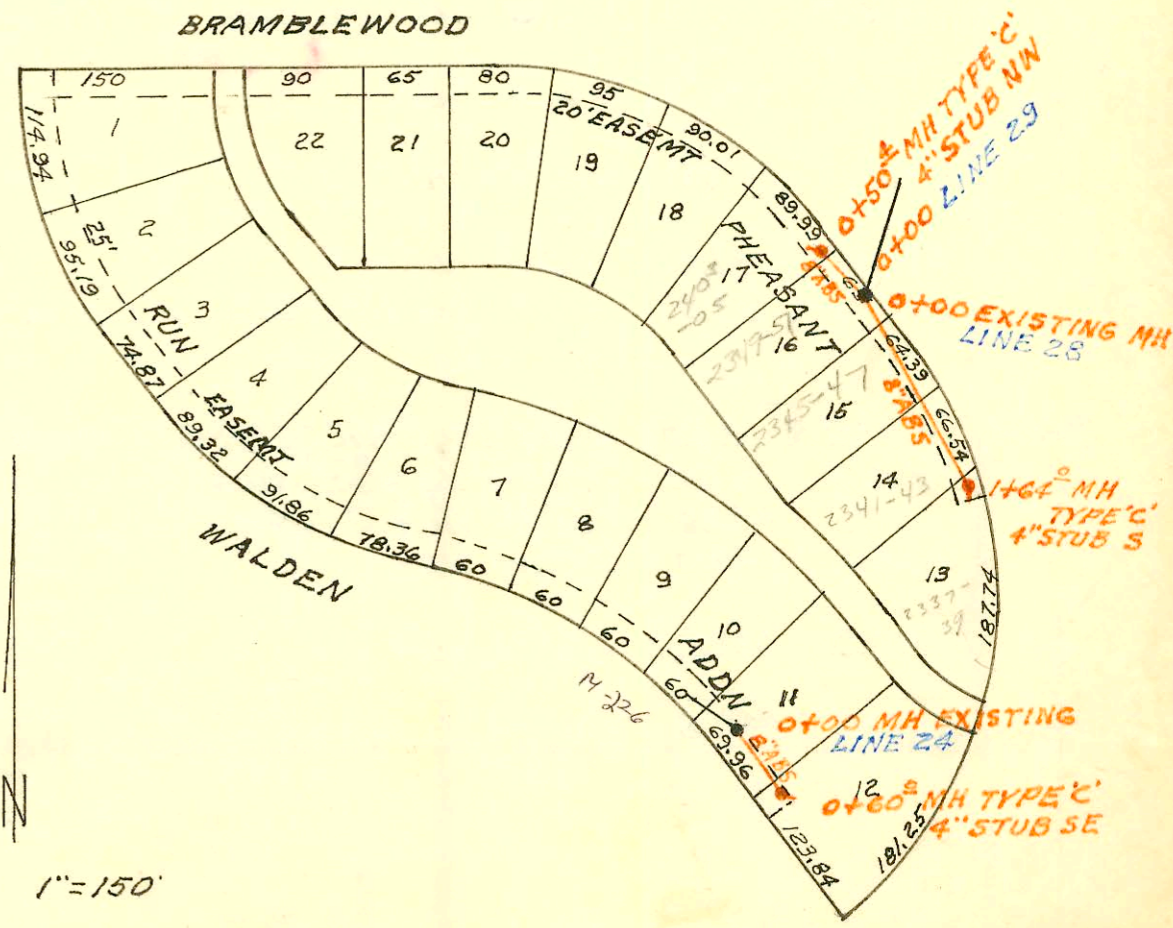

CONSTRUCTION RECORD

SERVICE RECORD

STATION	ELEVATION		Depth	MANHOLE	4-INCH "Y" BRANCHES		No. of Permit		House Number		DATE OF PERMITS	
	Ground	Grade			North West	South East	North West	South East	North West	South East	North West	South East
LATERAL 5 MAIN 23 SS N ^o 22												
LINE 1 0+00	101.2	92.09	9.1	EXISTING	0+47.6		C65839		3421 S. Illinois		4-24-78	
0+05	101.2	92.11	9.1									
1+00	98.7	92.49	6.2									
	99.7	OUT 92.60 IN 92.70	7.7 7.0		1+25.4							
	99.7	OUT 92.82 IN 92.92	6.9 6.8		1+73.6							
2+00	99.0	92.98	6.0									
	99.0	OUT 93.21 IN 93.32	5.8 5.7		2+99.8							
4+00	98.9	93.58	5.3									
	98.8	OUT 93.66 IN 93.76	5.1 5.0		4+29.1	4+40.2	C67898	C63909	3911 W. 33rd St. Calvert of House	8-17-78	9-12-77	
					4+90.3	3+40.8	C67902	POOL 24102	3917 W. 33rd St. Calvert of	8-17-78	10-24-89	
5+00	99.0	93.94	5.1			5+25.9		C62068	3940 Calvert of		7-27-77	
6+00	99.0	94.19	4.8		5+90.6			C67899	3923 W. 33rd St. Calvert of	8-17-78		
	99.0	94.22	4.8		6+12.9	6+28.7		C67900	3929 W. 33rd St. Calvert of	8-17-78		
					7+06.9	6+42.5		C68035	3935 W. 33rd St. Calvert of	8-24-78	7-28-77	
7+00	98.9	94.44	4.5		7+79.9			C67901	3944 Calvert of	8-17-78		
	99.3	94.67	4.6		7+92.0	4"STUB N			3966 Calvert		6-9-77	
LINE 2 0+00	98.8	93.76	5.0	0+00=4+29.1	LINE 1							
	98.8	93.91	4.9		0+59.5	4"STUB N		C61452	3903 W. 33rd St. Calvert of	6-7-77	8-17-78	
LINE 3 0+00	99.0	93.33	5.7	0+00=2+99.8	LINE 1							
	98.8	OUT 93.57 IN 93.67	5.2 5.1		0+94.4			C65848	3427 S. Illinois		4-11-78	
1+00	98.8	93.68	5.1		1+45.7	1+09.8		C62067	3982 Calvert of	7-22-77	7-28-77	
						1+62.6			3914 Calvert of		6-10-77	
2+00	99.0	93.93	5.1						3922 Calvert			
3+00	99.2	94.18	5.0			3+68.1			3952 Calvert		6-10-77	
	98.9	94.38	4.5		3+79.4	4"STUB SW		C62066	3960 Calvert	7-14-77		
LINE 4 0+00	98.8	93.67	5.1	0+00=0+94.4	LINE 3							
	99.0	93.84	5.2		0+66.3	4"STUB E		C67907	3435 S. Illinois		8-17-78	
LATERAL 34 MAIN 5 SS N ^o 23												
0+00	217.2	208.36	8.8	EXISTING	0+45.3							
	216.5	OUT 208.63 IN 208.73	7.9 7.8									
1+00	214.8	209.06	5.7		1+07.3			C62578	5110 N. E 21st	10-22-93		
	213.7	209.43	4.3		1+61.9	6"STUB SW		C62560	5120 S. 21st St.	8-15-77	7-14-77	
LATERAL 6 MAIN 6 SS N ^o 23												
LINE 28 0+00	204.5	195.03	9.5	EXISTING								
1+00	205.8	195.43	10.4		0+65.0			C64128	3345-47 Franklinwood		11-21-77	
					1+29.0			C64129	3347-43 Franklinwood		11-21-77	
	206.6	195.69	10.9		1+64.0	4"STUB S		C64130	3357-39 Franklinwood		11-21-77	
LINE 29 0+00	204.5	195.03	9.5	EXISTING								
					0+15			C64127	3349-51 Franklinwood		11-21-77	
	203.4	195.23	8.2		0+50.4	4"STUB NW		C63380	3353-35 Franklinwood		11-4-77	
LINE 24 0+00	204.5	194.14	10.4	EXISTING								
	205.0	194.38	10.6		0+60.0	4"STUB SE		C62998	2333-34 Walden		9-12-77	
LAT 24 MAIN 5 SS N ^o 23												
0+00	218.8	209.86	8.9									
	219.0	210.18	8.8		0+32							