

0+00 MHEX157M
C255A

1+94' MH TYPE 'C'

4+00' MH TYPE 'C' 8\"/>

6+19' MH TYPE 'C' 8\"/>

7+08' MH TYPE 'C' 8\"/>

8+28' MH TYPE 'C' 8\"/>

11+31' MH TYPE 'C' 8\"/>

14+50' MH TYPE 'C' 8\"/>

17+78' MH TYPE 'C' 8\"/>

19+32' MH TYPE 'C' 8\"/>

19+84' MH TYPE 'C' 8\"/>


3+00' MH TYPE 'A' 4\"/>

50+50' MH TYPE 'A'

PLANEVIEW ELEMENTARY SCHOOL SAN SEWER
BUILT BY: PRIVATE
PROJ. N^o DBKW 707012
BOOKED 8-10 -77 FROM SRL 12

LATERAL 71 SOUTHWEST INTERCEPTOR
BUILT BY: W B CARTER CONST. CO.
PROJ. N^o DBKL 575004
BOOKED 8-2-77 FROM CLG 08

SAN SEWER LOT 1 BLOCK 3 FARMINGTON SQUARE ADDN
BUILT BY: MID STATES CONST. CO.
PROJ. N^o 468-76-245-80746-000-000-008
BOOKED 10-9-81 FROM BR18

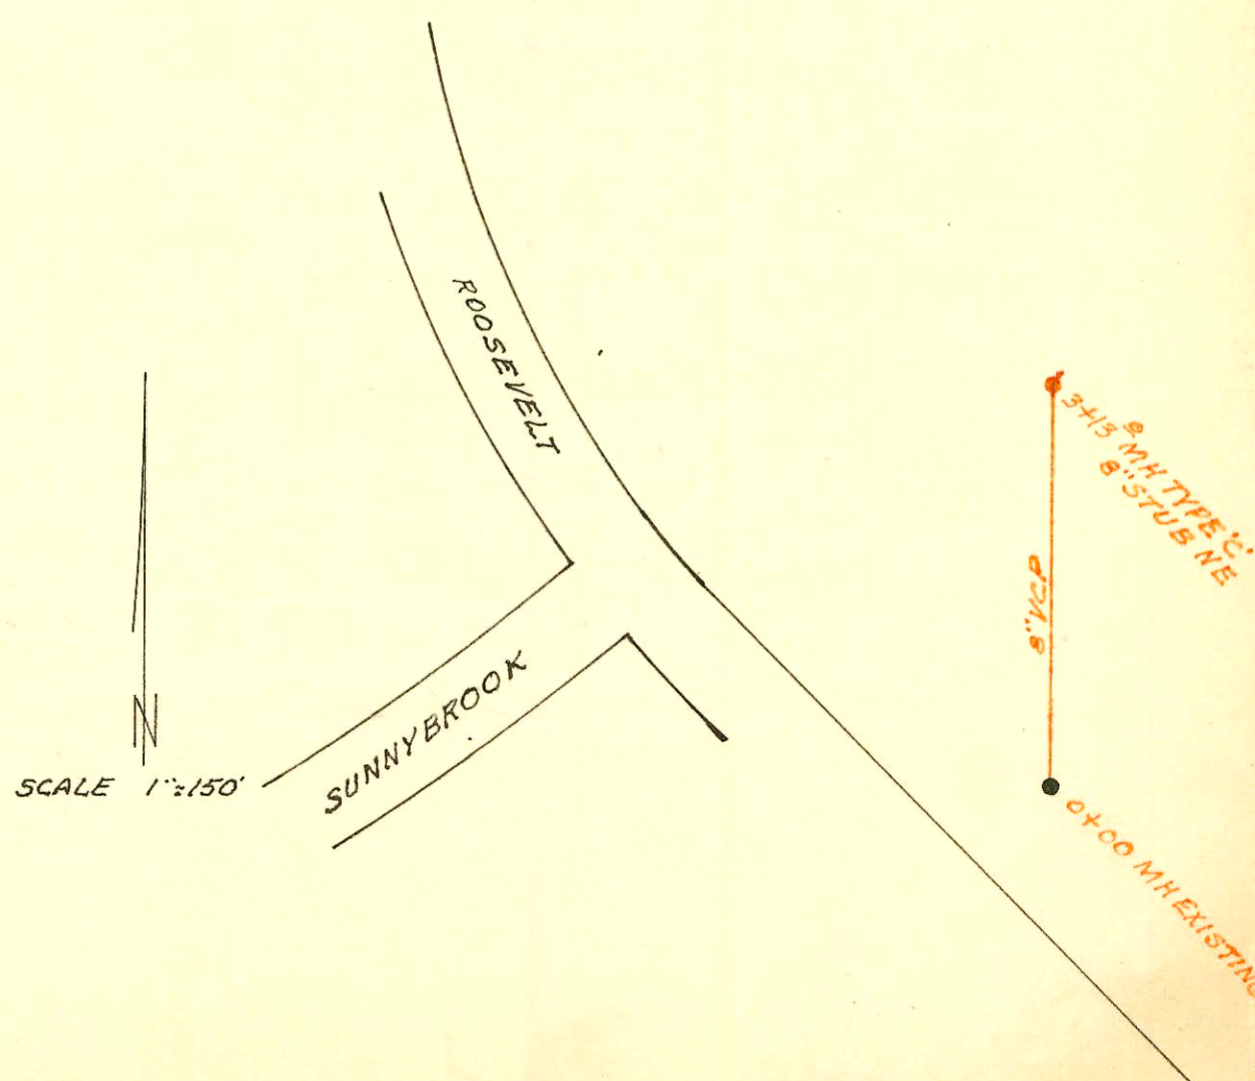

5+15' MH TYPE 'C' 8\"/>

8\"/>

0+00 MHEX157M

SCALE 1\"/>

SUNNYBROOK

ROOSEVELT

SCALE 1\"/>

CONSTRUCTION RECORD

SERVICE RECORD

STATION	ELEVATION		Depth	MANHOLE	4-INCH "Y" BRANCHES		No. of Permit		House Number		DATE OF PERMITS	
	Ground	Grade			North West	South East	North West	South East	North West	South East	North West	South East
LATERAL 71 SOUTHWEST INTERCEPTOR												
0+00	124.3	114.33	10.0	0+00 EXISTING								
1+00	124.5	114.96	9.5									
2+00	126.8	115.56	11.2	1+94.0								
	126.8	115.66	11.1									
3+00	126.2	116.27	9.9									
5+00	128.2	116.86	11.3	4+00.2	8" STUB NW							
	129.2	117.44	11.8									
6+00	131.7	118.02	13.7	6+19.0	8" STUB NW							
	129.9	118.13	11.8									
7+00	133.5	119.48	14.0	7+08.9	8" STUB NW							
	130.9	119.61	11.3									
8+00	134.5	121.17	13.3	8+28.1	8" STUB NW	8" STUB SE						
	132.6	121.62	11.0									
9+00	135.9	122.87	13.0									
10+00	137.4	124.47	12.9									
11+00	138.9	126.07	12.8	11+31.3	8" STUB W							
	137.4	126.57	10.8									
12+00	140.3	127.05	13.3									
13+00	141.0	127.45	13.6									
14+00	143.0	127.85	15.2	14+50.1	8" STUB NW							
	142.6	128.05	14.6									
15+00	145.0	128.25	16.8									
16+00	145.6	128.65	17.0									
17+00	145.3	129.05	16.3									
18+00	146.2	129.36	16.8	17+78.2	8" STUB N							
	145.5	129.46	16.7									
19+00	146.9	129.95	17.0	19+32.5	8" STUB N							
	147.3	130.08	17.2									
	147.3	134.08	13.2	19+84.8	8" STUB W	8" STUB S						
PLANEVIEW ELEMENTARY SCHOOL SAN SEWER												
0+00	120.9	114.6	6.3	0+00 EXISTING								
1+00	125.3	116.6	8.7									
2+00	130.8	118.7	12.1									
3+00	131.0	120.7	10.3	3+13.0	8" STUB NE							
	131.3	121.0	10.3									
SAN SEWER LOT 1 BLK 3 FARMINGTON SQUARE ADDN												
0+00	147.3	134.74	12.3	0+00 EXISTING								
1+00	147.6	134.80	12.8	0+14.8								
	148.0	134.90	12.7									
2+00	149.0	135.64	13.4									
3+00	149.8	136.04	13.8	3+00.8	4" Stub W	6" Stub SW	C67993	C67995	7101 1	Shade	7101 2+3	8-23-78

C67991 - 7101 shade Bldg 5 Drain Deflex 8-23-78 - used 8" stub S. out of MN & Per. Walker

C67998 7101 6+7 8-23-78
 C67997 Shade 7101 4 8-23-78
 C67996 7101 2+3 8-23-78
 C67994 Shade 7101 2+3 8-23-78
 C67995 7101 2+3 8-23-78