



QUAIL MEADOWS APTS PH II SAN SEWER
 BUILT BY: UTILITY CONTR. INC.
 PROJ. N^o DBKW 707015
 BOOKED 8-11-77 FROM SRL 5

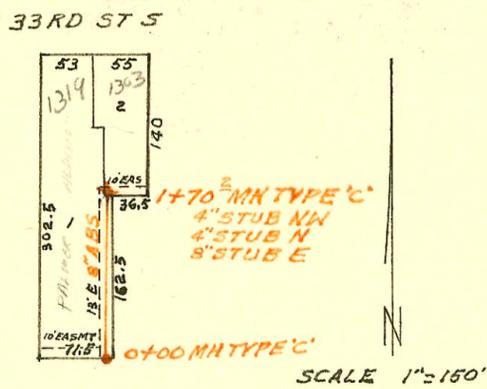

LATERAL 46 MAIN 2 SS N^o 22
 BUILT BY: SHAWNEE CONST. CO.
 PROJ. N^o DBKL 576052
 BOOKED 8-15-77 FROM CLG 05

Priv. S.S. for Lot 1, Blk B, South Seneca Gardens 4th Addn.
 #B. 76-245-80001-000-000-039
 Built By W. B. Carter
 Booked 11-13-85 From LES 19

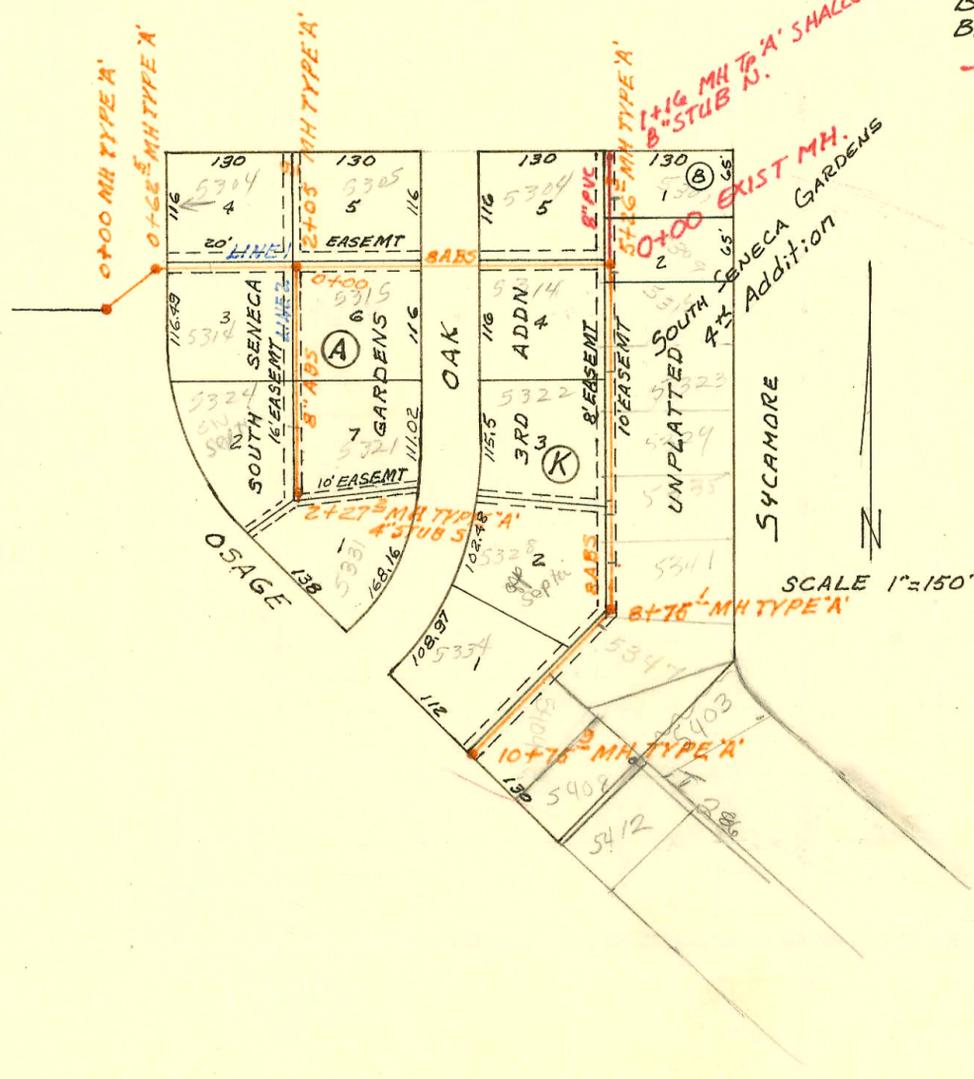

LATERAL 20 MAIN 3 SOUTHWEST INTERCEPTOR
 BUILT BY: EARTH EXCAVATING CO.
 PROJ. N^o DBKL 576056
 BOOKED 8-16-77 FROM LES 8

CONSTRUCTION RECORD

SERVICE RECORD

STATION	ELEVATION		Depth	MANHOLE	4-INCH "Y" BRANCHES		No. of Permit		House Number		DATE OF PERMITS			
	Ground	Grade			North West	South East	North West	South East	North West	South East	North West	South East	North West	South East
QUAIL MEADOWS APTS PHASE II SAN SEWER														
LINE 1 0+00	168.5	161.57	0+00		0+77.6	0+89.6	C61503	C61502	9100 S. Harry Bldg	9100 S. Harry Bldg	6-9-77	6-9-77		
1+00	168.9	162.59												
2+00	169.0	163.61												
	170.8	OUT 163.94 IN 164.10		2+31.9		2+43.9		C61501		9100 S. Harry Bldg		6-9-77		
3+00	171.0	164.38		2+90.2	6" STUB NE									
				3+90.2	6" STUB NE									
LINE 2 0+00	173.5	164.15	9.4	0+00 EXISTING	0+67.2					9100 S. Harry Bldg		6-15-77		
1+00	173.1	164.55	8.6											
	172.2	OUT 164.59 IN 164.79	7.6 7.4	1+10.1										
2+00	172.7	165.15	7.6			1+86.1		C61583		9100 S. Harry Bldg		10-5-77		
	172.0	OUT 165.31 IN 165.51	6.7 6.5	2+41.0		1+93.7		C61582		9100 S. Harry Bldg		10-5-77		
3+00	171.3	165.75	5.6											
	170.2	165.99	4.2	3+62.0	6" STUB N 4" STUB W									
LATERAL 46 MAIN 2 S S N ^o 22														
0+00	93.3	84.42												
1+00	93.2	84.62												
	93.3	84.76	9.5	1+70.2	4" STUB N 4" STUB NW 8" STUB E									
LATERAL 20 MAIN 3 SOUTHWEST INTERCEPTOR														
LINE 1 0+00	82.0	77.15	4.9	0+00										
	82.6	OUT 77.21 IN 77.26	5.4 5.3	0+62.5										
1+00	82.6	77.30	5.3		1+17.5			2561	5304 S. Osage		2-5-81			
2+00	82.3	77.40	4.9											
	82.3	77.40	4.9	2+05.9					5305 S. Oak		6-7-77			
3+00	82.5	77.50	5.0											
4+00	82.1	77.59	4.5						5304 S. Oak		6-7-77			
5+00	82.2	77.69	4.5											
	82.5	OUT 77.72 IN 77.76	4.8 4.7	5+26.3		5+30.3		14907	5309 S. Sycamore		10-28-85			
6+00	82.3	77.84	4.5											
7+00	82.1	77.94	4.2											
				6+36.9	6" STUB N 4" STUB W	6+37.3		C62953	13744 13745	5314 S. Oak	5323 Sycamore	9-15-77	5-13-85	
8+00	82.0	78.04	4.0											
	82.0	78.12 78.17	3.9 3.8	8+75.1		8+75.1		C63129	14776 13746	5322 S. Oak	5325 Sycamore	9-20-77	5-13-85	
9+00	81.7	78.19	3.5			8+91.1			10272	5347 Sycamore		2-23-84		
10+00	81.4	78.29	3.1			10+29.6								
	81.5	78.37	3.1	10+75.9				C70505	7721	5334 S. OAK	5307 S. Osage	3-7-79	3-21-83	
LINE 2 0+00	82.3	77.50	4.8	0+00=2+05.9										
1+00	82.5	77.70	4.8											
				0+71.4				1125	5314 S. Osage			9-2-80		
2+00	82.8	77.90	4.9											
	82.7	77.95	4.6	2+27.2	4" STUB S				5324 S. Osage	5321 S. Oak	3-14-99	9-15-77		
Priv. S.S. Lot 1, Blk B, South Seneca Gardens 4 th Addn.														
0+00	82.44	77.65	4.8											
				0+75.0										
1+00	82.8	77.95	4.9											
	83.4	78.00	5.4	1+16.0	8" STUB N				14910	5301 Sycamore		10-28-85		

do not know date of com but water Dept can furnish bill for sewer 7/18/89

1363
w33ad
1219
w33ad