



LATERAL 19 MAIN 3 SOUTHWEST INTERCEPTOR
 BUILT BY: EARTH EXCAVATION INC.
 PROJ. NO DBKL 576054
 BOOKED 8-19-77 FROM CG 15

SCALE 1"=150'

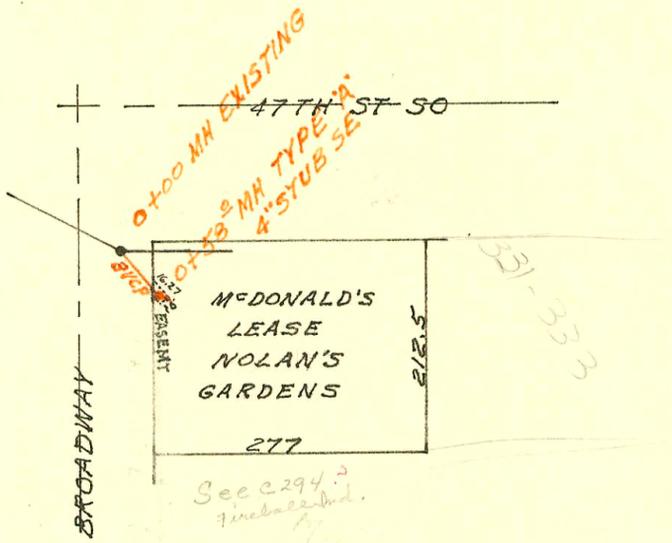


SAN SEWER - MCDONALD'S LEASE
 IN NOLAN'S GARDENS
 BUILT BY: W.B. CARTER CONST. CO.
 PROJ. NO DBKW 707028
 BOOKED 8-29-77 FROM G 2

SCALE 1"=150'

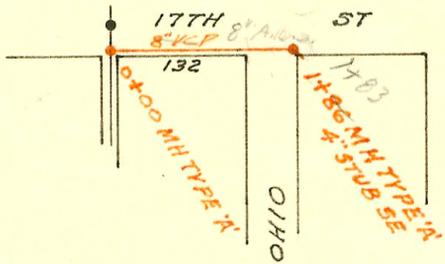

SAN SEWER FOR McADAMS PARK
 BUILT BY: PARK BOARD
 PROJ. NO (PARK BOARD) WMPK 542110
 BOOKED 8-31-77 FROM PLAN

SCALE 1"=150'

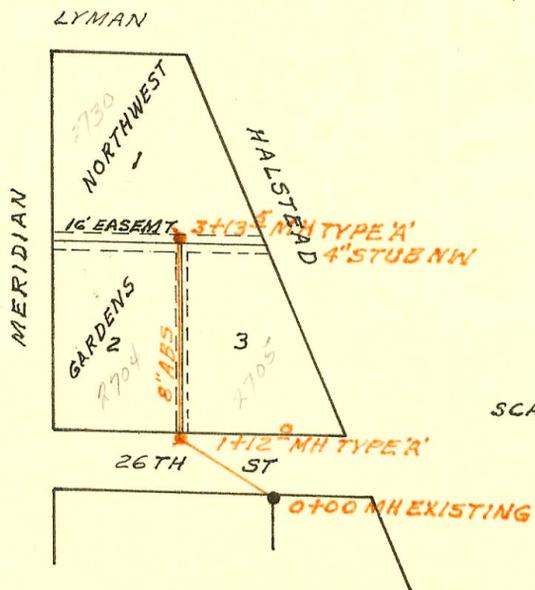

LATERAL 136 SAN SEWER NO 22
 BUILT BY: W.B. CARTER CONST. CO.
 PROJ. NO DBKL 577021
 BOOKED 9-13-77 FROM LES 7

SCALE 1"=150'

