



LATERAL 23 MAIN 4 SOUTHWEST INTERCEPTOR  
 BUILT BY: UTILITY CONTR. INC.  
 PROJ. N<sup>o</sup> DBKL 576017  
 BOOKED 9-21-77 FROM LES 10

SCALE 1" = 150'

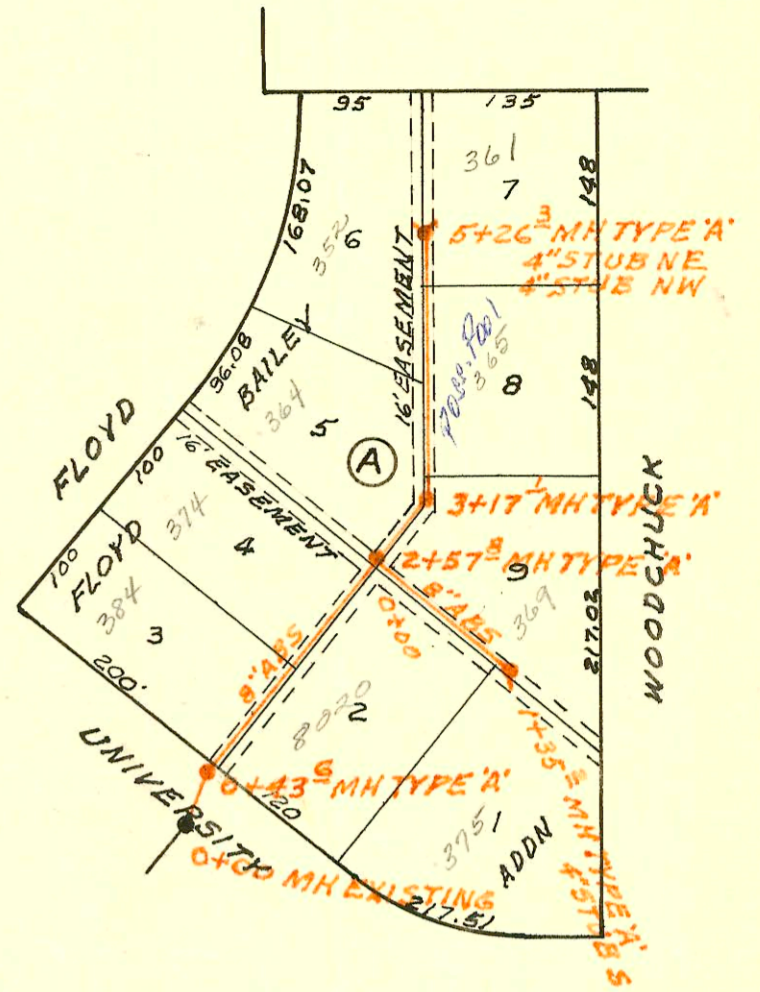


OLIVER

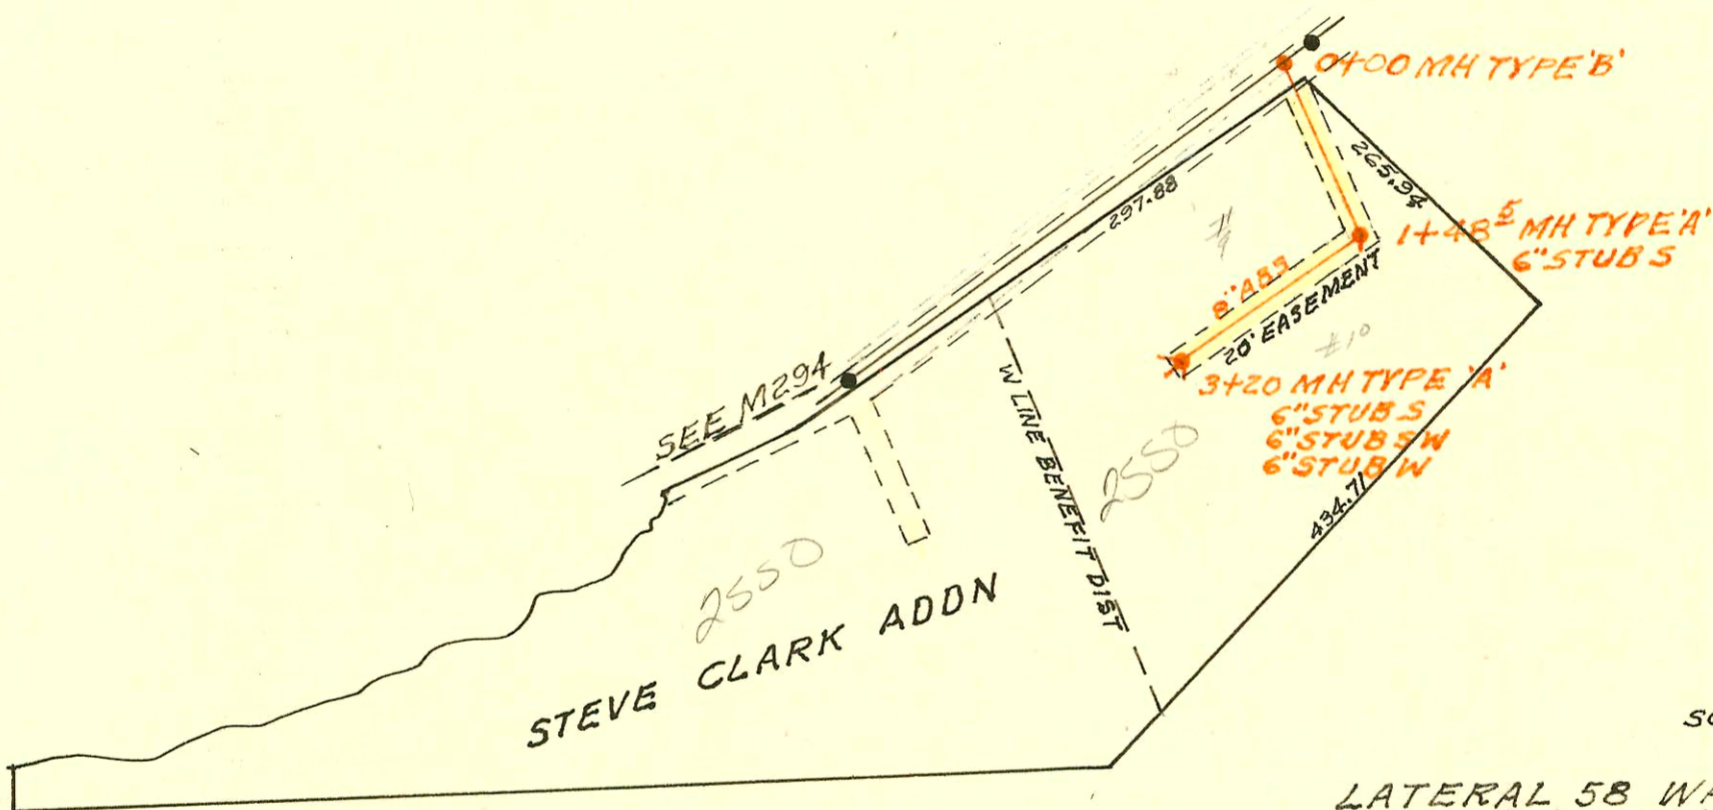

SCALE 1" = 150'

LATERAL 58 WAR INDUSTRIES SEWER  
 BUILT BY: UTILITY CONTR. INC.  
 PROJ. N<sup>o</sup> DBKL 577019  
 BOOKED 10-4-77 FROM SRL 10

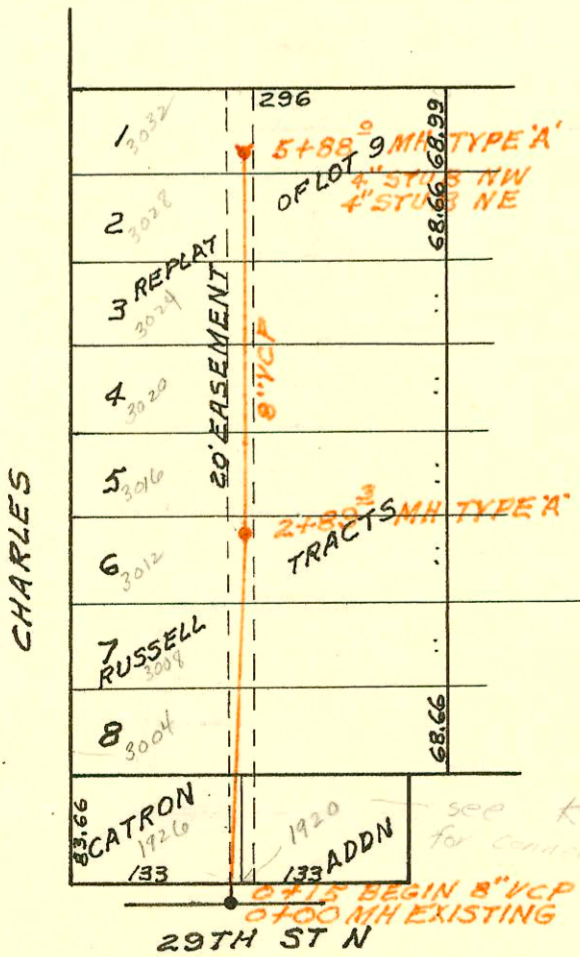

SCALE 1" = 150'

LATERAL 56 MAIN 17 S S N<sup>o</sup> 22  
 BUILT BY: MID STATES CONST. CO.  
 PROJ. N<sup>o</sup> DBKL 572027  
 BOOKED 10-21-77 FROM LES 11

1920 ADDN  
 0+15 BEGIN 8" VCP for 1920  
 0+00 MH EXISTING  
 see K-88 for connection info. 11/26

CONSTRUCTION RECORD

SERVICE RECORD

STATION	ELEVATION		Depth	MANHOLE	4-INCH "Y" BRANCHES		No. of Permit		House Number		DATE OF PERMITS	
	Ground	Grade			North West	South East	North West	South East	North West	South East	North West	South East
<b>LATERAL 63 WESTLINK CONT</b>												
	152.7	145.90	6.8	1+11.6	MH Top (1318)	4" STUB S (1324)	C64972	C67270	1316	1324	12-27-78	7-10-78
LINE 3 0+00	155.6	148.09	7.5	0+00=11+50.8	LINE 1	Top 0+76.1	C672018	C670460	1333	7910W	5-29-79	3-6-79
		155.1	148.35	6.8								
1+00	155.0	148.50	6.5			Top 1+44.3		C68450		1311		7-20-78
2+00	154.2	148.80	5.4	2+05.9	4" stub N	Top 2+80	C67947	C66029	1323	1315	8-21-78	4-21-78
		154.1	148.82									
<b>LATERAL 23 MAIN 4 SOUTHWEST INTERCEPTOR</b>												
LINE 1 0+00	139.7	133.38	6.3	0+00 EXISTING								
1+00	139.5	133.52	6.0	0+43.6		0+99.9	C62889		364		9-21-77	
	139.5	133.68	5.8			1+71.1	C62888		374		9-28-77	
2+00	139.5	133.98	5.5					C62885	3020	University		7-23-77
3+00	139.6	134.16	5.4	2+57.8								
	139.6	134.28	5.3			3+06.1	C62887		364		9-20-77	
	OUT 134.33		5.3									
	IN 134.43		5.2	3+17.1								
4+00	139.8	134.68	5.1			3+85.8	C62884		365	Woodchuck		9-8-77
5+00	139.7	134.98	4.7			Top 5+14.8						
	139.7	135.05	4.7	5+26.3			C62886	C62885	352	Woodchuck	9-8-77	4-17-78
<b>LINE 2 0+00</b>												
	139.6	134.26	5.3	0+00=2+57.8	LINE 1							
1+00	139.5	134.56	4.9			1+14.4	C63122		369	Woodchuck	9-20-77	
	139.6	134.66	4.9	1+35.2				C63123	375	Woodchuck		9-21-77
<b>LATERAL 58 WAR INDUSTRIES SEWER</b>												
0+00	120.7	111.82	8.9	0+00								
1+00	122.3	112.42	9.9			0+80.1	C62842	C62845	2550	Oliver	9-6-77	7-6-77
	121.2	114.71	6.5	1+48.5								
2+00	122.2	115.02	7.2			2+16	C62843		2551	Oliver		7-2-77
								C62845				
3+00	124.3	115.62	8.7				C62844		2550	Oliver		9-2-77
	124.6	115.74	8.9	3+20			C62847		2550	Oliver		9-2-77
							C62846					9-2-77
<b>LATERAL 56 MAIN 17 SAN SEWER N<sup>o</sup> 22</b>												
0+00	128.1	117.82	10.3	0+00 EXISTING								
0+15	128.4					1+33	C66336		3004	Charles	5-10-78	
1+00	129.5	118.58	10.9									
2+00	130.1	119.34	10.8			1+95	13712		3008	Charles	5-6-85	
	130.0	120.01	10.0	2+89.3								
3+00	130.0	120.07	9.9			2+55	C63344		3012	Charles	10-4-77	
						3+42	537		3016	Charles	6-11-80	
						3+95	C63343		3020	Charles	10-4-77	
4+00	130.0	120.72	9.3									
5+00	130.3	121.37	8.9			4+70	4328		3024	Charles	10-12-81	
						5+56	C75359		3026	Charles	11/15/79	
	130.2	121.96	8.2	5+88.0			C6589		3022	Charles	4/3/78	

#91-39884-7 2550 S. Oliver - (Laundromat for house) #10 - 11/19/91 - 2' outside foundation - 4" Cup - 4" ABS