


LATERAL 17 MAIN 3 SOUTHWEST INTERCEPTOR
 BUILT BY: UTILITY CONTR. INC.
 PROJ. NO DBKL 576030
 BOOKED 10-11-77 FROM CG16
 ON MAP



LATERAL 222 MAIN 5 SS NO 12
 BUILT BY: EARTH EXCAVATION CO.
 PROJ. NO DBKL 576059
 BOOKED 10-24-77

2001-03266-835 W 51st St- 1026601- Seneca Const- 4" SCH 40, 17WINGO, Partial Replacement (Replace 30'@house)

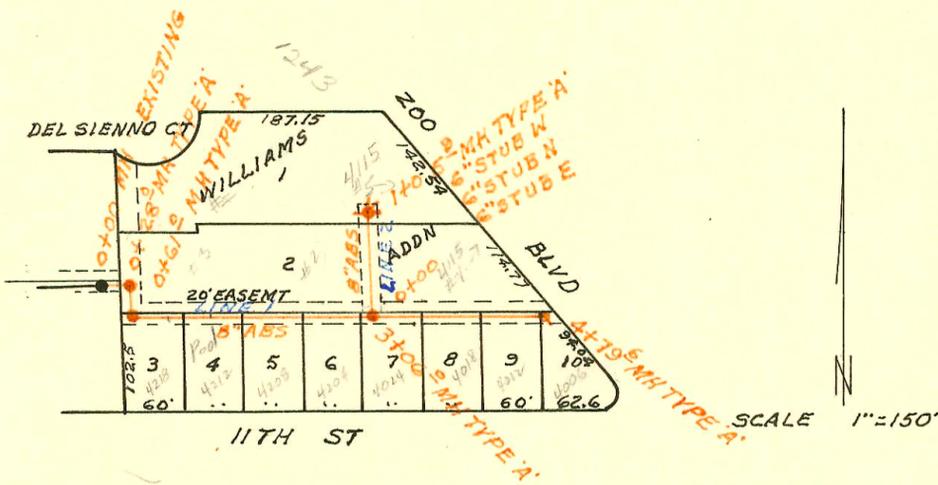