



LOT 1 BLK 6 QUAIL MEADOWS 2ND ADDN SS  
 BUILT BY:  
 PROJ. N<sup>o</sup> DBKW 705068  
 BOOKED 10-25-77 FROM SRL 9

SCALE 1"=150'

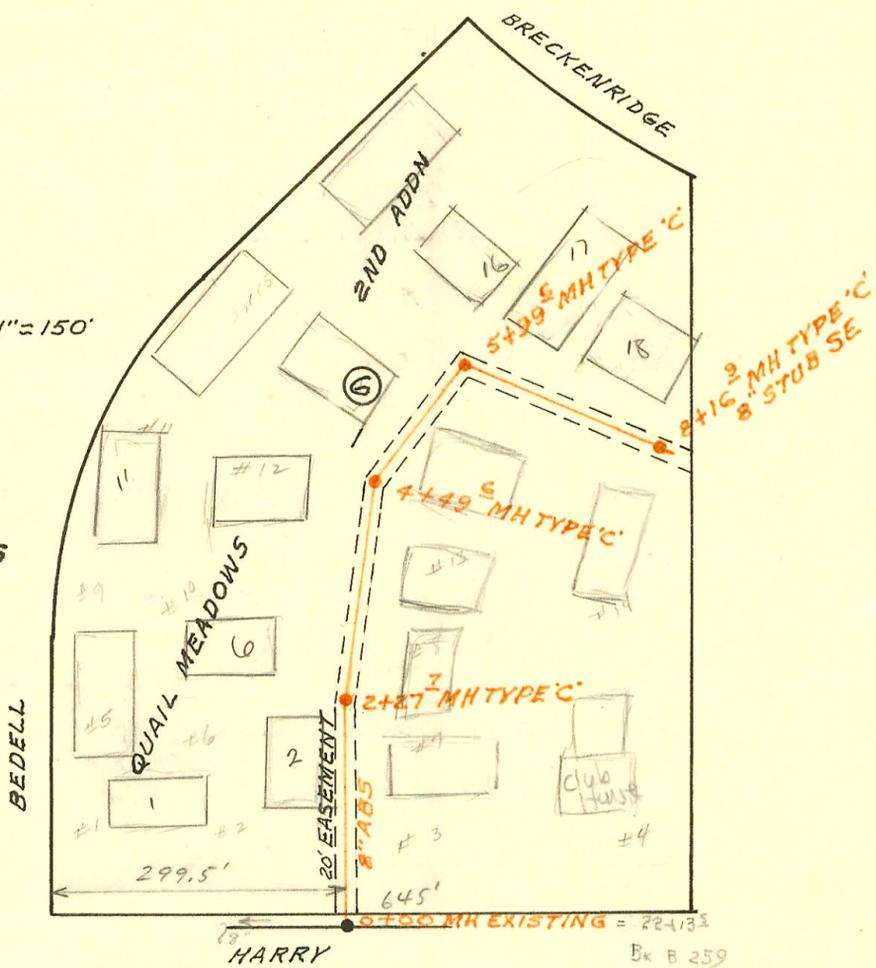

LOT 1 P&L ADDN SAN SEWER  
 BUILT BY: W.B. CARTER CONST. CO.  
 PROJ. N<sup>o</sup> DBKW 707019  
 BOOKED 10-28-77 FROM SRL 8

SCALE 1"=150'

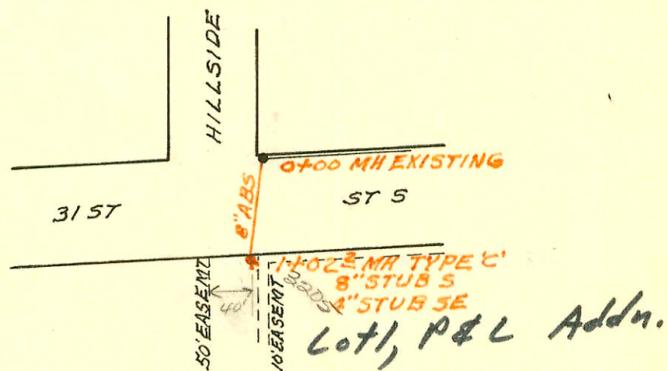

LATERAL 135 SAN SEWER N<sup>o</sup> 22  
 BUILT BY: MID STATES CONST. CO.  
 PROJ. N<sup>o</sup> DBKL 577020  
 BOOKED 11-2-77 FROM CG18A

SCALE 1"=150'

