


LOT 37 KNIGHT ACRES SAN SEWER
 BUILT BY: UTILITY CONTR. INC.
 PROJ. N^o DBKW 707010
 BOOKED 11-3-77 FROM G2



Confirmed by Sewer Maint
 12-8-92 that there is only
 8" stub S with m connection
 except to 4" stub W. West
 and 4" NW 435 N West
 BEI 2-8-92

SCALE 1"=150'

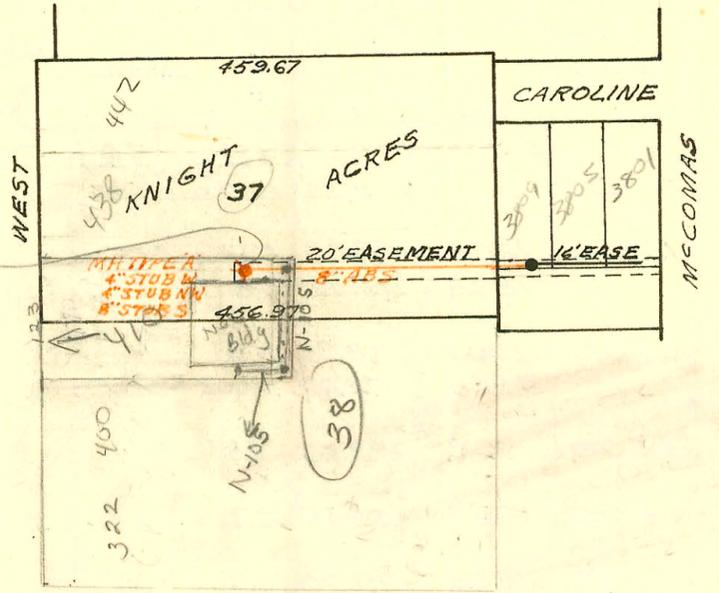

LATERAL 92 MAIN 4 SS N^o 23
 BUILT BY: UTILITY CONTR INC
 PROJ. N^o DBKL577059
 BOOKED 11-10-77 FROM 1H 79


SCALE 1"=150'

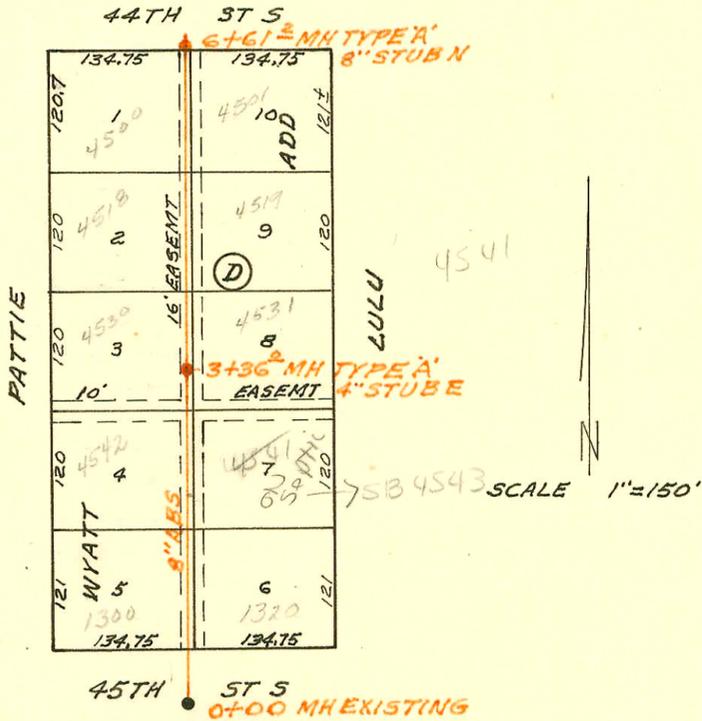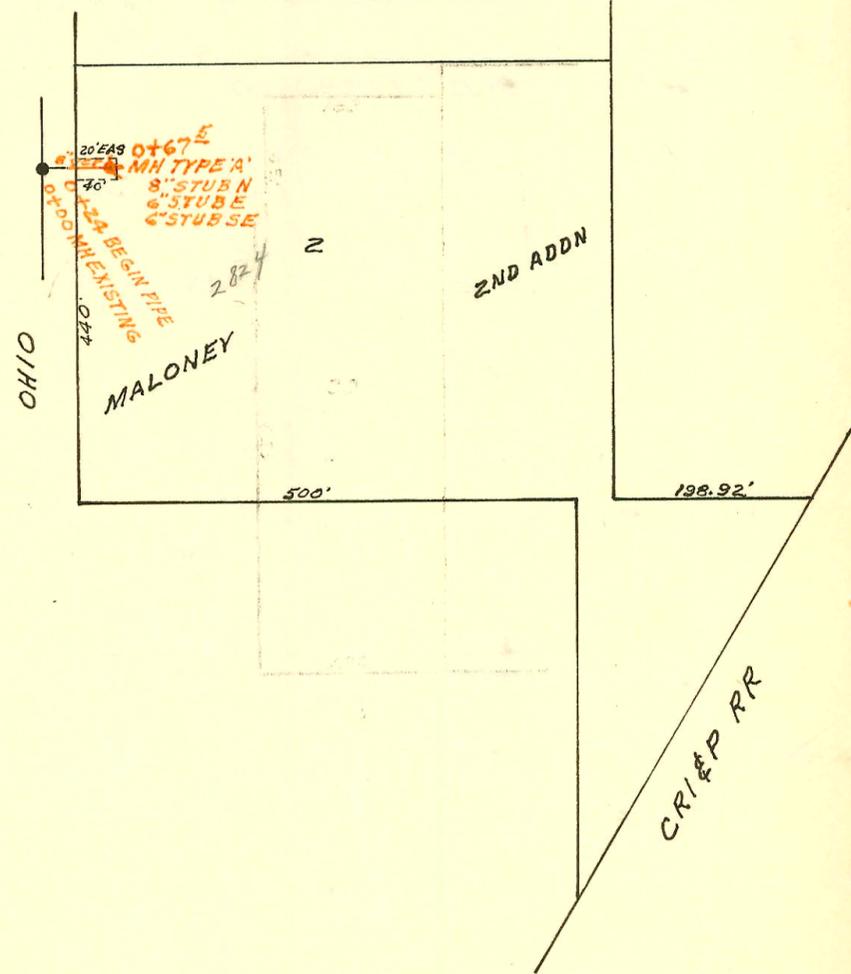

LATERAL 27 MAIN 1 SOUTHWEST INTERCEPTOR
 BUILT BY: UTILITY CONTR. INC.
 PROJ. N^o DBKL571022
 BOOKED 11-15-77 FROM SRL 5A

LATERAL 224 MAIN 5 SS N^o 22
 BUILT BY: UTILITY CONTR. INC.
 PROJ. N^o DBKL577009
 BOOKED 11-29-77 FROM LES 7

SCALE 1"=150'

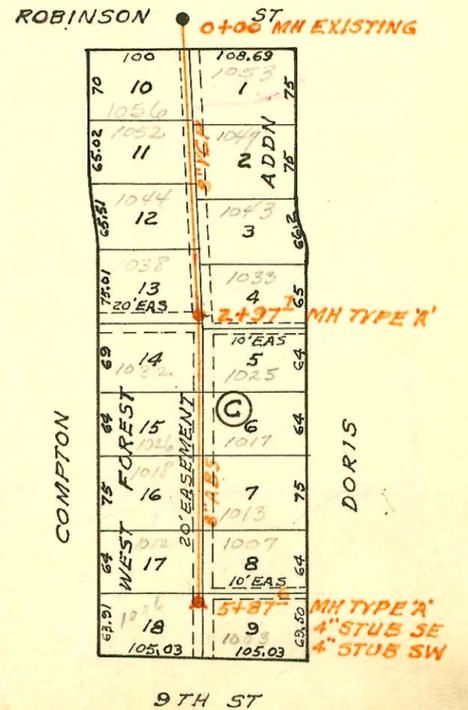

9TH ST

CONSTRUCTION RECORD

SERVICE RECORD

STATION	ELEVATION		Depth	MANHOLE	4-INCH "Y" BRANCHES		No. of Permit		House Number		DATE OF PERMITS	
	Ground	Grade			North West	South East	North West	South East	North West	South East	North West	South East
LOT 37 KNIGHT ACRES SAN SEWER												
0+00	119.8	112.90	6.9	EXISTING								
1+00	120.5	113.10	7.4									
2+00	120.5	113.30	7.2									
	120.4	113.47	6.9	2+85.5	4" STUB N 4" STUB NW 8" STUB S							
LATERAL 92 MAIN 4 SAN SEWER N°23												
0+00	123.8	119.16	4.6	EXISTING								
0+24	125.0	119.79	5.2									
	124.9	119.96	4.9	0+67.5	8" STUB N 6" STUB E							
LATERAL 27 MAIN 1 SOUTHWEST INTERCEPTOR SEWER												
0+00	86.1	76.07	10.0	EXISTING	4" riser 4" riser							
					0+84 W 0+90 E							
1+00	86.7	76.25	10.5									
2+00	86.3	76.43	9.9		4" riser 4" riser							
					2+33 W 2+12 E							
3+00	86.0	76.61	9.4		3+30 W 3+20 E							
	86.0	76.66	9.3	3+36.0	4" riser 4" STUB E							
					3+41 W							
4+00	85.5	76.80	8.7		4" riser 4" riser							
					4+58 W 4+72 E							
5+00	85.2	77.00	8.2		4" riser 4" riser							
					5+49 W 5+73 E							
6+00	84.8	77.20	7.6		5+96.2 W							
	84.5	77.32	7.2	6+61.2	8" STUB N							
LATERAL 224 MAIN 5 SS N°22												
0+00	127.3	118.02	9.3	EXISTING	0+64.8 0+59.0							
					1+31.0 1+48.3							
1+00	126.3	118.27	8.0									
2+00	125.9	118.52	7.4		2+02.8 2+12.3							
					2+75.7 2+78.7							
	126.3	118.76	7.5	2+97.7								
3+00	126.3	118.77	7.5		3+46.4 3+73.2							
4+00	125.6	119.02	6.6		4+53 W 4+14.2							
					4+15.7							
5+00	124.6	119.27	5.3		4+83.3 4+70.2							
					5+52.0 5+41.0							
	124.3	119.49	4.8	5+87.6	4" STUB SW 4" STUB SE							

#93-26497-7 - 2824 N. Ohio - NC - 10-6-93 - South Part
 Precedo top (4") - 4" PVC 45° V to H at main; 1-4 1/2" PVC Bushing; 2-3 PVC 90°;
 1-3" PVC 45°; North Part 1-3" PVC 45°; 2-3" PVC 90°

94-7191-7 5/11/94 410 N west (New Bldg) - Betzen trenching -