


21 ST ST N

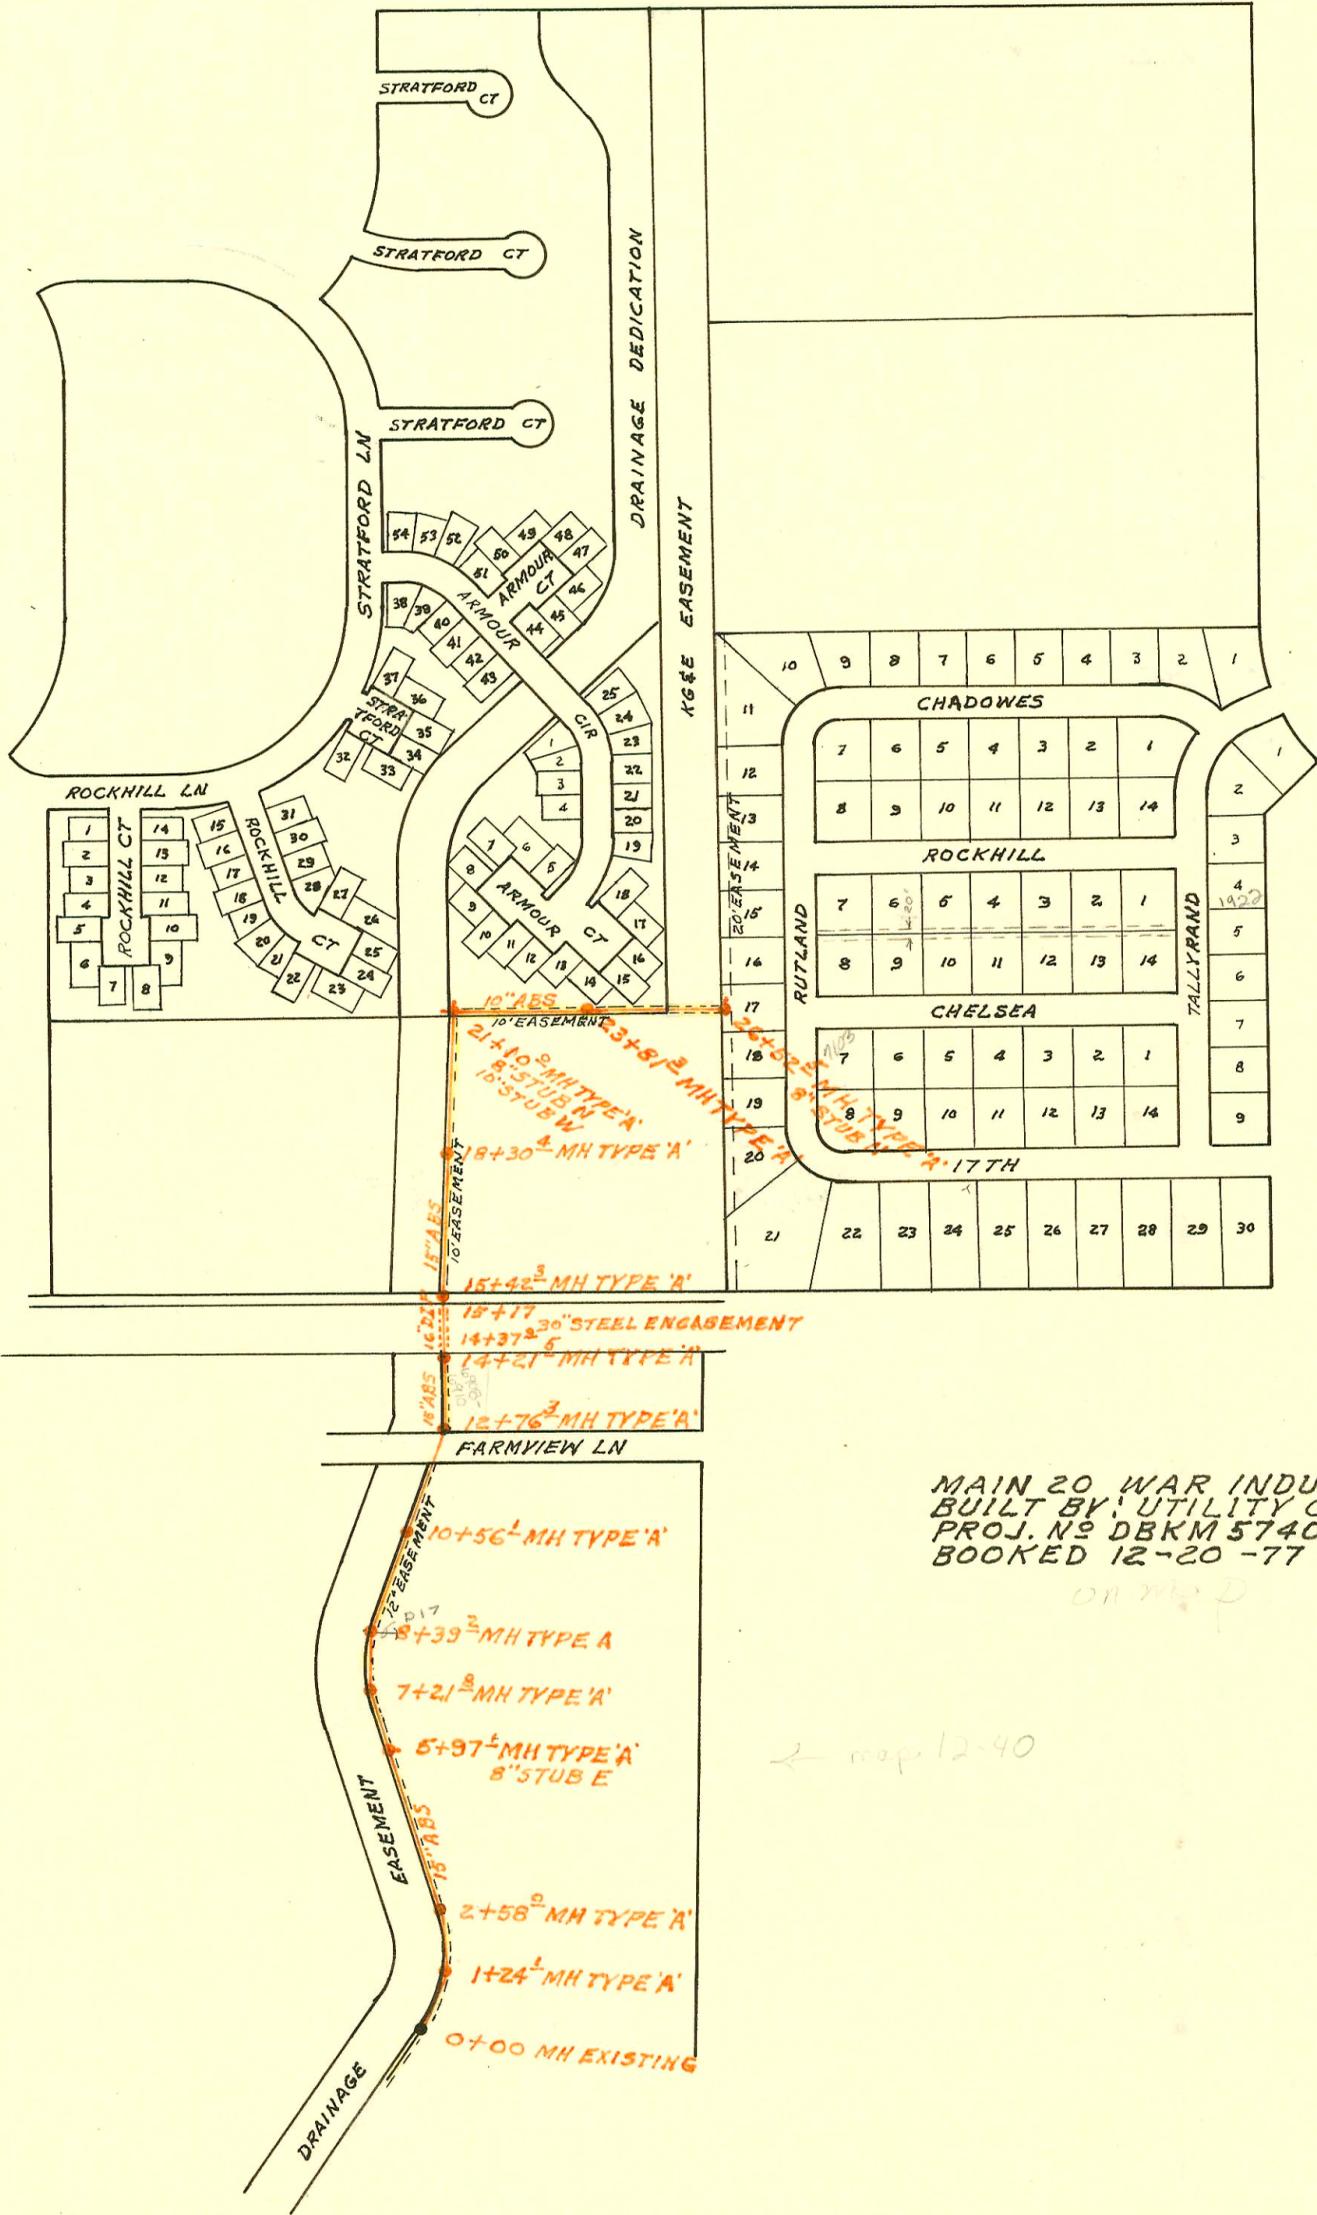

SCALE 1" = 300'

MAIN 20" WAR INDUSTRIES SEWER  
 BUILT BY: UTILITY CONTR. INC.  
 PROJ. NO DBKM 574017  
 BOOKED 12-20-77 FROM 1H89

← map 12-40

CONSTRUCTION RECORD

SERVICE RECORD

MAIN 20 WAR INDUSTRIES SEWER

STATION	ELEVATION		Depth	MANHOLE	4-INCH "Y" BRANCHES		No. of Permit		House Number		DATE OF PERMITS	
	Ground	Grade			North West	South East	North West	South East	North West	South East	North West	South East
0+00	189.5	178.35	11.2	0+00 EXISTING								
1+00	190.2	178.60	11.6									
	189.8	178.77	11.0	1+24.1								
2+00	190.2	178.95	11.3									
	190.1	179.09	11.0	2+58.0								
3+00	190.0	179.20	10.8									
4+00	190.1	179.45	10.7									
5+00	190.6	179.70	10.9									
6+00	191.1	179.95	11.2	5+97.1		8" STUB E						
	191.0	179.96	11.0									
7+00	191.3	180.20	11.1									
	191.4	180.25	11.2	7+21.8								
8+00	192.6	180.45	12.2									
	191.8	180.55	11.3	8+39.2								
9+00	192.7	180.70	12.0									
10+00	193.0	180.95	12.1									
	192.4	181.09	11.3	10+56.1								
11+00	193.0	181.21	11.8									
12+00	193.5	181.50	12.0									
	193.8	181.71	12.1	12+76.3								
	194.0	181.81	12.0									
13+00	194.0	181.87	12.1									
					13+23.8		3123		6908		4-16-81	
					13+25.3		3124		6910		4-16-81	
14+00	193.9	182.12	11.8									
	193.4	182.17	11.2	14+21.5								
14+37												
15+00	194.3	182.66	11.6									
15+17												
	193.5	182.92	10.6	15+42.3								
		182.99	10.5									
16+00	194.0	183.11	10.9									
17+00	194.2	183.31	10.9									
18+00	194.6	183.51	11.1									
	195.0	183.57	11.4	18+30.4								
19+00	194.7	183.73	11.0									
20+00	195.1	183.97	11.1									
21+00	196.0	184.21	11.8									
	195.0	184.23	10.8	21+10.0		8" STUB N						
		184.33	10.7			10" STUB W						
22+00	197.0	185.38	11.6									
23+00	198.7	186.55	12.2									
	200.2	187.50	12.7	23+81.3								
24+00	200.9	187.72	13.2									
25+00	202.6	188.92	13.7									
26+00	204.8	190.12	14.7									
	206.0	190.75	15.3	26+52.5		8" STUB N						