


RECON SEWER TO SUPPLEMENT PORTION
 DIST. Y SANITARY SEWER N^o 20
 BUILT BY: MID STATES CONST. CO.
 PROJ. N^o DBKJ 576061
 BOOKED 1-12-78 FROM CG 17

SCALE 1"=150'

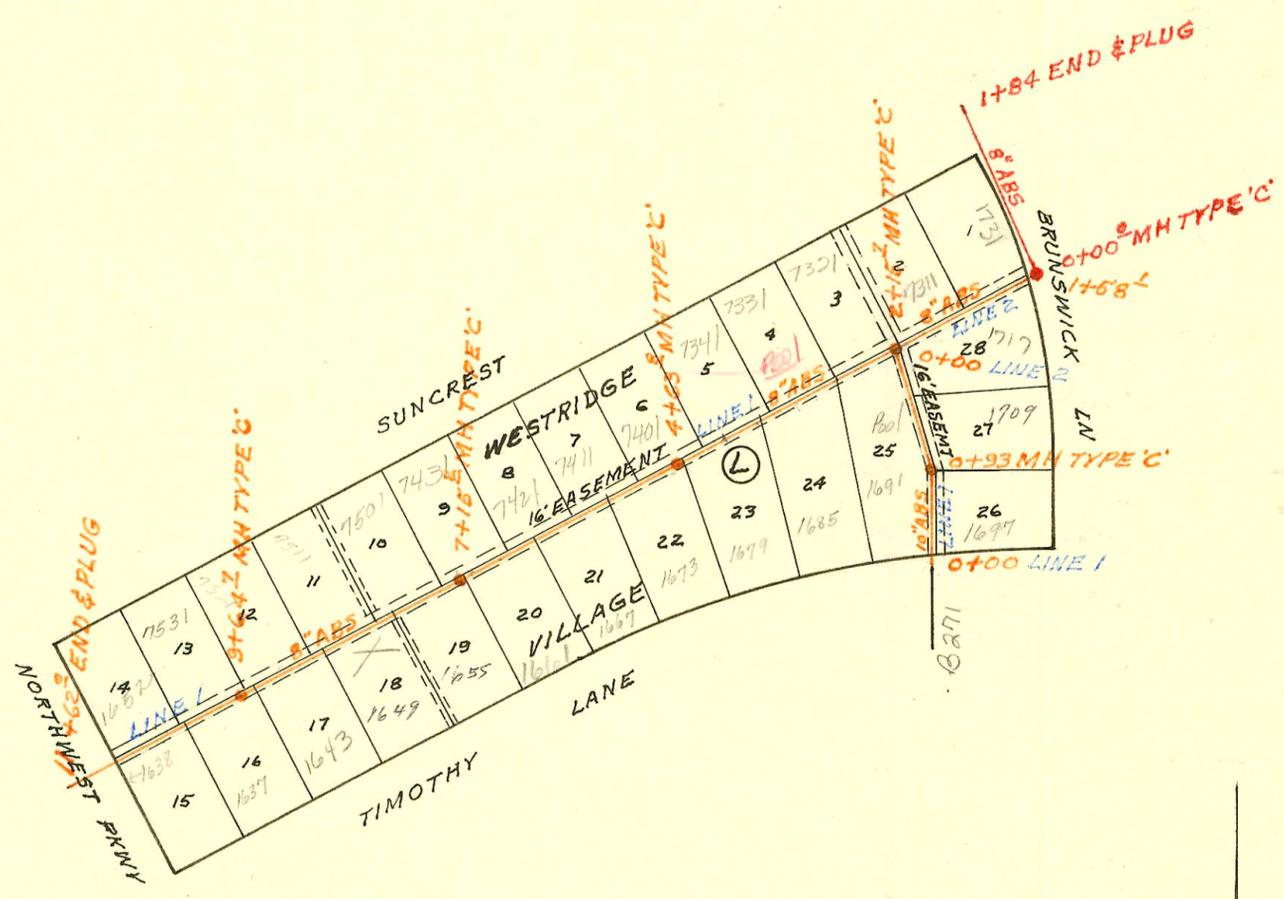

LATERAL 85 SOUTHWEST INTERCEPTOR
 BUILT BY: SHAWNEE CONST. CO.
 PROJ. N^o DBKL 576035
 BOOKED 1-13-78 FROM LES 10

SAN SEWER EXTENSION TO N SIDE SUNCREST
 BUILT BY: SHAWNEE CONST. CO.
 PROJ. N^o DBKW 707071
 BOOKED 1-13-78 FROM LES 10

SCALE 1"=150'

CONSTRUCTION RECORD						SERVICE RECORD						
STATION	ELEVATION		Depth	MANHOLE	4-INCH "Y" BRANCHES		No. of Permit		House Number		DATE OF PERMITS	
	Ground	Grade			North West	South East	North West	South East	North West	South East	North West	South East
RECON SEWER TO SUPPLEMENT PORTION DIST. Y SS N ^o 20												
LINE 1	0+00	114.6	106.44	8.2	EXISTING							
	+44											
	+79											
	1+00		106.54									
	2+00		106.64									
		113.70	106.67	7.0	2+31.5							
	3+00		106.74									
	4+00		106.84									
		114.60	106.86	7.7	4+14.9							
		114.85	106.89	8.0	4+47.4							
	5+00		106.95									
	6+00		107.05									
		113.06	107.10	6.0	6+54.6							
		113.0	107.14	5.9	6+87							
	7+00		107.22									
	8+00		107.32									
		111.40	107.33	4.1	8+09.3							
	9+00		107.42									
	10+00		107.52									
		112.2	107.60	4.6	10+81.6							
LINE 2	0+00	112.3	106.11	6.2	0+00							
		112.9	106.36	6.5	0+78							
LATERAL 85 SOUTHWEST INTERCEPTOR SEWER												
LINE 1	0+00	143.0	135.10	7.9	0+78			C65820		1697	Timothy	4-28-78
		140.6	135.38	5.2	0+93.0					1709	Cranswick	6-12-78
			135.48	5.1				C66781				
	1+00	140.3	135.51	4.8								
	2+00	145.1	135.80	9.3								
		145.1	136.01	9.3	2+15.7							
				9.1								
	3+00	144.8	136.27	8.5								
					3+31			C67739		1717	Cranswick	8-8-78
	4+00	146.5	136.57	9.9								
		148.7	136.76	11.9	4+63.8							
	5+00	149.5	136.90	12.6								
	6+00	150.3	137.30	13.0								
	7+00	151.3	137.70	13.6								
		151.6	137.76	13.8	7+15.2							
	8+00	153.0	138.10	14.9								
		152.5	138.50	14.0								
	9+00	152.3	138.76	13.5	9+64.7							
		152.3	138.90	13.4								
	10+00	152.3	139.30	13.2	9+04.7							
		152.3	139.55	12.8								
LINE 2	0+00	145.1	136.01	9.1	0+00=2+15.7							
	1+00	144.9	136.31	8.6	LINE 1							
	1+58.1	143.3	136.48	6.8								
SANITARY SEWER EXTENSION TO N SIDE SUNCREST												
	0+00	145.4	136.58	8.8	0+00							
	1+84	147.7	137.13	10.6								

C64610-1669 Timothy - 12-23-77 TAP 8+15.6

Post office connected approx mid way
between MH 2+31.5 and STA 0+79 (end of con. enc)
per field 10/31/85