
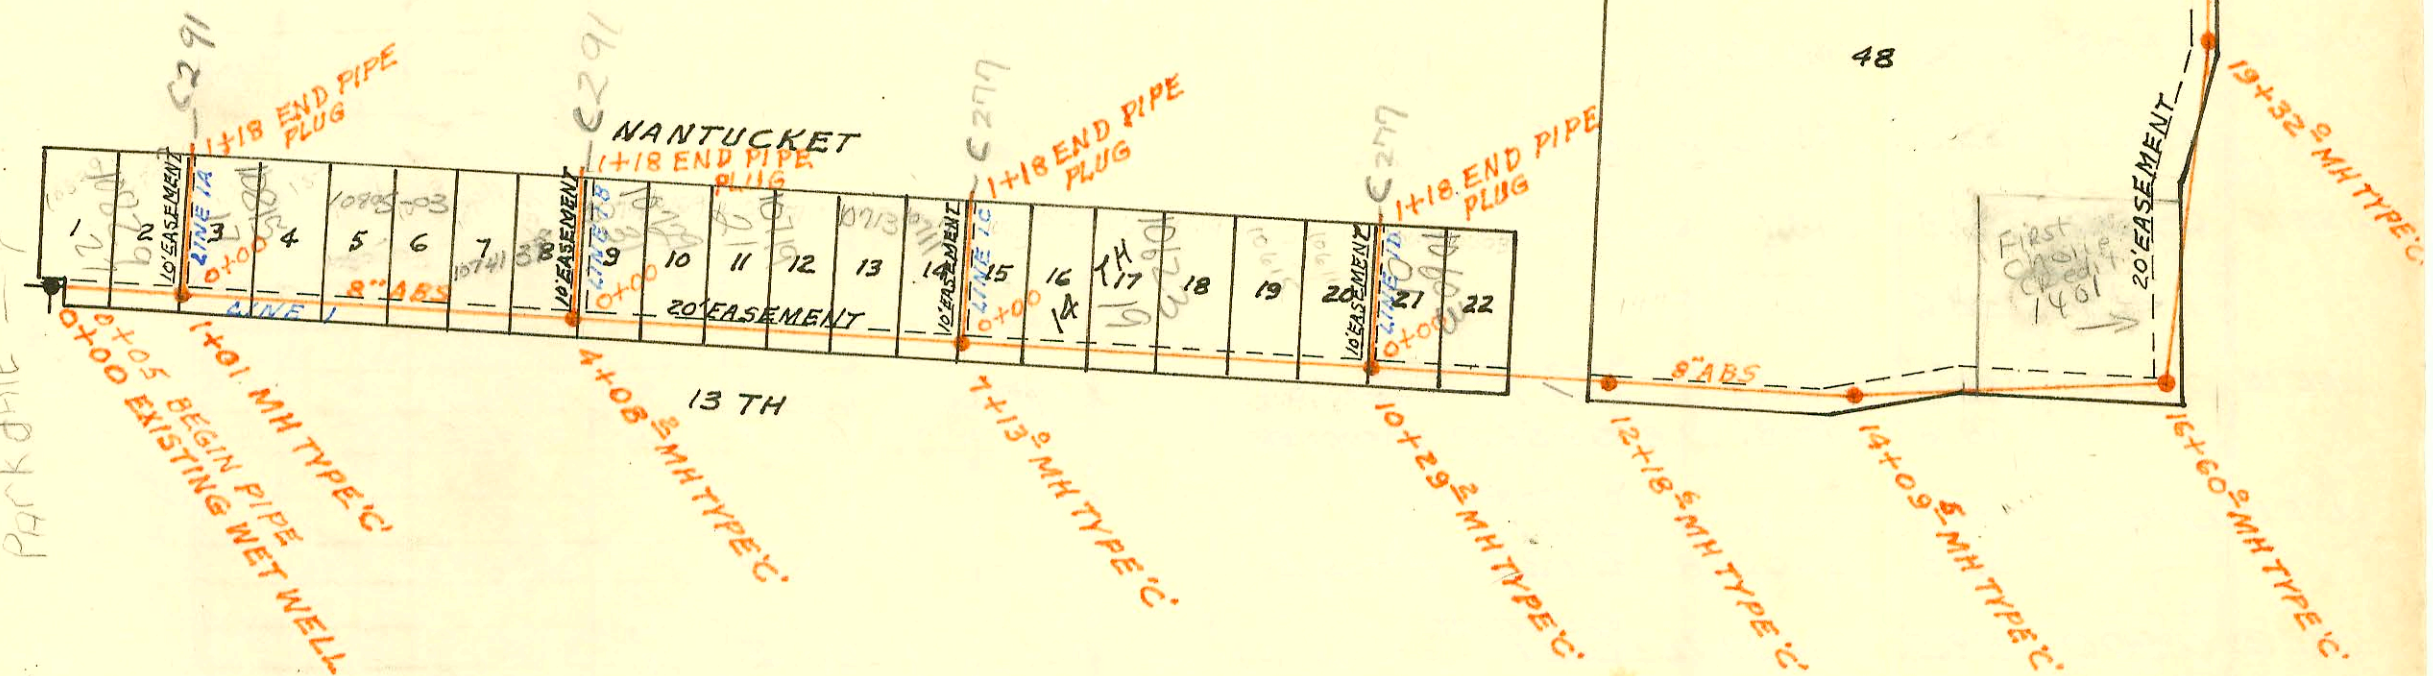


LATERAL 108 SOUTHWEST INTERCEPTOR
BUILT BY: W.B. CARTER CONST. CO.
PROJ. N^o DBKL 577045
BOOKED 2-24-78 FROM K-106

DN 108

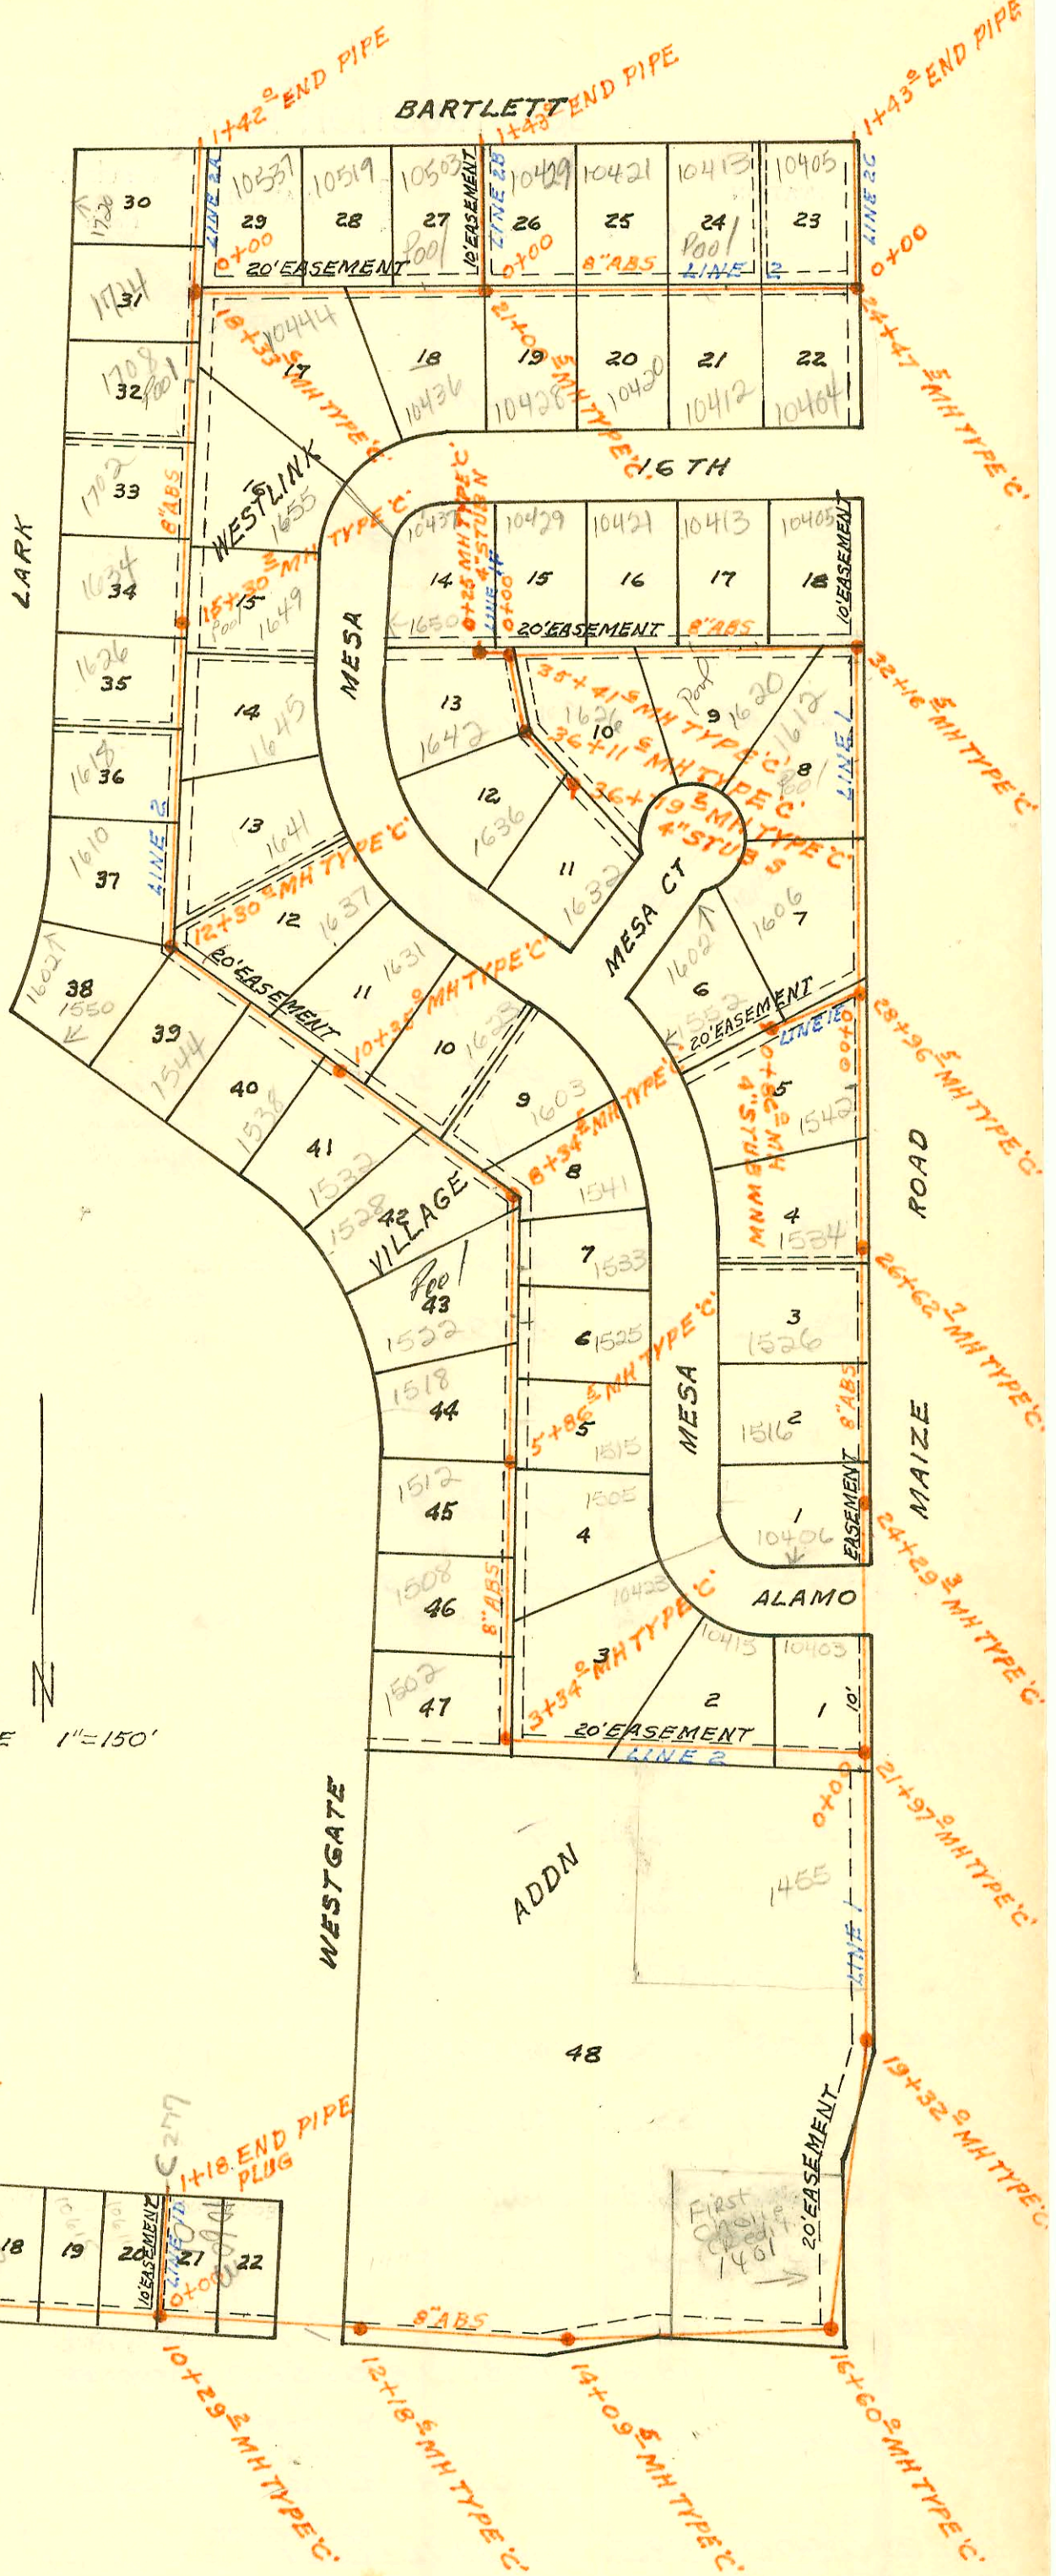

CONSTRUCTION RECORD

SERVICE RECORD

STATION	ELEVATION		Depth	MANHOLE	4-INCH "Y" BRANCHES		No. of Permit		House Number		DATE OF PERMITS	
	Ground	Grade			North West	South East	North West	South East	North West	South East	North West	South East
LATERAL 108 SWI (CONT)												
L1+ LINE 1 CONT	158.5	146.09	12.4	21+97.0								
22+00	158.5	146.11	12.4									
23+00	158.5	146.41	12.1									
24+00	158.5 158.6	146.71 146.80	11.8	24+29.3	24+38.4 24+96.9		C673201 C67691		10406 Alamo 1516 Mesa		7-26-79 8-3-78	
25+00	158.6	147.01	11.6		25+88.9		C67492		1526 Mesa		8-3-78	
26+00	158.5 158.5	147.31 147.50	11.2 11.0	26+62.7	26+70.0		C67693		1534 Mesa		8-3-78	
27+00	158.6	147.61	11.0									
28+00	158.5 158.5	147.91 148.20	10.6 10.3	28+96.5	28+12.6		C671189		1542 Mesa		4-11-79	
29+00	158.6	148.21	10.4									
30+00	158.5	148.61	9.9									
31+00	158.5	149.01	9.5									
32+00	159.0 159.0	149.41 149.58	9.6 9.4	32+16.5	30+92.8 31+15.5		C67744 C68944		15423 W. 16th Mesa		8-15-78 10-18-78	
33+00	158.7	149.91	8.8		32+52.3		C73684		10405 1216 Mesa		8-17-79	
34+00	158.7	150.31	8.4		33+49.1		C67896		1620 Mesa		8-16-78	
35+00	159.2 159.3	150.71 150.98	8.5 8.3	35+41.6	34+23.6		C69971 C69812		10413 10421 W. 16th Mesa		12-27-78 12-14-78	10-16-78
36+00	160.0 160.0	151.21 151.26	8.8 8.7	36+11.6	35+99.7		C67735		10429 W. 16th		8-8-78	
	159.7	151.53	8.2	36+79.2	36+49.6		C69148		1642 Mesa		12-1-78	
						4" STUB S	C67694		1636 Mesa 1632 Mesa Ct.		10-30-78 8-3-78	
LINE 1A	0+00	156.0	140.86	15.1	0+00=1+01							
	1+18	156.0	141.33	14.7	PLUGGED							
LINE 1B	0+00	156.6	141.62	15.0	0+00=4+08.2							
	1+18	157.0	142.09	14.9	PLUG							
LINE 1C	0+00	157.6	142.38	15.2	0+00=7+13							
	1+18	158.0	143.32	14.7	PLUG							
LINE 1D	0+00	157.8	143.17	14.6	0+00=10+29.2							
	1+18	158.6	143.64	15.0								
LINE 1E	0+00	158.5 158.6	148.29 148.81	10.2 9.8	0+00=28+96.5 0+86.0	0+93.0 4" STUB WNW	C71041 C69404		1606 Mesa 1602 Mesa		4-5-79 11-14-78	
LINE 1F	0+00	159.3 159.3	150.86 151.06	8.4 8.2	0+00=35+41.6 0+25	LINE 1 4" STUB N	C70896		1650 Mesa		3-29-79	
LINE 2	0+00	158.5	146.19	12.3	0+00=21+97	0+25.0	8760		10403 Alamo		7-21-83	
	1+00	158.0	146.44	11.6		1+102.6	7954		10415 W Alamo		4-27-83	8-7-78
	2+00	158.3	146.69	11.6								
	3+00	158.7	146.94	11.8		2+175	C76840		10423 Alamo		3-17-80	

CONTD NEXT PAGE

