


LATERAL 25 MAIN 9 WAR INDUSTRIES SEWER  
 BUILT BY: UTILITY CONTR. INC.  
 PROJ. N<sup>o</sup> DBKL 577054  
 BOOKED 4-11-78 FROM MRT 22

on map

SCALE 1"=150'

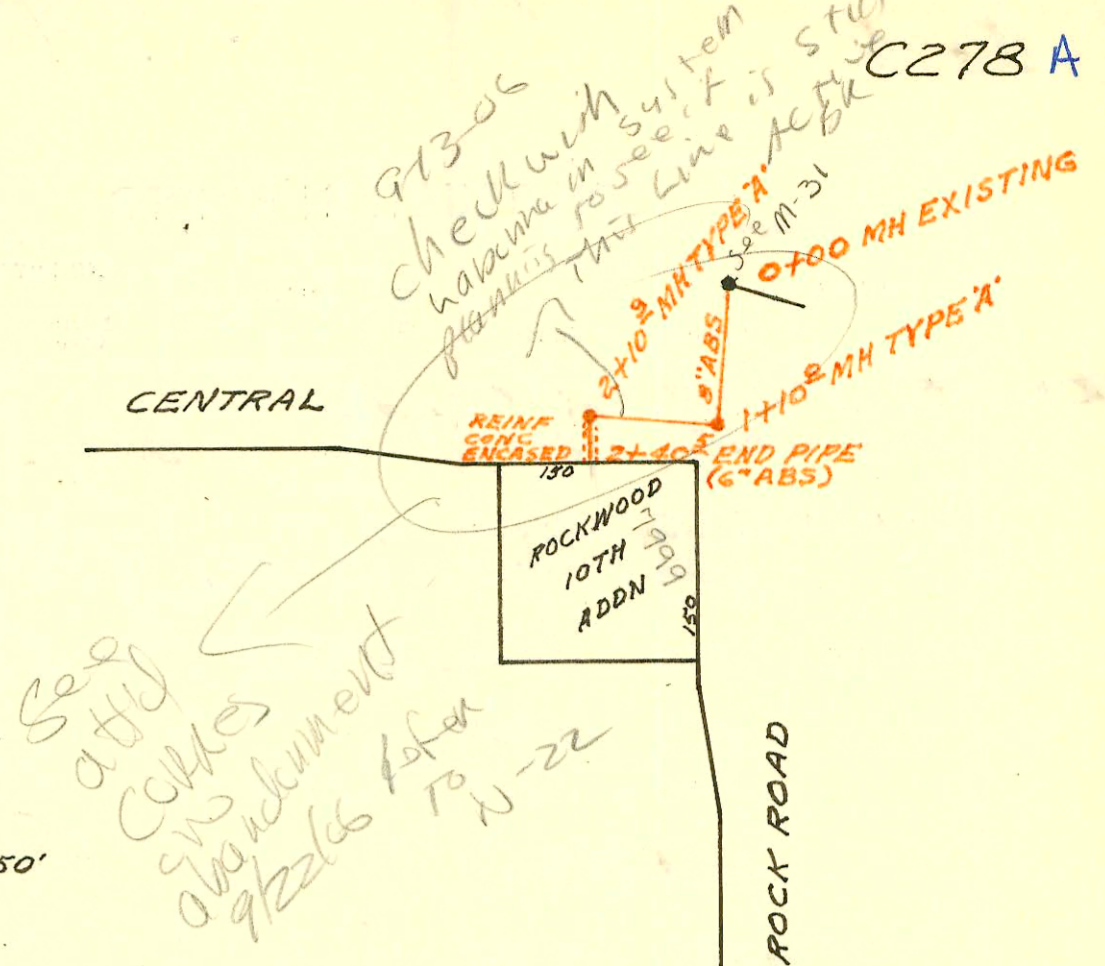


SCALE 1"=200'

BOWERS 1ST ADDN SANITARY SEWER  
 BUILT BY: W.B. CARTER CONST. CO.  
 PROJ. N<sup>o</sup> DBKW 706057  
 BOOKED 5-1-78 FROM PLAN (AC)

on map

2002-02138 81710a 4303 N Mission  
 Redd Rptr - twin co, 2445,  
 replaced 5' low end

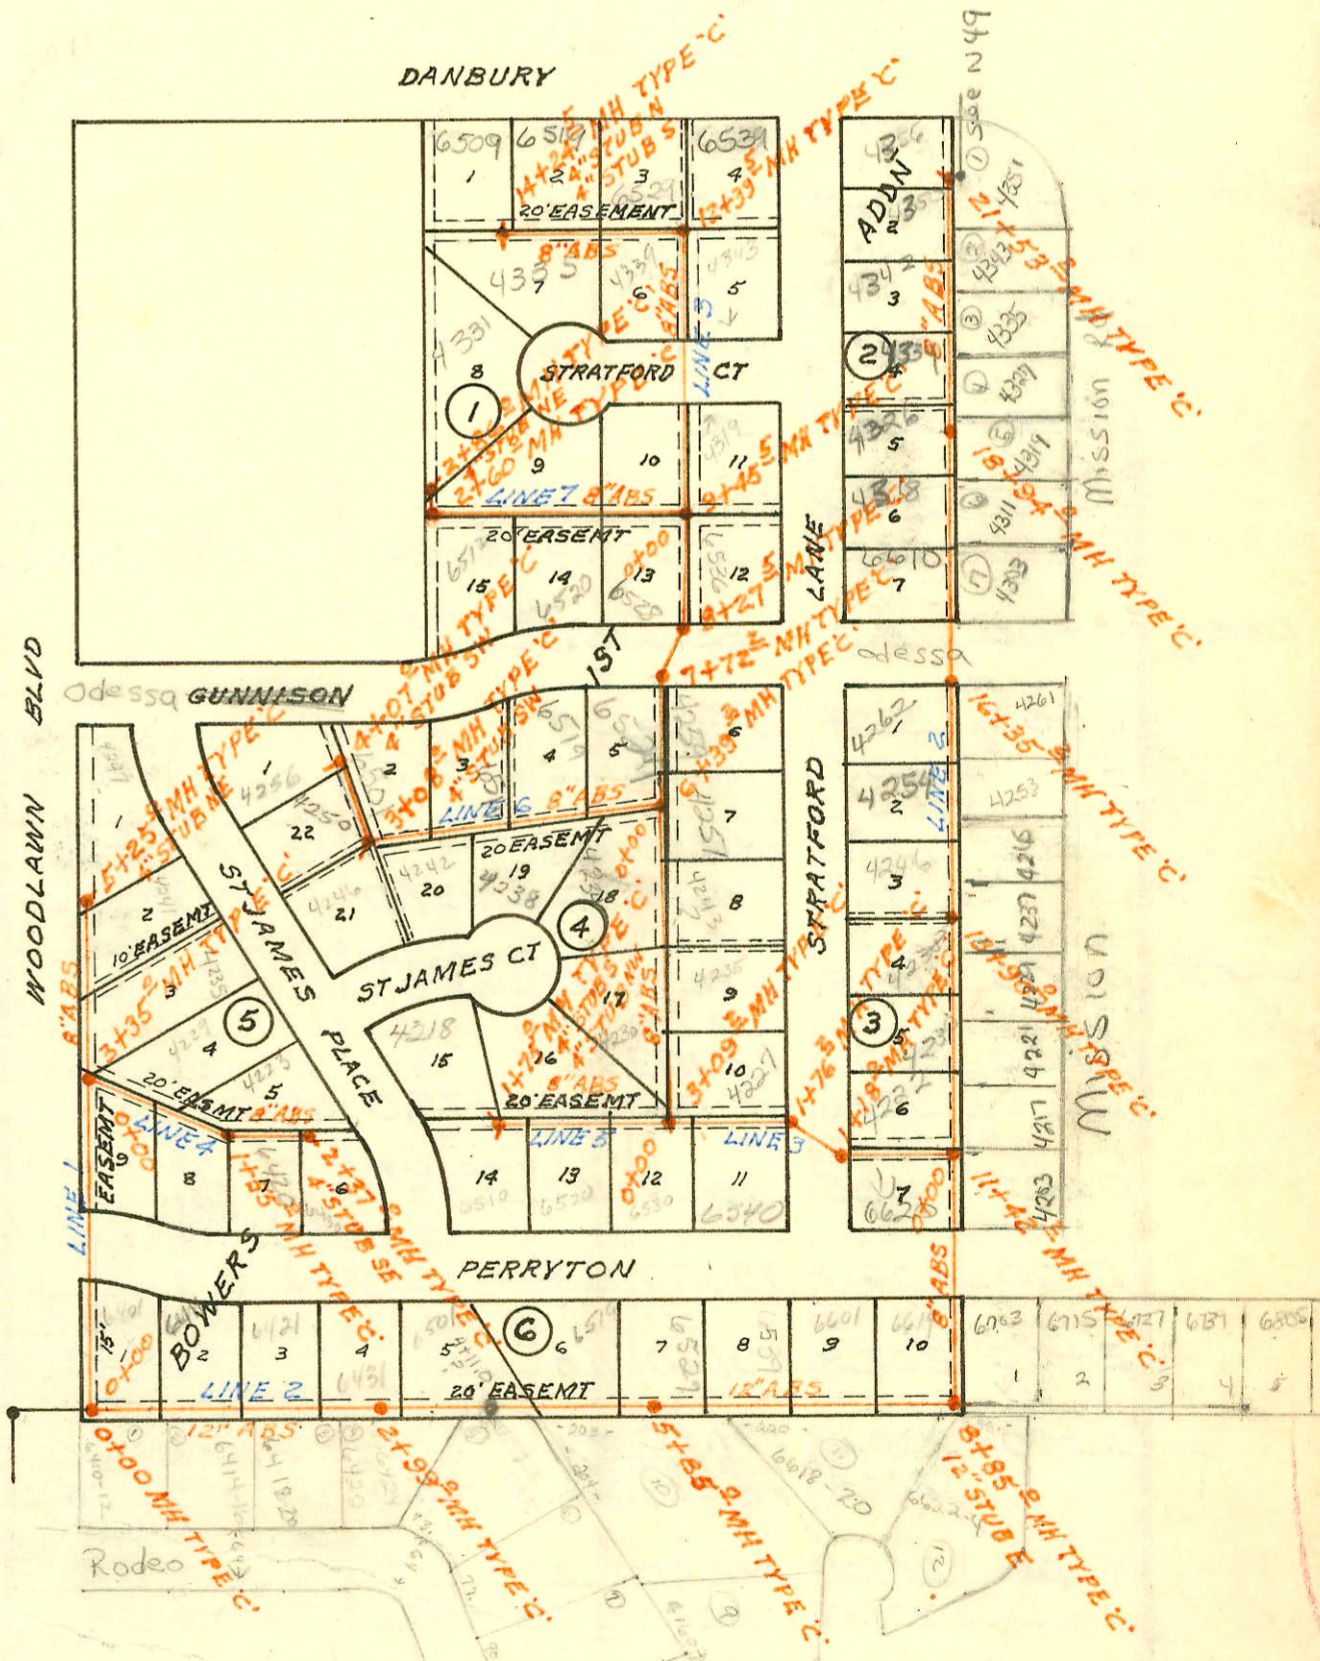

Map 202

CONSTRUCTION RECORD

SERVICE RECORD

STATION	ELEVATION		Depth	MANHOLE	4-INCH "Y" BRANCHES		No. of Permit		House Number		DATE OF PERMITS		
	Ground	Grade			North West	South East	North West	South East	North West	South East	North West	South East	
BOWERS 1ST ADDN 55 CONT'D													
LINE 2 CONT'D	20+00	205.1	193.86	11.2		4" SDR 20+30.2 tap	4" SDR 20+23.2	00969	2560	4342 STRATFORD	4343 N Mission Mrs 157	9-3-91	10-26-93
	21+00	205.9	195.05	10.9		4" SDR 35 21+06.7 tap	4" SDR 35 21+06.7 tap	00054		4350 STRATFORD		4-8-91	
		208.4	195.68	12.7	21+53.2	4" N.H. stub		1964		4356 STRATFORD		2-3-92	
LINE 3	0+00	194.0	185.44	8.56	0+00=11+42.2 LINE 2	0+45.6 tap	0+49.0 tap	072296	21189	4227 STRATFORD	6020 Perryton	6-12-79	7-20-80
	1+00	196.1	185.84	10.3									
		196.7	185.91	10.8	1+18.0								
		197.4	186.01	10.7									
		197.4	186.24	11.2	1+76.2								
		197.4	186.34	11.1									
	2+00	197.3	186.44	10.9									
	3+00	198.8	186.83	12.0									
		199.5	186.87	12.6	3+09.2								
		199.5	188.98	10.5									
	4+00	200.7	189.32	11.4									
	5+00	201.9	189.69	12.2									
	6+00	201.9	190.06	11.8									
		202.5	190.20	12.3	6+39.2								
	7+00	202.6	190.44	12.2									
		202.0	190.73	11.3	7+72.2								
		202.0	190.83	11.2									
	8+00	201.3	190.94	10.4									
		201.4	191.05	10.4	8+27.5								
		201.4	191.15	10.3									
	9+00	202.1	191.44	10.7									
		204.2	191.62	12.6	9+45.5								
		204.2	193.64	10.6									
	10+00	204.4	194.04	10.4									
	11+00	206.3	194.79	11.5									
	12+00	207.3	195.53	11.8									
		206.7	195.82	10.9	12+39.5								
		206.7	195.92	10.8									
	13+00	209.5	196.16	13.3									
	14+00	207.8	196.56	11.2									
		208.5	196.66	11.8	14+24.5								
LINE 4	0+00	191.6	182.16	9.4	0+00=3+35.0 LINE 1								
	1+00	192.4	182.56	9.8									
		193.5	182.78	10.7	1+55.0								
		193.5	182.88	10.6									
	2+00	195.0	184.68	10.3									
		195.9	186.16	9.7	2+37.0								
LINE 5	0+00	199.5	188.98	10.5	0+00=3+09.2 LINE 3								
	1+00	200.1	189.79	10.3									
		199.6	190.40	9.2	1+75.0								
LINE 6	0+00	202.5	190.30	12.2	0+00=6+39.2 LINE 3								
	1+00	204.1	190.70	13.4									
	2+00	202.9	191.10	11.8									
	3+00	200.6	191.50	9.1									
		200.8	191.53	9.3	3+08.0								
		200.8	191.63	9.2									
	4+00	201.2	192.00	9.2									
		201.0	192.03	9.0	4+07.0								

CONT'D NEXT PAGE

