


SCALE 1"=150'

LATERAL 19 MAIN 3 WESTLINK SEWER  
 BUILT BY: UTILITY CONTR. INC.  
 PROJ. N<sup>o</sup> DBKL 577077  
 BOOKED 4-24-78 FROM JLA 8


*on map*  
*clean*

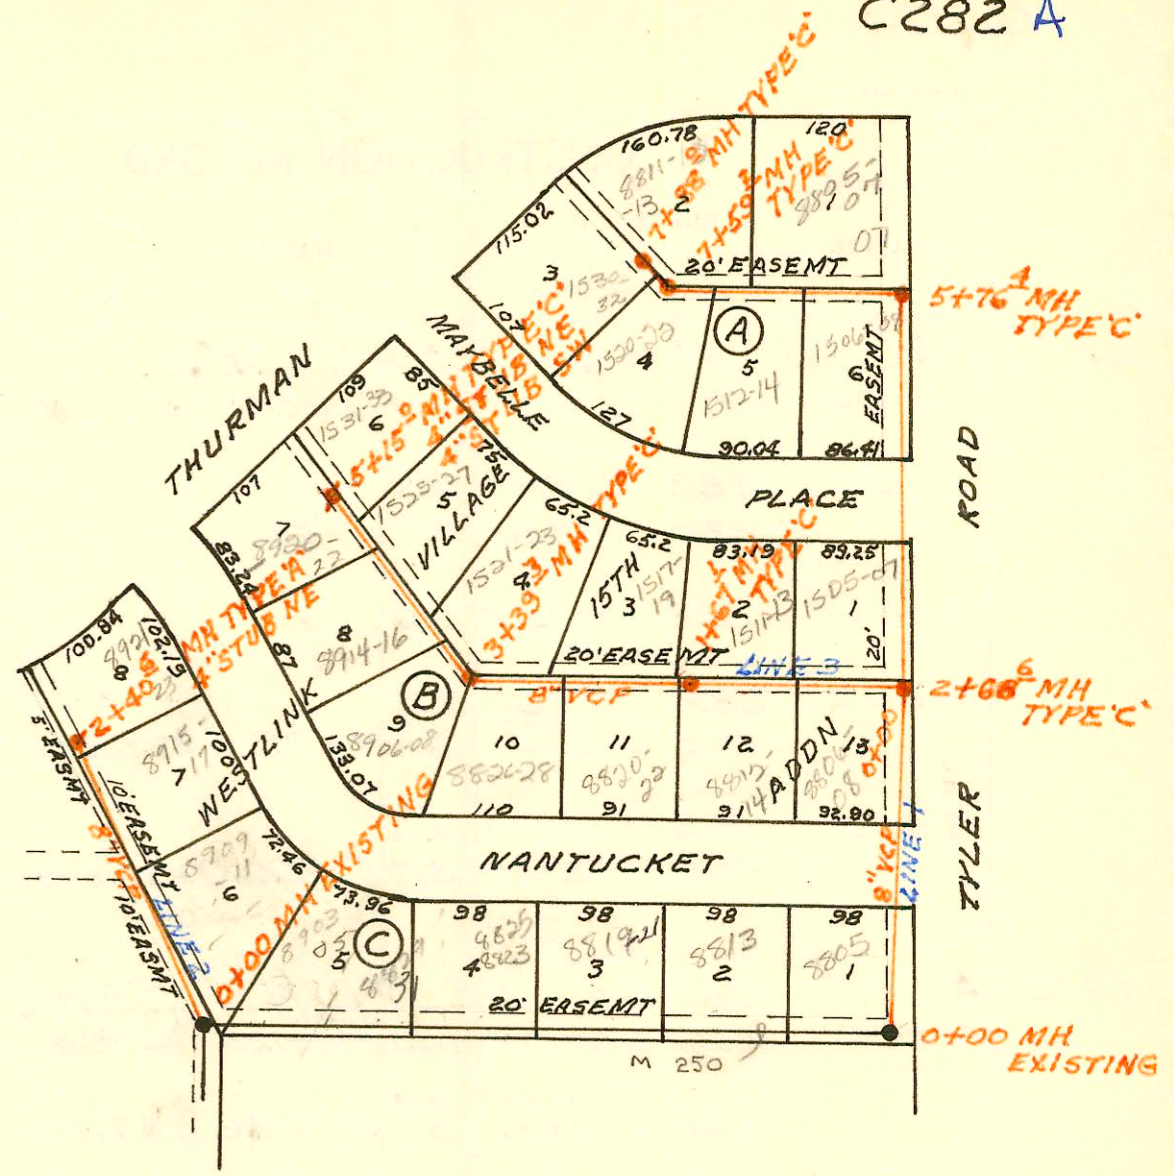

LATERAL 223 MAIN 5 S.S. N<sup>o</sup> 22  
 BUILT BY: UTILITY CONTR. INC.  
 PROJ. N<sup>o</sup> DBKL 577007  
 BOOKED 4-25-78 FROM LES 9

*on map*  
*clean*

SCALE 1"=150'

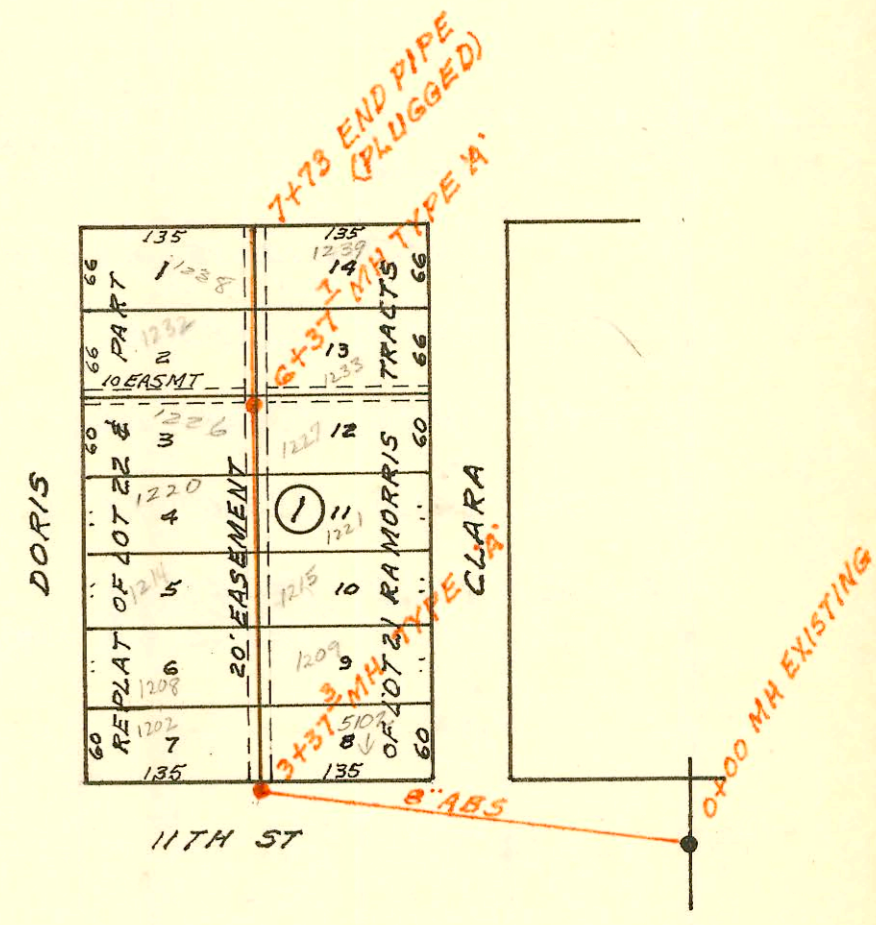

CONSTRUCTION RECORD

SERVICE RECORD

STATION	ELEVATION		Depth	MANHOLE	4-INCH "Y" BRANCHES		No. of Permit		House Number		DATE OF PERMITS	
	Ground	Grade			North West	South East	North West	South East	North West	South East	North West	South East
<b>LATERAL 19 MAIN 3 WESTLINK SEWER</b>												
L1 0+00	164.7	152.25	12.5	0+00 EXISTING	0+17.10		1349		8805 Nantucket		9-24-80	
1+00	164.9	152.65	12.3									
2+00	165.0	153.05	12.0									
	164.8	153.32	11.5	2+68.6								
3+00	165.0	153.56	11.4		3+14.2		069680		1505 Maybelle		12-7-78	
4+00	165.2	154.31	10.9									
5+00	166.0	155.06	10.9									
	166.7	155.73	11.0	5+76.4	6+03.1	5+09.5	066890	066892	8805 Sherman	1506 Maybelle	6-19-78	6-19-78
					6+73.3	6+50.6	066944	066959	8807 Sherman	1505 Maybelle	6-20-78	6-20-78
6+00	166.6	155.91	10.7		6+90.0	6+52.3	066891	066893	8811 Thimble	1512 Maybelle	6-19-79	6-19-78
7+00	166.9	156.66	10.2									
	167.0	157.20	9.8	7+59.2	7+55.3		066951	066894	8813 Sherman	1514 Maybelle	6-20-78	6-20-78
	167.2	157.41	9.8	7+88.0								
L2 0+00	161.6	151.03	10.6	0+00 EXISTING								
1+00	161.4	151.83	9.6									
2+00	161.3	152.63	8.7									
	161.0	152.95	8.1	2+40.6	4" STUB NE		074178	074180	9002-04 Nantucket	8917 Nantucket	9-20-79	9-11-79
L3 0+00	164.8	153.42	11.4	0+00=2+68.6 LINE 1								
1+00	165.0	153.82	11.2									
	165.4	154.08	11.3	1+67.1			069683	068283	1511 Maybelle	8812-14 Nantucket	12-4-78	9-11-78
2+00	165.3	154.22	11.1				067572	068286	1517 Maybelle	8820-22 Nantucket	7-28-78	9-11-78
							067574		1519 Maybelle	8826-28 Nantucket	7-28-78	9-11-78
3+00	166.2	154.62	11.6									
	166.2	154.88	11.3	3+39.3			067575	068282	1521 Maybelle	8906-08 Nantucket	7-28-78	9-11-78
							067576	068285	1523 Maybelle	8906-08 Nantucket	7-28-78	9-11-78
4+00	165.2	155.12	10.1									
5+00	164.6	155.52	9.1				066896	068287	1525 Maybelle	8914-16 Nantucket	6-19-78	9-11-78
	164.5	155.58	8.9	5+15.0	4" STUB NE 4" STUB SW		066957	069684	1527 Maybelle	8920-22 Nantucket	6-20-78	12-4-78
							066958		1533 Maybelle		6-20-78	
<b>LATERAL 223 MAIN 5 SAN SEWER N<sup>o</sup> 22</b>												
0+00	128.0	118.11	9.9	0+00 EXISTING								
1+00	127.2	118.41	8.8									
2+00	127.3	118.71	8.6									
3+00	127.2	119.01	8.2									
	127.5	119.22	8.3	3+37.3								
4+00	127.5	119.41	8.1									
5+00	128.3	119.71	8.6									
6+00	127.2	120.01	7.2									
	128.1	120.12	8.0	6+37.7			074096	065098	1226 N. Davis	1227 N. Davis	9-5-79	2-21-78
7+00	128.8	120.31	8.5				069523	065097	1232 N. Davis	1233 N. Davis	11-22-78	2-29-78
7+73	129.6	120.53	9.1				073275		1237 N. Davis		8-2-79	