


LATERAL 61 MAIN 17 S.S. No 22
 BUILT BY: W.B. CARTER CONST. CO.
 PROJ. No DBKL 577024
 BOOKED 4-26-78 FROM LES 10

on map


SCALE 1"=150'

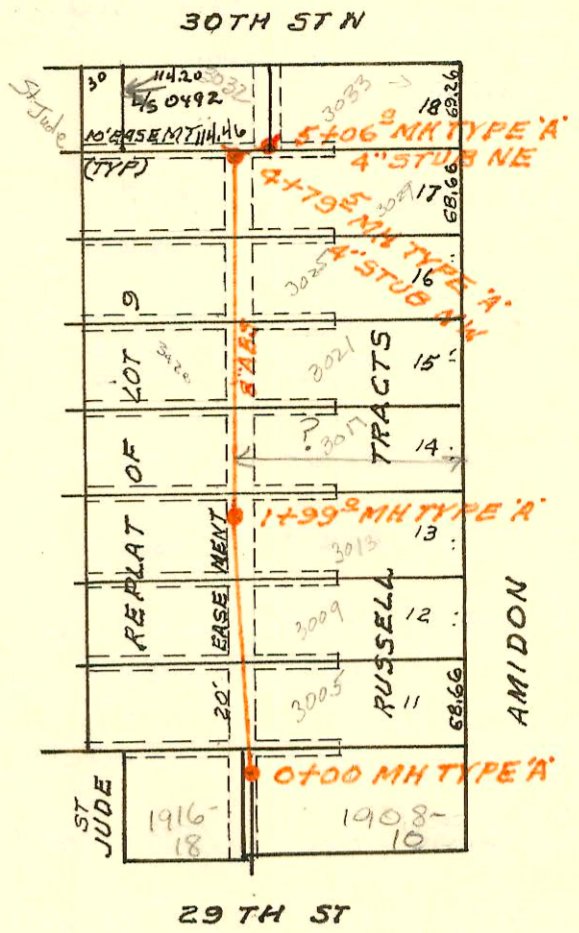

LATERAL 15 MAIN 1 WESTLINK SEWER
 BUILT BY: UTILITY CONTR. INC.
 PROJ. No DBKL 577022
 BOOKED 4-26-78 FROM LES 10

on map


SCALE 1"=150'

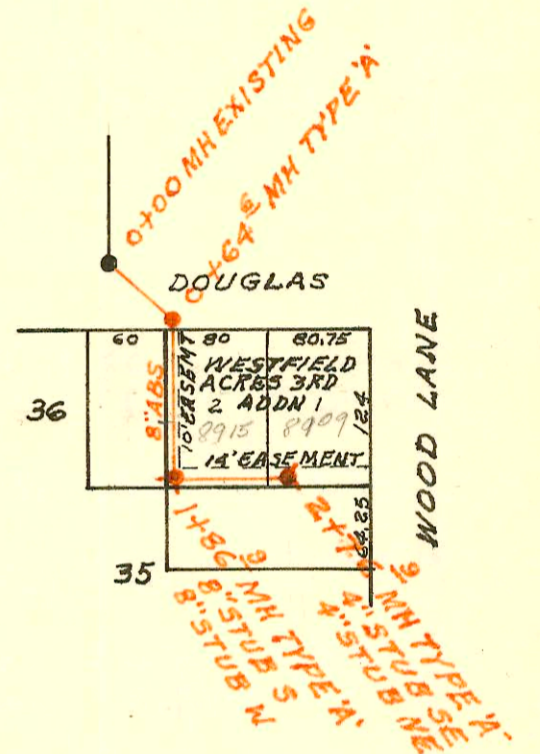

LATERAL 27 MAIN 4 SOUTHWEST INTERCEPTOR
 BUILT BY: ARKANSAS CONST. CO.
 PROJ. No DBKL 577080
 BOOKED 4-26-78 FROM LES 7

on map

SCALE 1"=150'

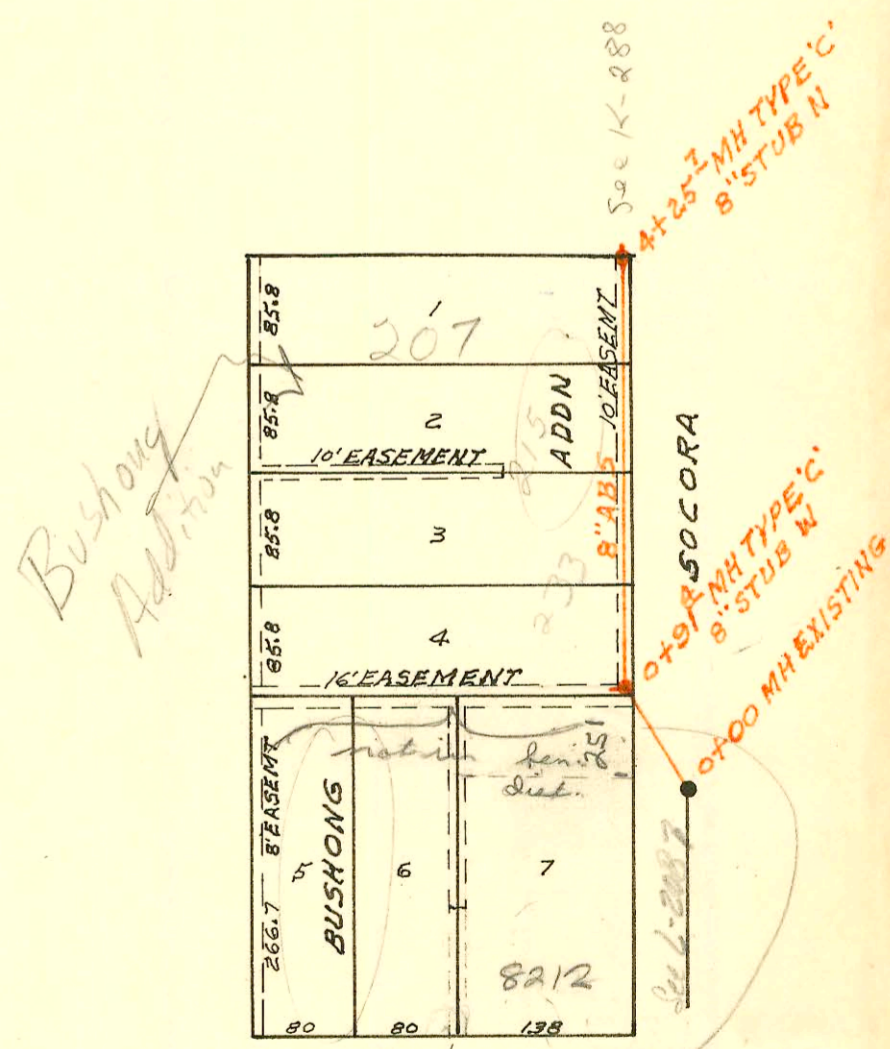

024627
 Hickox

MAPLE
 Lot split in progress
 251 S. Socora
 Misc # 31891 dtd 3/1/91
 512000 Lat & Elev for
 Proposed New House on
 N 60' of Lot 17

CONSTRUCTION RECORD

SERVICE RECORD

| STATION | ELEVATION | | Depth | MANHOLE | 4-INCH "Y" BRANCHES | | No. of Permit | | House Number | | DATE OF PERMITS | |
|--|-----------|--------|-------|---------|-----------------------|------------|---------------|------------|--------------|------------|-----------------|------------|
| | Ground | Grade | | | North West | South East | North West | South East | North West | South East | North West | South East |
| LATERAL 61 MAIN 17 SAN SEWER N^o22 | | | | | | | | | | | | |
| 0+00 | 128.1 | 118.01 | 10.1 | 0+00 | | | | | | | | |
| 1+00 | 128.3 | 118.41 | 9.9 | | | | | | | | | |
| | 128.5 | 118.81 | 9.7 | 1+99.0 | | | | | | | | |
| 3+00 | 128.8 | 119.21 | 9.6 | | | | | | | | | |
| 4+00 | 128.4 | 119.61 | 8.8 | | | | | | | | | |
| | 128.8 | 119.93 | 8.9 | | | | | | | | | |
| | | 120.00 | 8.8 | 4+79.5 | 4" STUB NW | | | | | | | |
| 5+00 | 128.8 | 120.10 | 8.7 | | | | | | | | | |
| | 128.8 | 120.13 | 8.7 | 5+06.0 | 4" STUB NE | | | | | | | |
| LATERAL 15 MAIN 1 WESTLINK SEWER | | | | | | | | | | | | |
| 0+00 | 143.7 | 133.71 | 10.0 | 0+00 | EXISTING | | | | | | | |
| | 143.6 | 133.84 | 9.8 | | | | | | | | | |
| | | 133.94 | 9.7 | 0+64.6 | | | | | | | | |
| 1+00 | 144.2 | 134.02 | 10.2 | | | | | | | | | |
| | 143.9 | 134.12 | 9.7 | | | | | | | | | |
| | | 134.25 | 9.7 | 1+86.9 | 8" STUB W 8" STUB S | | | | | | | |
| 2+00 | 143.7 | 134.34 | 9.4 | | | | | | | | | |
| | 144.0 | 134.64 | 9.4 | 2+76.9 | 4" STUB NE 4" STUB SE | | | | | | | |
| LATERAL 27 MAIN 4 SOUTHWEST INTERCEPTOR SEWER | | | | | | | | | | | | |
| 0+00 | 140.6 | 133.50 | 7.1 | 0+00 | EXISTING | | | | | | | |
| | 142.0 | 133.68 | 8.3 | | | | | | | | | |
| | | 133.78 | 8.2 | 0+91.4 | 8" STUB W | | | | | | | |
| 1+00 | 141.9 | 133.80 | 8.1 | | | | | | | | | |
| 2+00 | 142.0 | 134.00 | 8.0 | | | | | | | | | |
| 3+00 | 141.8 | 134.20 | 7.6 | | | | | | | | | |
| 4+00 | 141.9 | 134.40 | 7.5 | | | | | | | | | |
| | 141.9 | 134.46 | 7.5 | | | | | | | | | |
| | | | 7.4 | 4+25.7 | 8" STUB N | | | | | | | |