


SCALE 1"=150'



there is a MH 159.9'E of 0100 MH. Refer to E 278

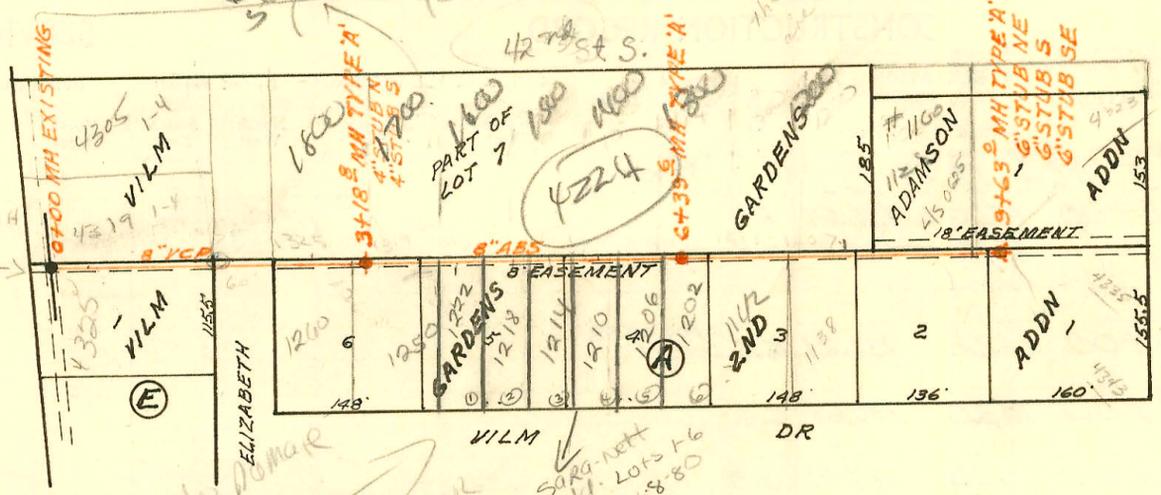

Tornado Damage  
 Need to get any new home not using old BK 9/23/99

LATERAL 16 MAIN 3 SWI  
 BUILT BY: W. B. CARTER CONST. CO.  
 PROJ. NO DBKL 576018  
 BOOKED 6-13-78 FROM CLG 03

S.S. ext. Phillips 66 Kellogg + Tyler Adm.  
 Proj. No. B21PPS  
 Built By McCullough Excavation  
 Booked 5-26-99 per As Buit.

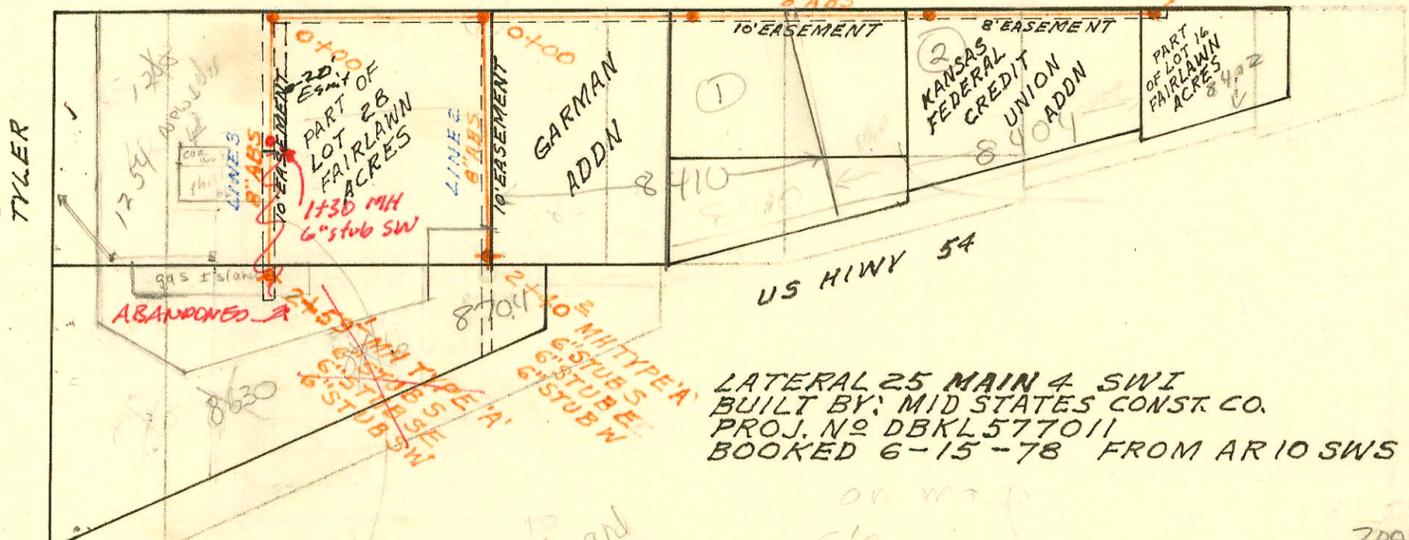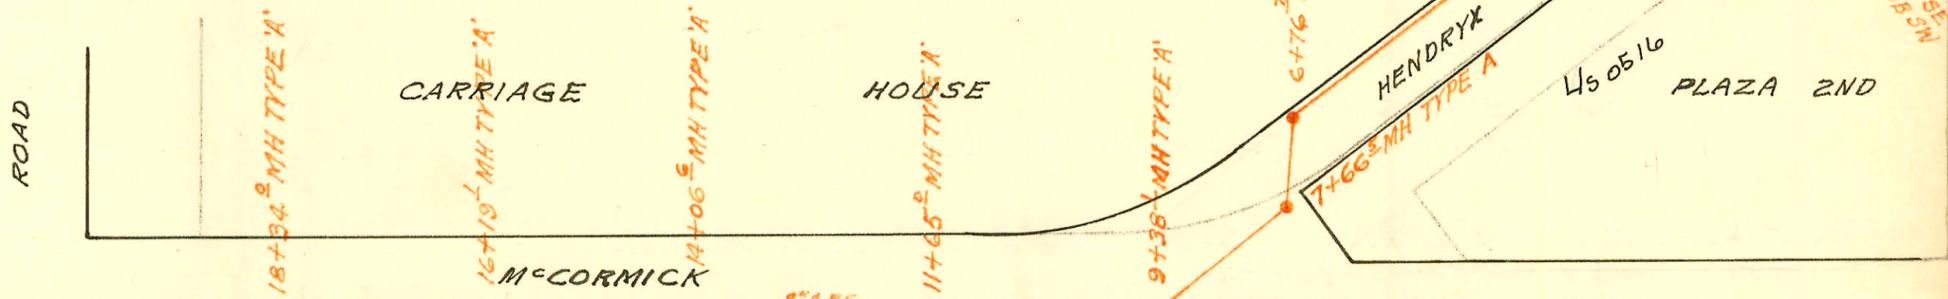

LATERAL 25 MAIN 4 SWI  
 BUILT BY: MID STATES CONST. CO.  
 PROJ. NO DBKL 577011  
 BOOKED 6-15-78 FROM AR 10 SWS

SCALE 1"=150'

This line to be abandoned and new manhole built. Do not issue any permit for this project. Bldg date this project completed after permit also, need to get BK 12/17/98 BS find out about exit private storm system

2001-02242 9/1/01 1218 W Vilma - Mies  
 NOTE: Per K Johnson apparently this house never sealed off. DL reconnect to tornado damaged house 4" PVC tied back into existing 4" SDR35 line from main 17W 20, 1045

1210 W Vilma - orig house destroyed by tornado. Serv. Line capped at foundation. No stp permit req'd per pty chief. new Bids permit issued 1-12-01. CNTR will connect new pty back to exist drain line.  
 2001-00484 3-1-01  
 99026390701 7/8/99 1214 W Vilma - Boardman: orig. house destroyed by tornado and Temp. Stp at foundation. House rebuilt on same foundation and final 2/20/04 service line reactivated - DL disconnected line + reconnected at point 3' from main - No stoppage in line

CONSTRUCTION RECORD

SERVICE RECORD

STATION	ELEVATION		Depth	MANHOLE	4-INCH "Y" BRANCHES		No. of Permit		House Number		DATE OF PERMITS	
	Ground	Grade			North West	South East	North West	South East	North West	South East	North West	South East
LATERAL 16 MAIN 3 SOUTHWEST INTERCEPTOR												
0+00	89.1	80.95	8.2	EXISTING	0+38.100	0+33.07	17784	20516	4325	4220	2-11-87	61387
1+00	88.5	81.25	7.3									
2+00	88.6	81.55	7.1		2+64.9	2+84.3	99-13397 1341	11462	1325 Hards	1260 Uilm	6-22-99 9-23-80	7-19-84
3+00	88.0 88.1	81.85 81.90	6.2 6.2	3+18.8	4"STUB N	4"STUB S	99-133607 370	11461	1319 S	1250 Uilm	6-22-99 9-23-80	7-13-84
4+00	88.3	82.15	6.2		4+43.8	4+09.8	99-133647 1339	24032	1313 S	1222 Uilm	6-22-99 9-23-80	10-5-89
5+00	88.4	82.45	6.0		4+94.7	4+67.8	99-13365 538	24032	1303 S	1218 Uilm	6-22-99 9-23-80	10-5-89
6+00	88.7 88.8	82.75 82.87	6.0 5.9	6+39.6	5+42.4	5+00.6	99-13367 1337	24034	1214 S	1214 Uilm	6-22-99 9-23-80	10-5-89
7+00	89.3	83.05	6.3		6+45.9	6+12.6	99-13370 1336	24484	1214 S	1202 Uilm	6-22-99 9-23-80	10-19-89
8+00	89.2	83.35	5.9		7+12.0	7+73.4	99-133727 276739	276933	1213 S	1138 Uilm	6-22-99 3-10-80	3-19-80
9+00	88.4 88.5	83.65 83.84	4.8 4.7	9+63.0	6"STUB N	6"STUB S	99-133687 127870	4887	1125 S	1214 Uilm	6-22-99 5-27-92	12-9-81
LATERAL 25 MAIN 4 SOUTHWEST INTERCEPTOR												
LINE 1 0+00	138.4	131.19	7.2	EXISTING								
1+00	138.2	131.46	6.7									
2+00	139.0 139.4	131.72 131.89	7.3 7.4	2+63.0								
3+00	138.4	132.09	6.3									
4+00	138.7 140.1	132.35 132.52	6.4 7.6	4+63.2								
5+00	140.0	132.62	7.4									
6+00	140.8 141.0	132.89 133.19	7.9 7.8	6+76.7								
7+00	140.7 141.6	133.25 133.42	7.5 8.1	7+66.5								
8+00	141.6	133.61	8.0									
9+00	141.8 142.6	133.88 134.08	7.9 8.5	9+38.1								
10+00	143.3	134.26	9.0									
11+00	143.4 143.0	134.56 134.75	8.8 8.3	11+65.0								
12+00	142.8	134.86	7.9									
13+00	142.0	135.16	6.8									
14+00	143.2 143.2	135.46 135.48	7.7 7.7	14+06.6								
15+00	142.8	135.76	7.0									
16+00	143.2 142.8	136.06 136.11	7.1 6.7	16+19.1								
17+00	141.4	136.37	5.0									

1125 w 42nd STS that 1325 w 42nd ST S. - (9 permits) all written under common address of 1207 w 42nd ST S.  
 99-00 817 9/30/99 1222 w Uilm (oris house destroyed by tornado in 1999) - McCullagh