


LATERAL 31 DIST B SS N^o20
 BUILT BY: MID STATES CONST. CO.
 PROJ. N^o 468 76 245 80505 000 000 001
 BOOKED 6-16-78 FROM SRL 11

*2012 P
 2/11/11*

SCALE 1"=150'

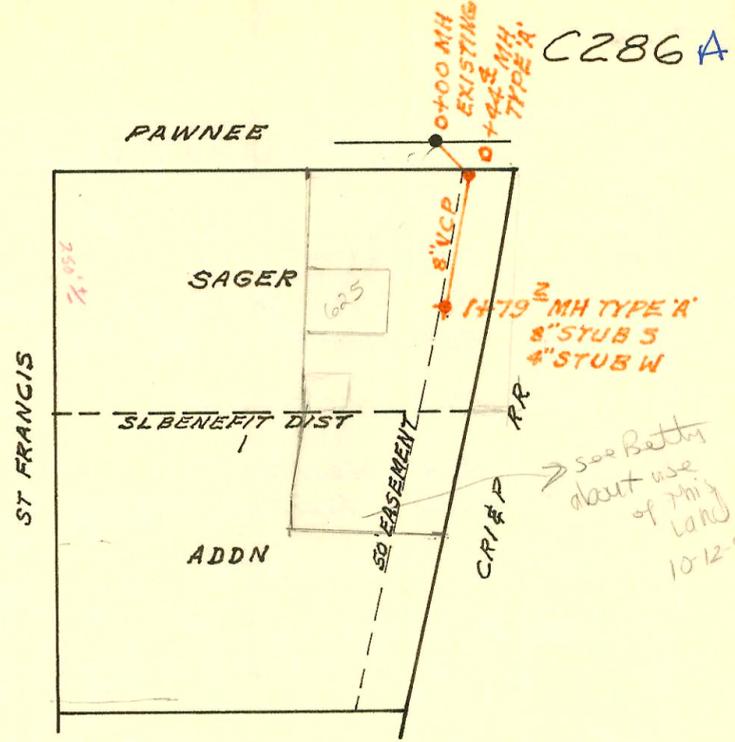


C286A

see Betty about use of this land 10-12-94


~~SAN SEWER EXTENSION TO SOUTH 150' OF LOT 1 SMYSER ACRES
 BUILT BY: DAROLD HILL
 PROJ. N^o DBKW 706030
 BOOKED 6-26-78 FROM CG15
 (SEE L50)~~

SCALE 1"=150'

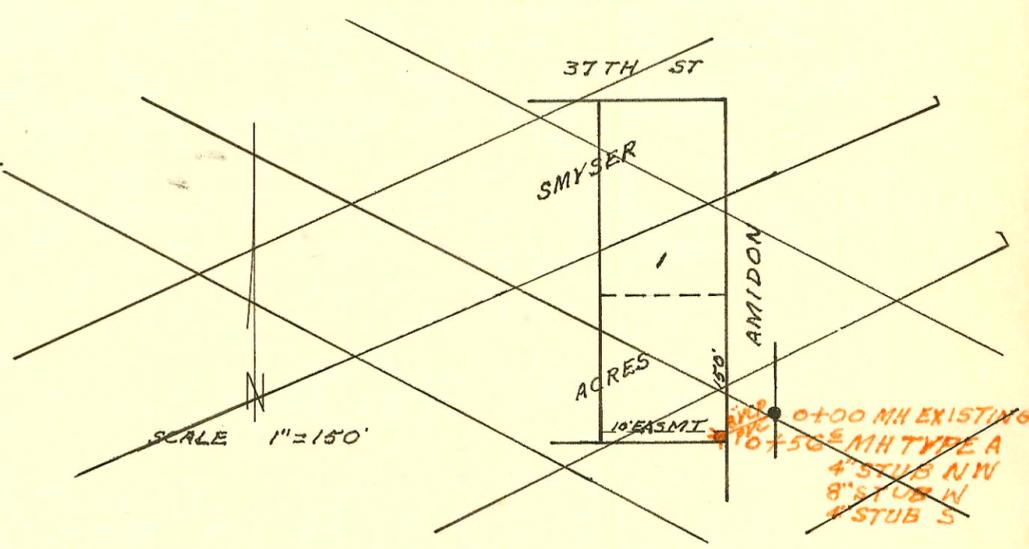

LATERAL 7 MAIN 14 SAN SEWER N^o22
 BUILT BY: UTILITY CONTR. INC.
 PROJ. N^o DBKL 577097
 BOOKED 6-27-78 FROM CG15

SCALE 1"=150'

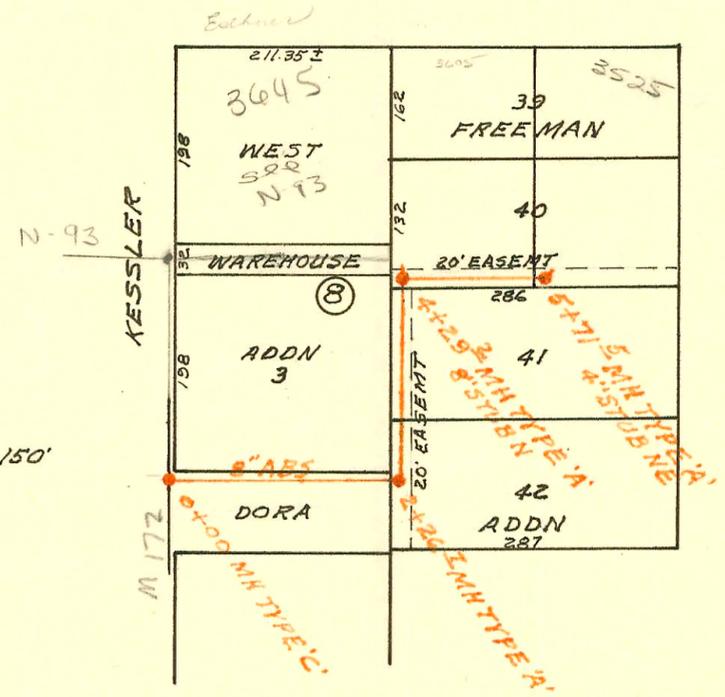

CONSTRUCTION RECORD

SERVICE RECORD

STATION	ELEVATION		Depth	MANHOLE	4-INCH "Y" BRANCHES		No. of Permit		House Number		DATE OF PERMITS	
	Ground	Grade			North West	South East	North West	South East	North West	South East	North West	South East
LAT 25 MAIN 4 SW 1 (Cont)												
LINE 1 CONT	18+00	141.6	136.67	4.9								
		141.6	136.77	4.8	18+34.0							
LINE 2	0+00	142.8	136.21	6.6	0+00=16+19.1 LINE 1							
	1+00	143.0	136.61	6.4								
	2+00	142.9	137.01	5.9								
		143.0	137.17	5.8	2+40.2	6" STUB W	6" STUB S 6" STUB E		2000-02434 269811	5704 w. 510 Kallagy	11-9-00 12-14-78	
LINE 3	0+00	141.6	136.87	4.7	0+00=18+34.0 LINE 1							
	1+00	142.3	137.17	5.1	0+90.6			C 66800		1208 S/D 5" Kallagy	6-13-78	
		143.44	136.99		1+30.0	6" stub SW 137.22		9910397		1204 N/C 74' K	5-24-99	
	2+00	142.7	137.47	5.2								
		143.5	137.65	5.9	2+59.1	6" STUB SW	6" STUB S 6" STUB SE	153 95 88327 68656 68657		90 Kallagy	4-25-91 10-2-78	6-14-95 9-2-78
LINE 4	0+00	138.4	131.19	7.2	0+00=0+00 LINE 1							
		138.2	131.36	6.8	0+56.5	6" STUB SW	6" STUB SE					
LATERAL 31 DIST B 55 N^o 20												
	0+00	96.0	89.28	6.7	0+00 EXISTING							
		96.0	89.45 89.55	6.6 6.5	0+44.4							
	1+00	96.1	89.78	6.3								
		96.3	90.10	6.1	1+79.2	4" STUB W	8" STUB S	C 66701		625 E. Panner	6-9-78	
SAN SEWER EXTENSION TO S150' LOT 1 SMYSER ACRES												
	0+00	133.4	124.04	9.4	0+00 EXISTING							
		132.7	124.26	8.4	0+56.6	4" STUB NW	4" STUB S					
LATERAL 7 MAIN 14 SAN SEWER N^o 22												
	0+00	108.4	99.80	8.6	0+00							
	1+00	108.5	100.20	8.3								
	2+00	108.5	100.60	7.9								
		109.0	100.71 100.81	8.3 8.2	2+26.7							
	3+00	108.3	101.10	7.2								
	4+00	108.0	101.50	6.5								
		108.0	101.62	6.4	4+29.2	8" STUB N						
	5+00	108.0	102.00	6.0								
		109.8	102.29	7.5	5+71.5	4" STUB NE		C 66674	3525 Gillman		6-2-78	