


SCALE 1"=150'

LATERAL 112, SOUTHWEST INTERCEPTOR SEWER  
 BUILT BY: SHAWNEE CONST. CO.  
 PROJ. NO DBKL 577052  
 BOOKED 7-27-78 FROM G6

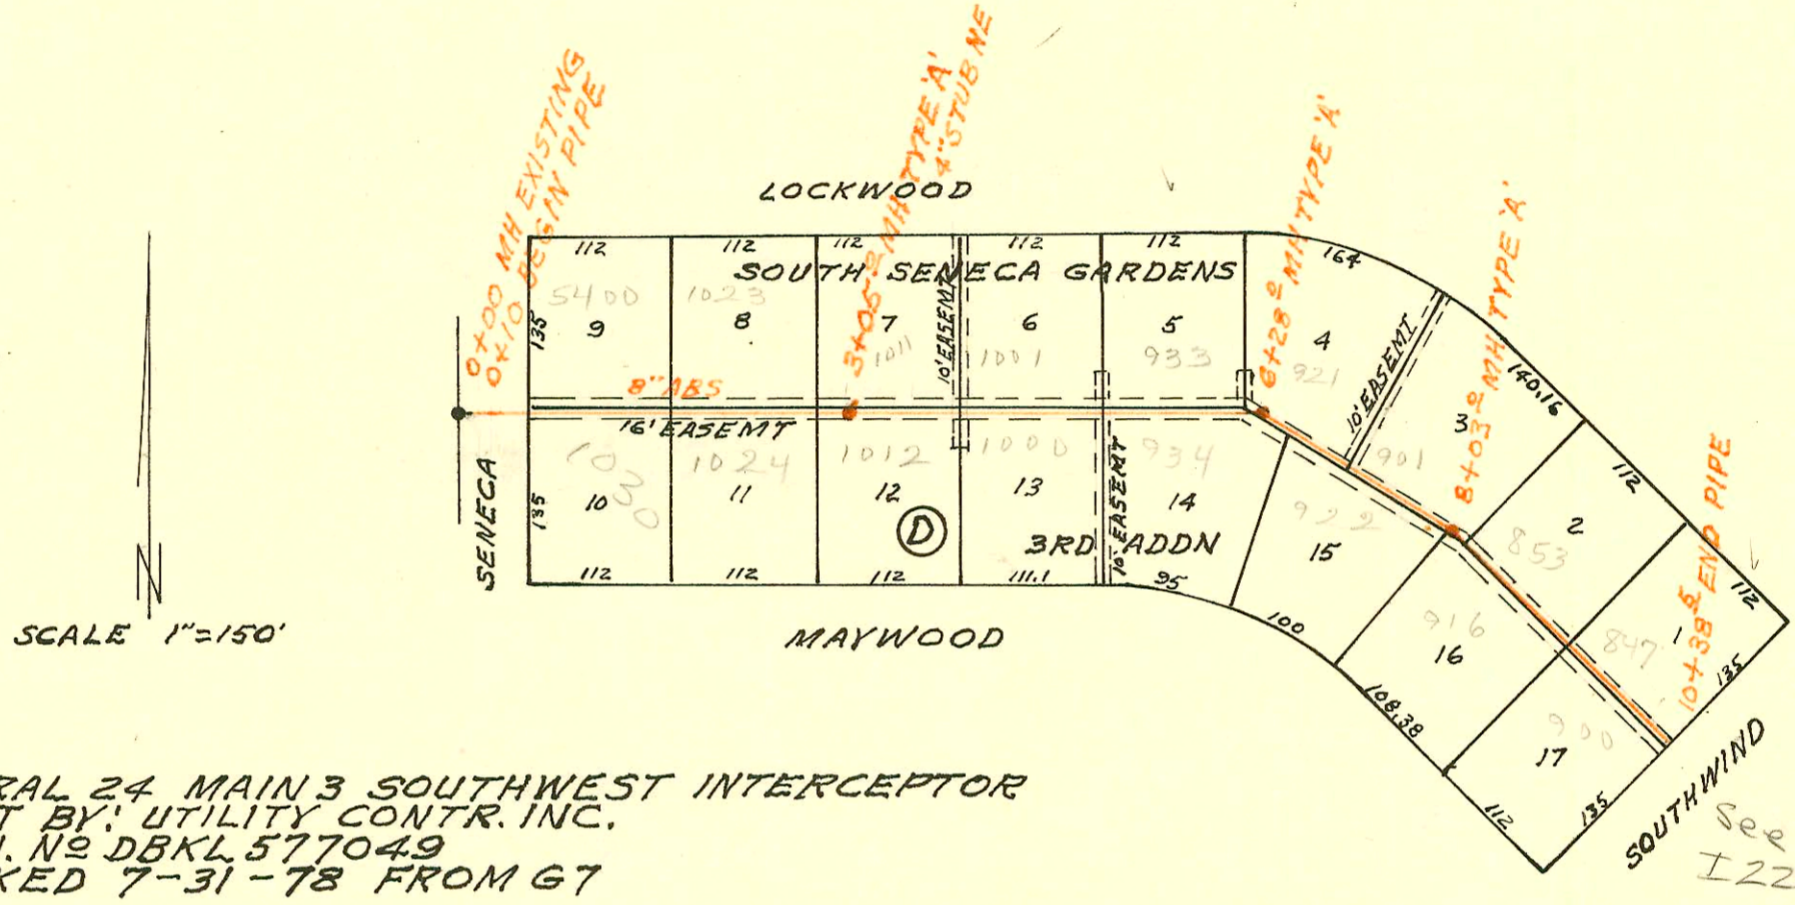

SCALE 1"=150'

LATERAL 24 MAIN 3 SOUTHWEST INTERCEPTOR  
 BUILT BY: UTILITY CONTR. INC.  
 PROJ. NO DBKL 577049  
 BOOKED 7-31-78 FROM G7

See I 223

