

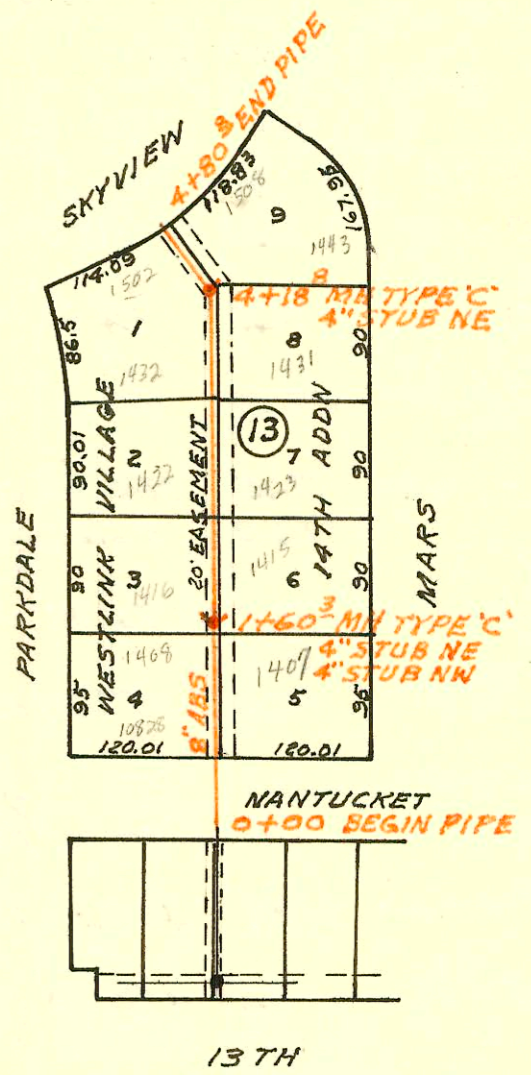
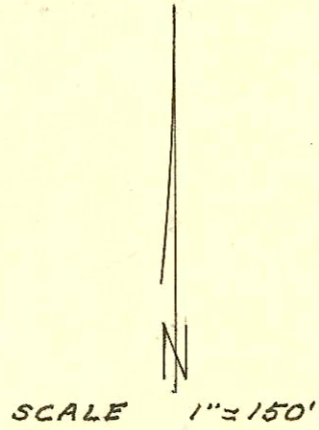
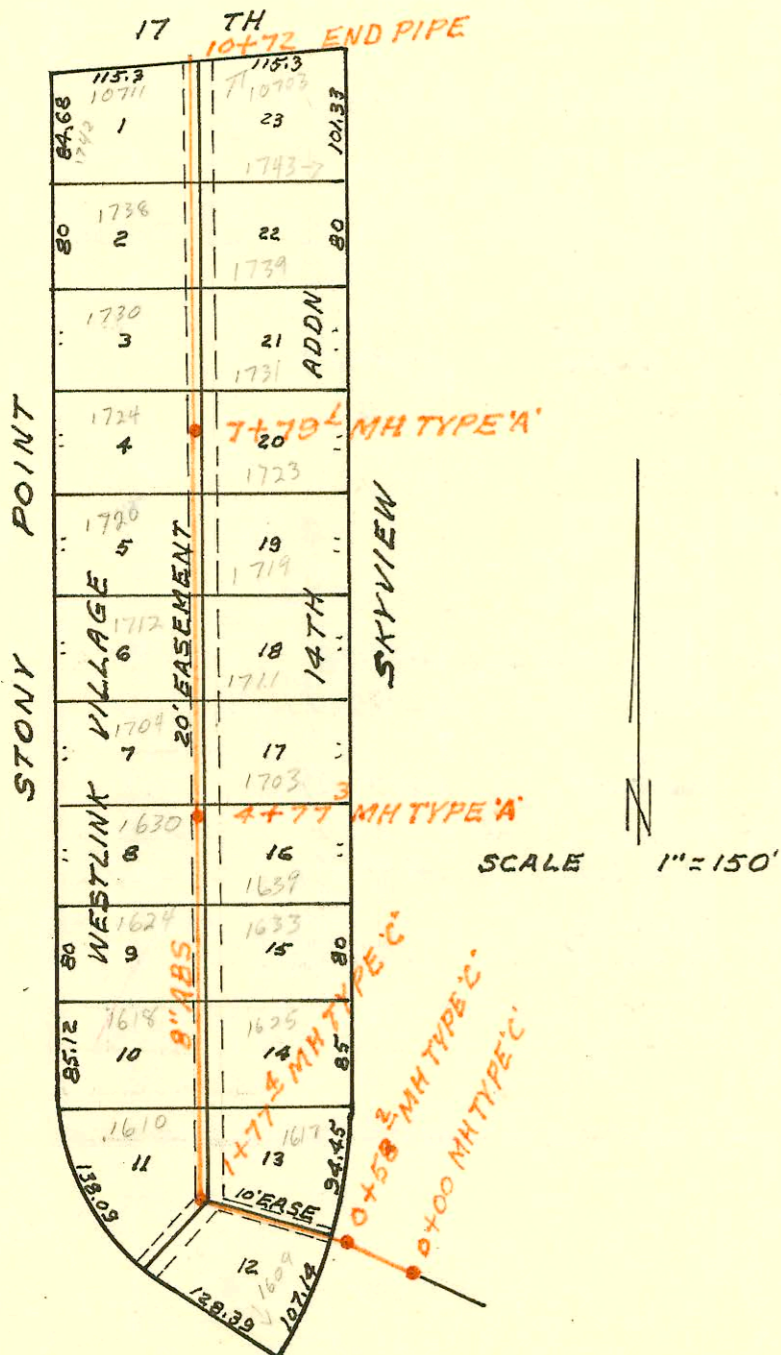


LATERAL 101 SOUTHWEST INTERCEPTOR SEWER  
 BUILT BY: UTILITY CONTR. INC.  
 PROJ. N<sup>o</sup> DBKL 577038  
 BOOKED 8-31-78 FROM LES 10A  
 on map

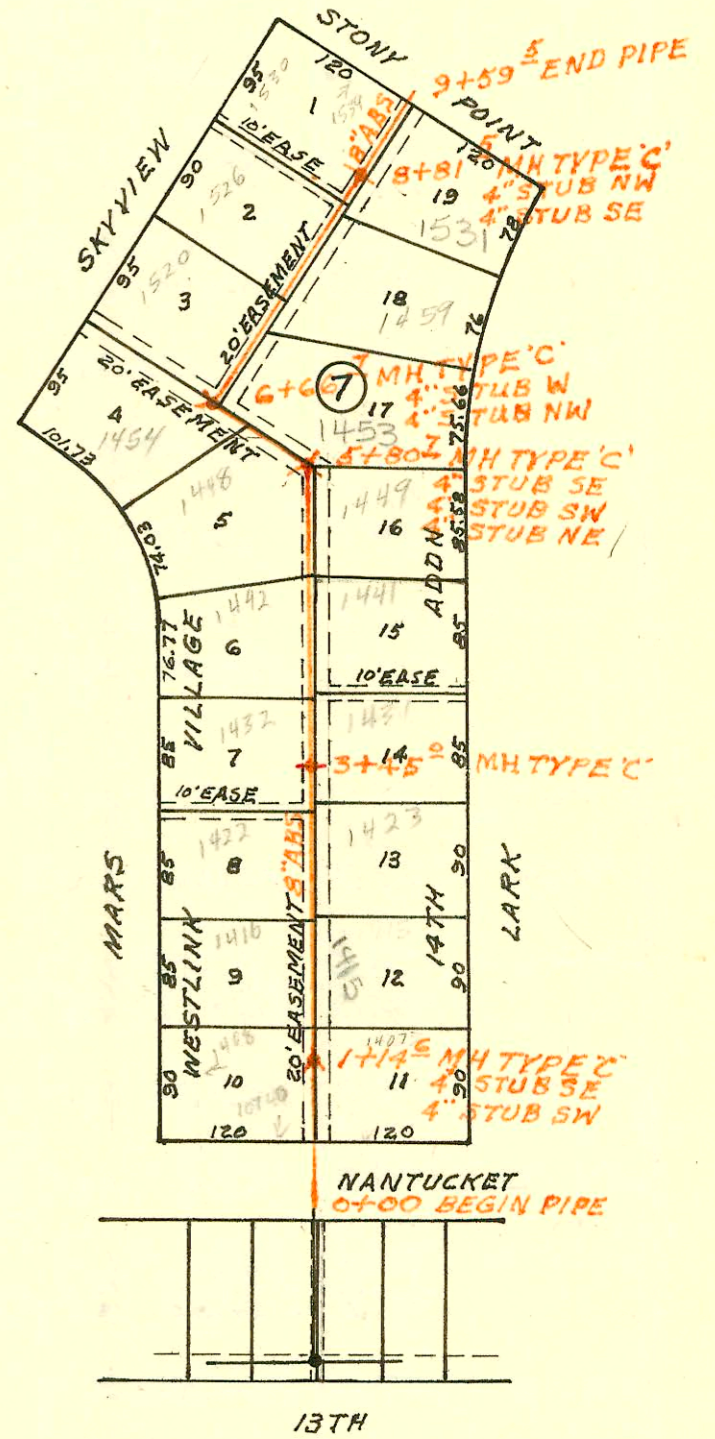

LATERAL 105 SOUTHWEST INTERCEPTOR SEWER  
 BUILT BY: UTILITY CONTR. INC.  
 PROJ. N<sup>o</sup> 468 76 245 80372 000 000 001  
 BOOKED 9-1-78 FROM LES 10A  
 on map

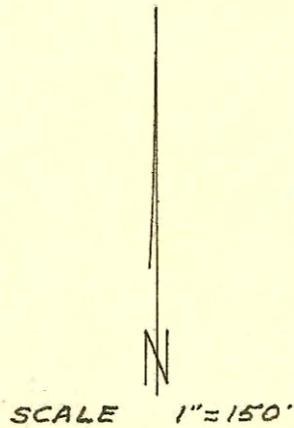

CONSTRUCTION RECORD

SERVICE RECORD

LATERAL 101 SOUTHWEST INTERCEPTOR SEWER

STATION	ELEVATION		Depth	MANHOLE	4-INCH "Y" BRANCHES		No. of Permit		House Number		DATE OF PERMITS	
	Ground	Grade			North West	South East	North West	South East	North West	South East	North West	South East
0+00	155.8	141.27	14.5									
1+00	156.3	141.67	14.6		RISER 0+67 W	RISER 0+64 E	C76320		1408 Parkdale		1-24-80	
	156.3	141.97	14.3	1+60.3	4" STUB NE	4" STUB NE	C71867		1407 Parkdale		5-21-79	
2+00	156.5	142.13	14.4		RISER 2+54 W	RISER 2+51 E	#01991 4322		1406 N. Parkdale		12-3-80	
3+00	156.7	142.53	14.2		RISER 3+42.5 W	RISER 3+38.5 E		425	1422 N. Parkdale	1423 Parkdale	12-12-81	6-2-80
4+00	157.0	142.93	14.1		RISER 3+70.5	RISER 3+63.4	C74374	C71947	1502 Skyview	1431 Parkdale	9-19-79	5-22-79
	157.2	143.11	14.1	4+18.8	4" STUB NE			C72791		1508 Skyview		7-6-79
4+80.8	157.7	143.36	14.3									

LATERAL 105 SOUTHWEST INTERCEPTOR SEWER

0+00	157.0	142.09	14.9									
1+00	157.0	142.49	14.5					1022	1407 Park			8-20-80
	157.1	142.55	14.6	1+14.6	4" STUB SW	4" STUB SE	C73504		1408 Park		8-8-79	
2+00	157.1	142.89	14.2		RISER 2+35 W	RISER 2+41 E	C74602		1416 Park		10-2-79	
3+00	156.9	143.29	13.6		RISER 2+62.7	RISER 2+88.6	C74630	C73495	1422 Park	1415 Park	10-3-79	8-8-79
	156.8	143.47	13.3	3+45.0	4" West Stub	4" East Stub	C72498	3469	1432 Park	1431 Park	6-22-79	6-9-81
4+00	156.8	143.69	13.1		RISER 4+11 W	RISER 4+21 E	2865	835	1442 Park	1441 Park	3-18-81	7-24-80
5+00	157.1	144.09	13.0			RISER 5+06 E			1453 Park	1449 Park	3-9-79	3-19-79
	157.0	144.51	12.5	5+80.7	4" STUB NE	4" STUB SW	C70543	C70723	1448 N. Park		7-2-79	
6+00	157.0	144.59	12.4		4" STUB W	4" STUB NW	C73633		1454 Park		8-15-79	
7+00	157.0	145.09	11.9		RISER 7+67 W	RISER 7+73 E	C72502	#02190	1520 Skyview	1459 N. Park	6-22-79	1-27-81
8+00	157.1	145.49	11.6		RISER 7+30.4	RISER 7+79.5	#00392		1526 Skyview		5-19-80	
	157.2	145.81	11.4	8+81.5	4" STUB NW	4" STUB SE	C71579	C70722	1530 Skyview	1531 Skyview	5-2-79	3-19-79
9+00	157.4	145.89	11.5									
9+59.5	157.5	146.10	11.4									

LATERAL 93 SOUTHWEST INTERCEPTOR

0+00	159.1	148.17	10.9	0+00								
	159.0	148.42	10.6	0+60								
1+00	157.7	148.57	9.1					8241	1609 Skyview			6-13-83
	158.5	148.99	9.6	1+77.4				8877	1617 Skyview			8-9-83
2+00	158.7	149.07	9.6		2+02.4		7580		1610 Skyview		3-3-83	
3+00	158.7	149.47	9.2		2+76.0	2+57.0	7461	8758	1618 N. Skyview	1625 Skyview	2-14-83	7-21-83
4+00	159.0	149.87	9.1		3+60.8	3+68.4	4982	7455	1624 Skyview	1630 N. Skyview	12-29-81	4-27-83
	159.2	150.19	9.0	4+77.3	4+40.3	4+37.8	#02178	8342	1630 N. Skyview	1639 N. Skyview	1-26-81	6-13-83
5+00	159.3	150.27	9.0		5+18.1	5+41.8	4527	9560	1704 Skyview	1703 Skyview	10-29-81	10-31-83
6+00	159.5	150.67	8.8		5+37.3		8510		1712 Skyview	1711 N. Skyview	6-24-83	8-19-83
7+00	159.7	151.07	8.6		6+67.5	6+25.1	8071	9028	1720 Skyview		5-9-83	
	160.2	151.31	8.9	7+79.1	7+50.3	7+73.1	2086	C70658	1721 Skyview	1723 Skyview	12-12-80	3-17-80
8+00	160.2	151.47	8.7		8+33.1	8+37.8	2087	1487	1730 Skyview	1731 Skyview	12-12-80	4-15-80
9+00	160.7	151.87	8.8		9+18.0	9+109.0	2507	2508	1736 Skyview	1737 Skyview	1-28-81	1-28-81
10+00	161.3	152.27	9.0		9+81.0		2088		1742 Skyview		12-12-80	
10+72	161.1	152.56	8.5			10+06.0		3089	1743 Skyview		12-12-80	