


LATERAL 221 MAIN 5 SS N^o22
BUILT BY: ARKANSAS CONST. CO.
PROJ. N^o DBKL576016
BOOKED 9-14-78 FROM CLG03

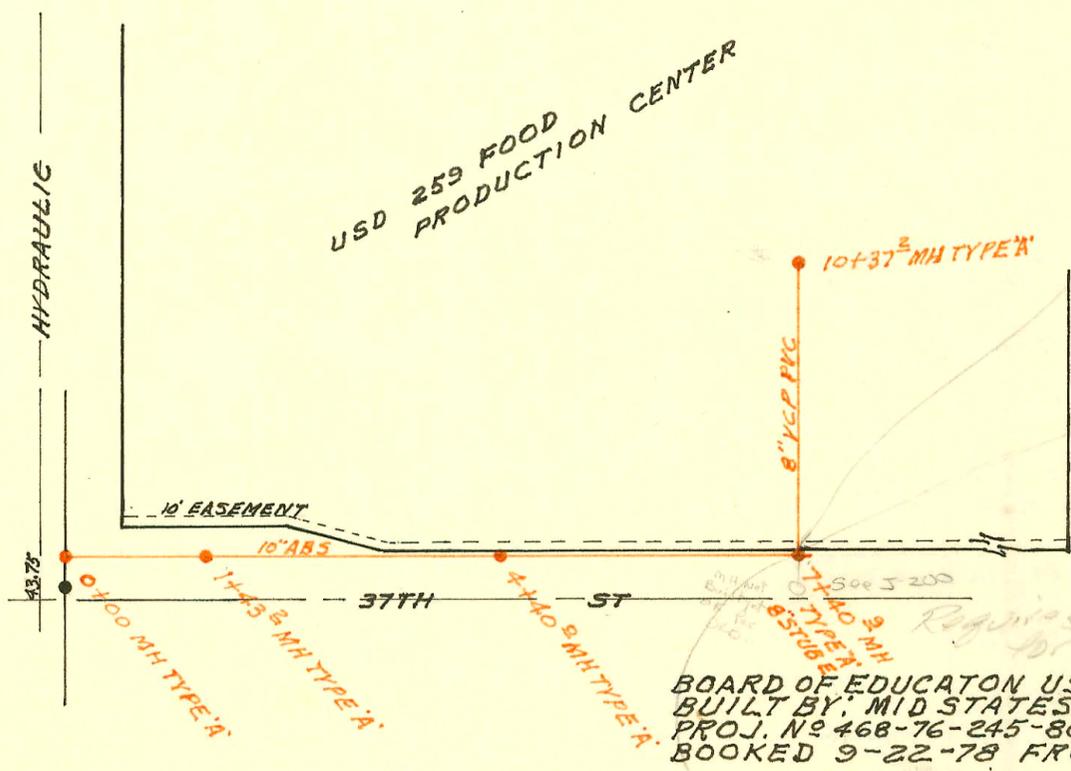

2100 E 37TH N
MH TOP OK
Per Buddy Smith, Water Dept
11-28-94

see H/W Map

outside city app on file
2402 E 37th
Ties into MH 1740.9 with 2 1/2" Force main. This line is maintained by owner not city
11/19/92 OR

SCALE 1"=150'

BOARD OF EDUCATION USD 259 FOOD PROD CENTER
BUILT BY: MID STATES CONST. CO.
PROJ. N^o 468-76-245-80495-000-000-008
BOOKED 9-22-78 FROM MRT2

No further connection to this MH. Must extend LHM sewer
OK
1-30-98

CONSTRUCTION RECORD

SERVICE RECORD

STATION	ELEVATION		Depth	MANHOLE	4-INCH "Y" BRANCHES		No. of Permit		House Number		DATE OF PERMITS			
	Ground	Grade			North West	South East	North West	South East	North West	South East	North West	South East	North West	South East
LAT 12 MAIN 7 55 N ^o 23 (CONT)														
LINE 2A 0+00	177.7	164.50	13.2	0+70.6	4" STUB W	4" STUB SE	683	683	3114 Brookfield	3107 Bayberry	10-12-78	7-2-80		
	178.2	164.78	13.4	0+70.6	4" STUB W	4" STUB SE	#469	#469	3106 Brookfield	3103 Bayberry		6-6-80		
LINE 3 0+00	174.0	161.32	12.7	0+00=2+92	mt. Sep	mt. Sep	C71738	C71744	3129 Brookfield	3115 Brookfield	5-14-79	5-14-79		
1+00	173.0	161.72	11.3						3109 Brookfield			5-14-79		
2+00	172.5	162.12	10.4											
	172.5	162.21	10.3	2+23.1	4" STUB W	8" STUB S 4" STUB E	C69707	C69763	6436 30th St. Brookfield	3103 Brookfield	10-4-78	10-12-78		
LATERAL 221 MAIN 5 SANITARY SEWER N ^o 22														
0+00	129.2	119.44	9.8	0+80.5			C68447		1603 Harlan		9-22-78			
	129.5	119.76	9.7				C68498		1607 Harlan		9-22-78			
1+00	129.5	119.82	9.7				C69553		1613 Harlan		11-28-78			
2+00	129.8	120.12	9.7				C71040		1617 Harlan		4-5-79			
3+00	130.2	120.42	9.8	3+90.6			C72505		1621 Harlan		6-22-79			
	130.4	120.69	9.7											
4+00	130.4	120.72	9.7				C73564		1625 Harlan		8-13-79			
							C74549		1629 Harlan		9-28-79			
5+00	130.7	121.02	9.7											
6+00	130.7	121.32	9.4				C76884		1633 Harlan		2-29-80			
							C2075		1639 Harlan		12-12-80			
7+00	130.8	121.62	9.2	7+00			3029		1643 Harlan		7-7-81			
							8378		1647 Harlan		5-28-81			
8+00	131.0	121.92	9.1											
9+00	131.2	122.22	9.0				6083		1651 Harlan		7-1-82			
							7880		1655 Harlan		4-20-83			
10+00	131.4	122.52	8.9	10+20.2	4" STUB W									
	131.4	122.58	8.8											
BOARD of EDUCATION FOOD PROD CTR 55														
0+00	137.6	130.77	6.8	0+00										
1+00	135.6	130.97												
	135.6	131.06	4.5	1+43.2										
2+00		131.17												
3+00		131.37												
4+00		131.57												
	139.0	131.65	7.4	4+40.0										
5+00		131.77												
6+00		131.97												
7+00	139.0	132.17	6.8	7+40.9										
		132.25	6.5											
		132.50												
8+00		133.78												
9+00		135.94												
10+00		138.10												
	146.0	138.90	7.1	10+37.2										
<p>add 5182467 2416 E 37th St</p> <p>5106-3629 N. Hydraulic 1-25-82 Marty Wenzinger</p>														