


LATERAL 59 WAR INDUSTRIES SEWER
BUILT BY: UTILITY CONTR. INC.
PROJ. NO 468-76-245-80429-000-001
BOOKED 10-20-78 FROM SRL 5

SCALE 1"=150'



Lots 10-13
 P&L 3rd Add
 Do Not Issue
 any sewer permits
 to connect to
 existing sewer
 conditions of plat
 extend to plat
 there is a partition
 on file in
 Eng office
 BK
 9/24/81

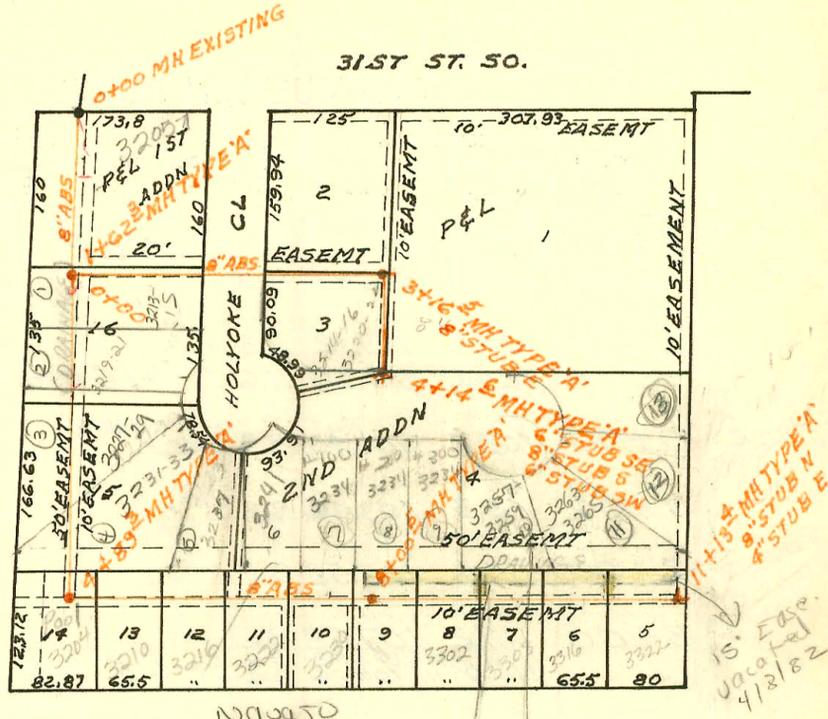