


FOX RUN SAN SEWER BLK 5 QUAIL MEADOWS 2ND ADDN
BUILT BY: UTILITY CONTR. INC
PROJ. N^o DBKW 707086
BOOKED 10-24-78 FROM AR85


SCALE 1" = 200'

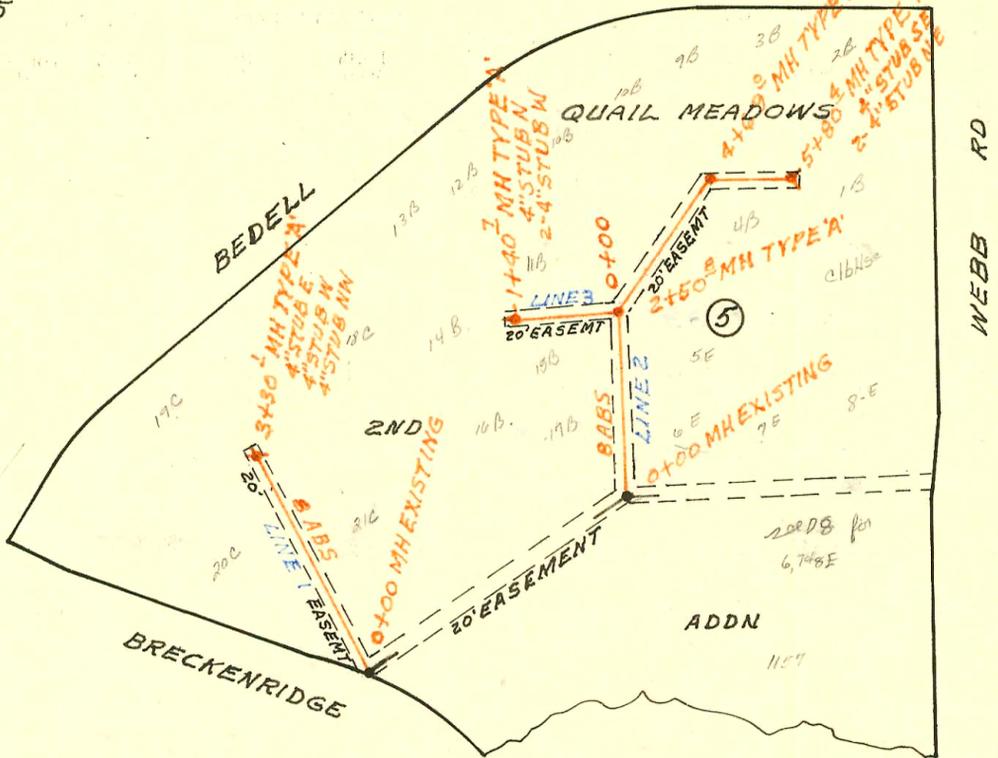

LATERAL 60 WAR INDUSTRIES SEWER
BUILT BY: UTILITY CONTR. INC.
PROJ. N^o 468-76-245-80540-000-001
BOOKED 10-24-78 FROM JLA 28

SANITARY SEWER RECONSTRUCTION IN
CONNECTION WITH WATER LINE EXTENSIONS
ON 31ST STREET SOUTH - K-15 TO TURNPIKE
PROJ. NO. 448-88682 (633016)
BUILT BY HOPPER CONST. CO.
BOOKED 9-7-95 AS PER PLAN

SCALE 1" = 150'

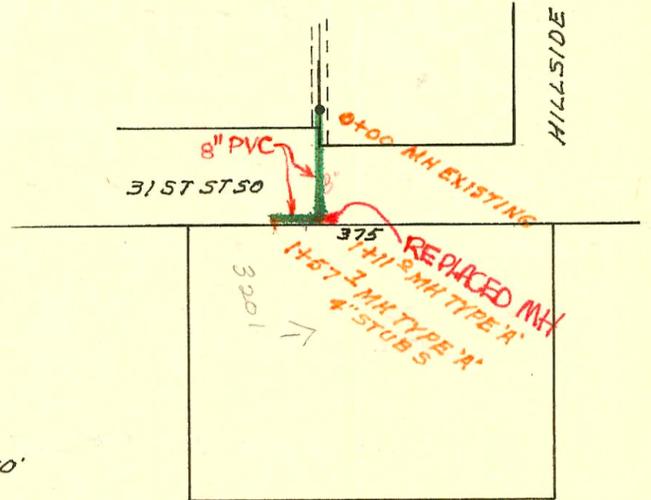

LATERAL 16 MAIN 10 WAR INDUSTRIES SEWER
BUILT BY: UTILITY CONTR. INC.
PROJ. N^o 468-76-245-80514-000-001
BOOKED 10-25-78 FROM SLR 8

SCALE 1" = 150'

