


SCALE 1"=200'

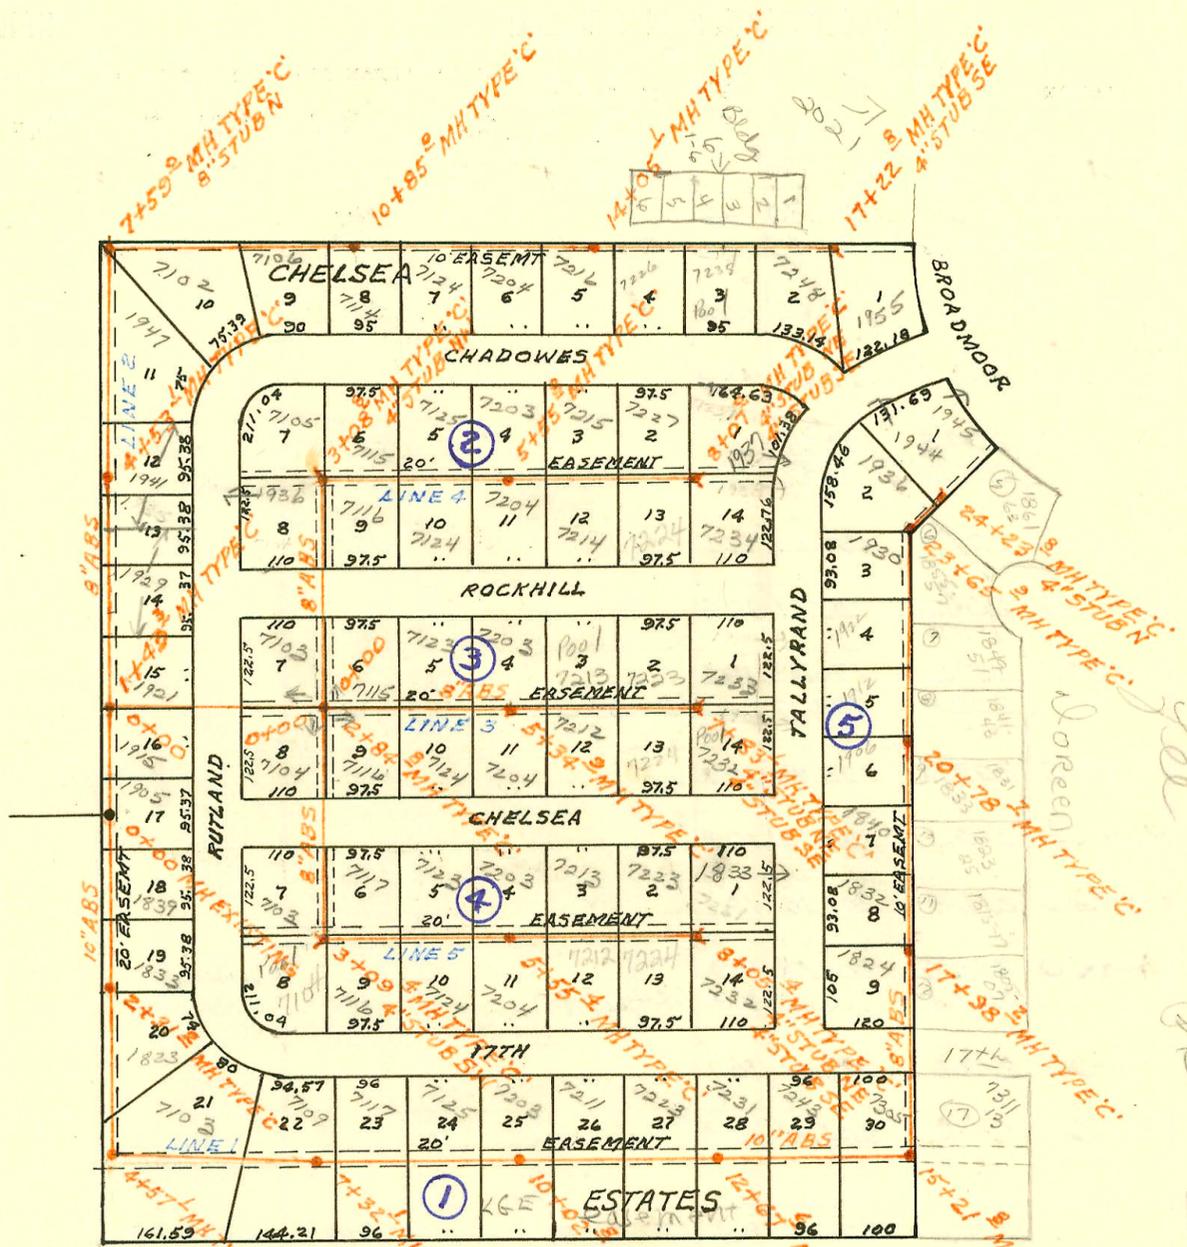

LATERAL 6 MAIN 20 WAR INDUSTRIES SEWER.  
 BUILT BY: MID STATES CONST. CO.  
 PROJ. N<sup>o</sup> DBKL 577060  
 BOOKED 11-4 -78 FROM 1H63

on map  
 12-38

*John S. ...*  
*120 Special*

CONSTRUCTION RECORD

SERVICE RECORD

STATION	ELEVATION		Depth	MANHOLE	4-INCH "Y" BRANCHES		No. of Permit		House Number		DATE OF PERMITS			
	Ground	Grade			North West	South East	North West	South East	North West	South East	North West	South East	North West	South East
LAT 6 MAIN 20 WIS (CONTD)														
LINE 2 (CONTD) 4+00	205.6	192.30	13.3											
	205.4	192.49	12.9	4+53.1										
5+00	205.2	192.65	12.6											
6+00	204.9	192.00	12.9											
7+00	204.8	193.35	11.5		4" SOR 35		92-45385-7		1947		12-17-92			
	205.0	193.26	11.3	7+59.0	6+170 TAP				Rutland					
8+00	205.3	194.23	11.1		8+48.0 TAP		20388		7102 E		3-16-81			
9+00	206.2	195.61	10.6						Chadours					
10+00	207.6	196.99	10.6				97-3457		7106 E		3-3-97			
	208.8	198.17	10.6	10+85.0					Chadours					
11+00	209.1	198.38	10.7		10+76 TAP		21626		7114 E		10-4-88			
12+00	210.1	199.78	10.3						Chadours					
					4" SOR 35		92-47689		7124		4-6-92			
13+00	211.3	201.18	10.1		12+07.0 tap				Chadours					
14+00	212.5	202.58	9.9											
	212.5	202.65	9.9	14+05.1	5+14+65.0		269591		7126		11-28-78			
15+00	213.5	203.41	10.1		8+75+95.8		269587		7237		11-28-78			
									Chadours					
16+00	214.2	204.21	10.0											
17+00	214.5	205.01	9.5						7248		6-4-97			
	214.6	205.19	9.4	17+22.8			97-8447		Chadours					
LINE 3 0+00	205.8	195.38	10.4	0+00=1+43.3	4" SOR 40		18048	2008	1921 N	1915	4-2-87	7-10-03		
				LINE 2	1+29.5			01823	Rutland	Rutland				
1+00	207.2	196.18	11.0											
2+00	209.0	196.98	12.0		2+30.8			C74045	7103		8-31-79			
	210.7	197.66	13.0	2+84.8	200.48				Rockhill					
3+00	211.0	200.60	10.4		3+30.8		7907		7115		4-21-93			
					3+43.4			C74048	Rock Hill					
4+00	212.5	201.40	11.1		4+32.9		7123	8976	7123	7116	12-7-82	8-31-79		
					4+28.9				Rockhill	Chelsea		8-12-83		
5+00	213.5	202.20	11.3		5+41.9		18282	91-34278-7	72035	7204	5-7-87	10-1-91		
	213.8	202.48	11.3	5+34.9	5+25.9 tap				Rockhill	Chelsea				
6+00	214.1	202.74	11.4		6+07.9		14019		7210		6-18-85			
7+00	214.4	203.14	11.3		7+36.1		C71843		7213		5-18-79			
	213.6	203.47	10.1	7+83.1	7+27.5		C71844	C72210	Rockhill	Chelsea	5-18-79	6-5-79		
				4" STUB NE	4" STUB SE		8499	C75016	Rockhill	Chelsea	6-23-83	10-23-79		
LINE 4														
0+00	210.7	198.80	11.9	0+00=2+84.8										
1+00	210.3	199.20	11.1	LINE 3										
2+00	209.9	199.60	10.3											
3+00	210.0	200.00	10.0		2+93.8		15532		1936		1-27-86			
	209.9	200.04	9.9	3+08.8	200.14				Rutland					
4+00	211.0	201.05	10.0		3+39.8		1572	17885	7195		1-17-86			
					4+35.8				Chadours	Rockhill	10-23-80	1-6-87		
5+00	212.5	202.05	10.5		4+79.8		21746		7115		1-2-87			
	213.2	202.61	10.6	5+55.8	5+63.8				Chadours	Rockhill		10-24-85		
6+00	213.6	203.05	10.6		5+61.8		94-731-7	6064	7203		1-18-94	6-28-82		
					6+53.8				Chadours	Rockhill				
					6+53.4		7124	25997	7215	7214	12-7-82	8-22-90		
									Chadours	Rockhill				

CONTD NEXT PAGE