


S.S. No. 20 MAIN

SCALE 1"=200'

* INSTALLED IN CONNECTION WITH
INC. DR ON LINCOLN
BY: MID STATES CONST. CO.
PROJ. N^o DAKD 574117

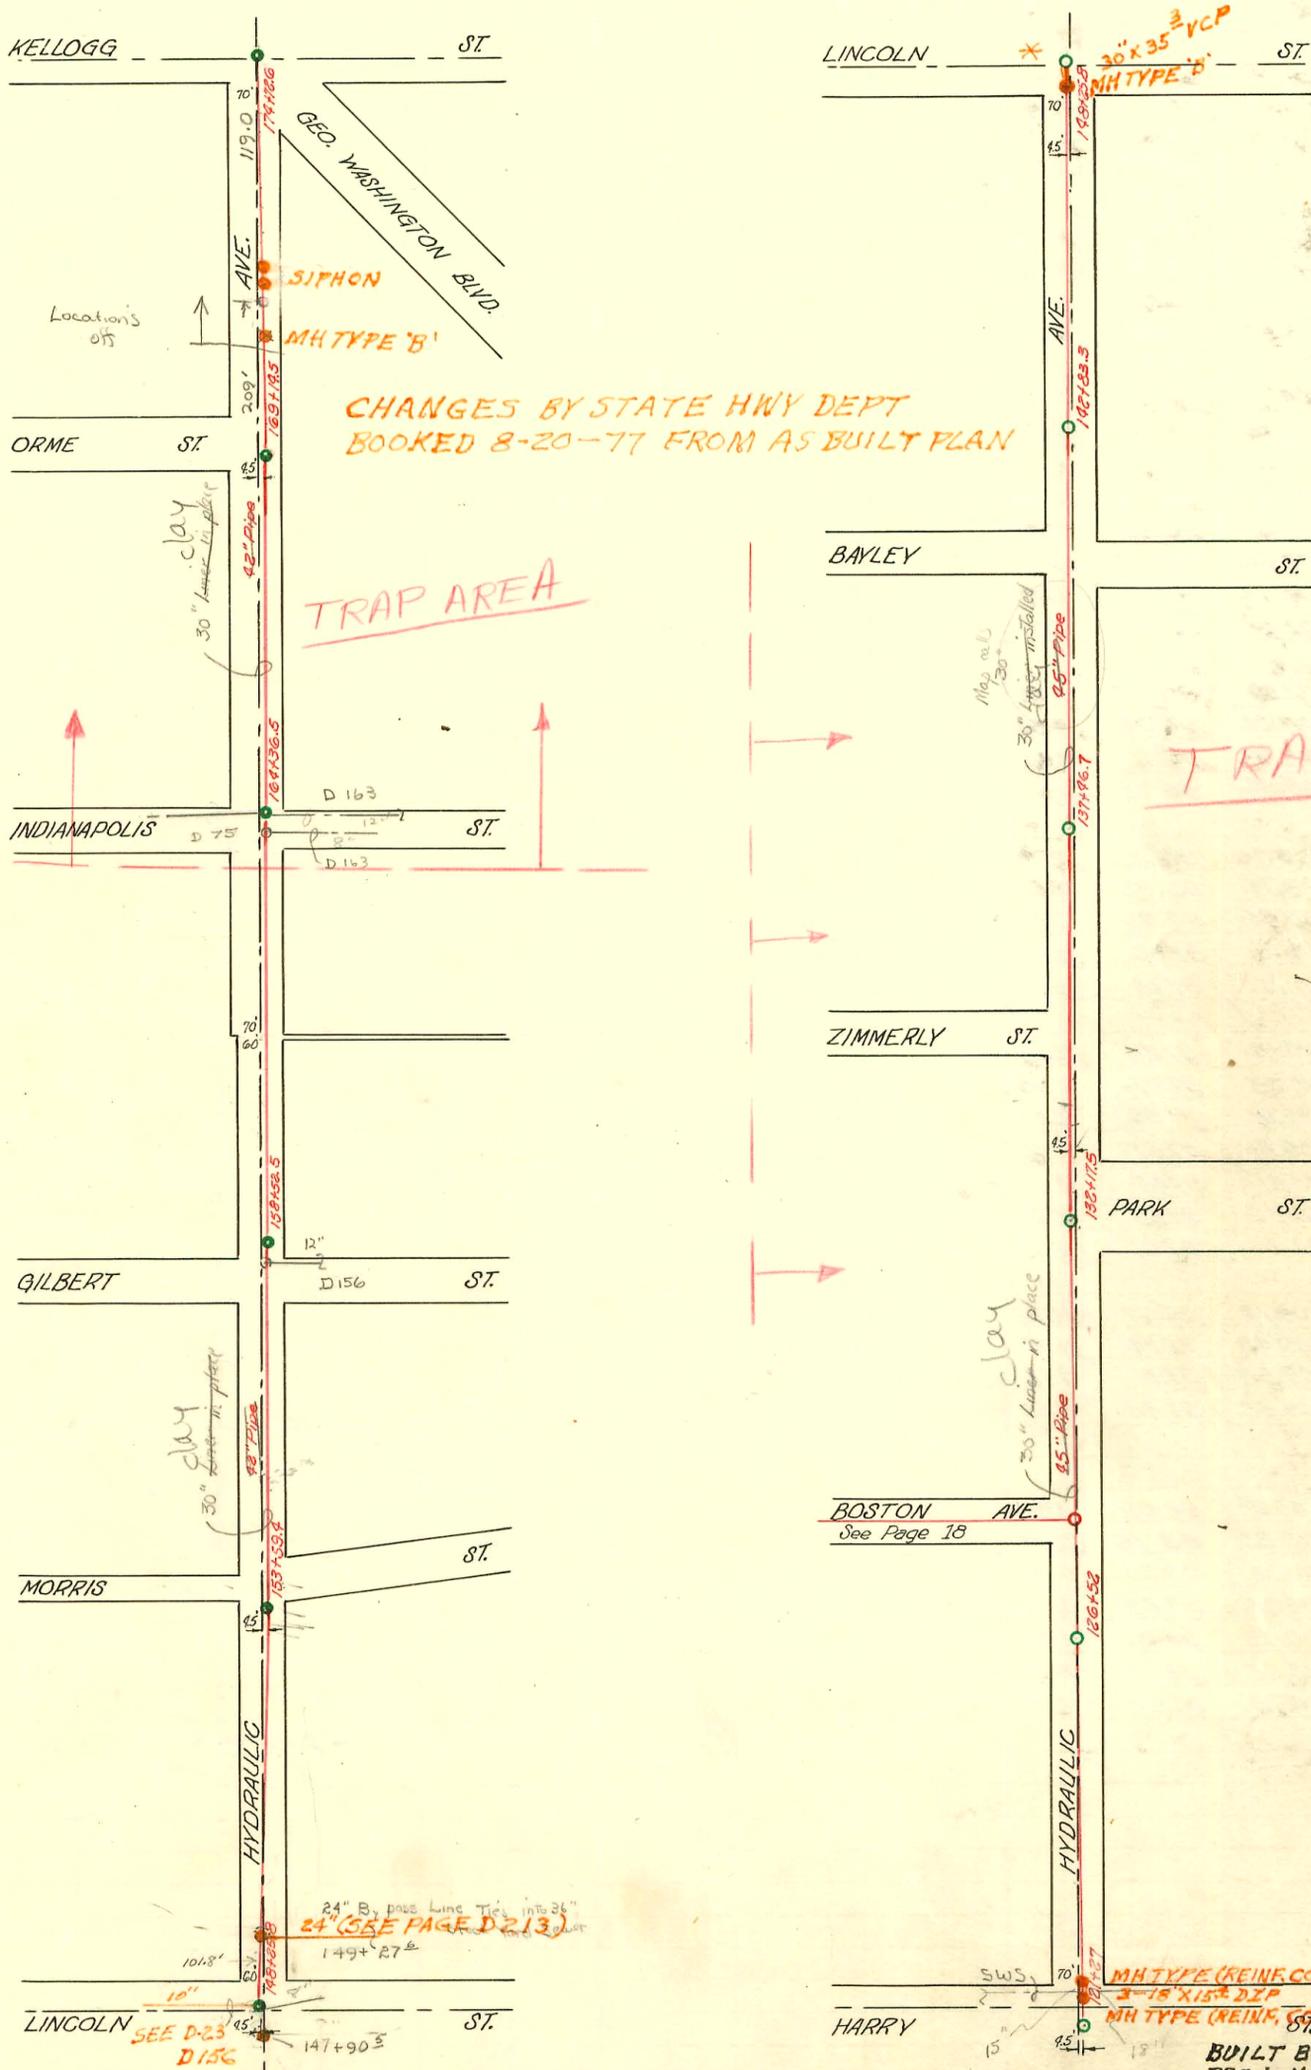

CHANGES BY STATE HWY DEPT
BOOKED 8-20-77 FROM AS BUILT PLAN

TRAP AREA

BUILT BY WB CARTER CONST. CO.
PROJ. N^o DAKD 576082
BOOKED 1-31-78 FROM SRL2

