


S.S. No. 20 MAIN

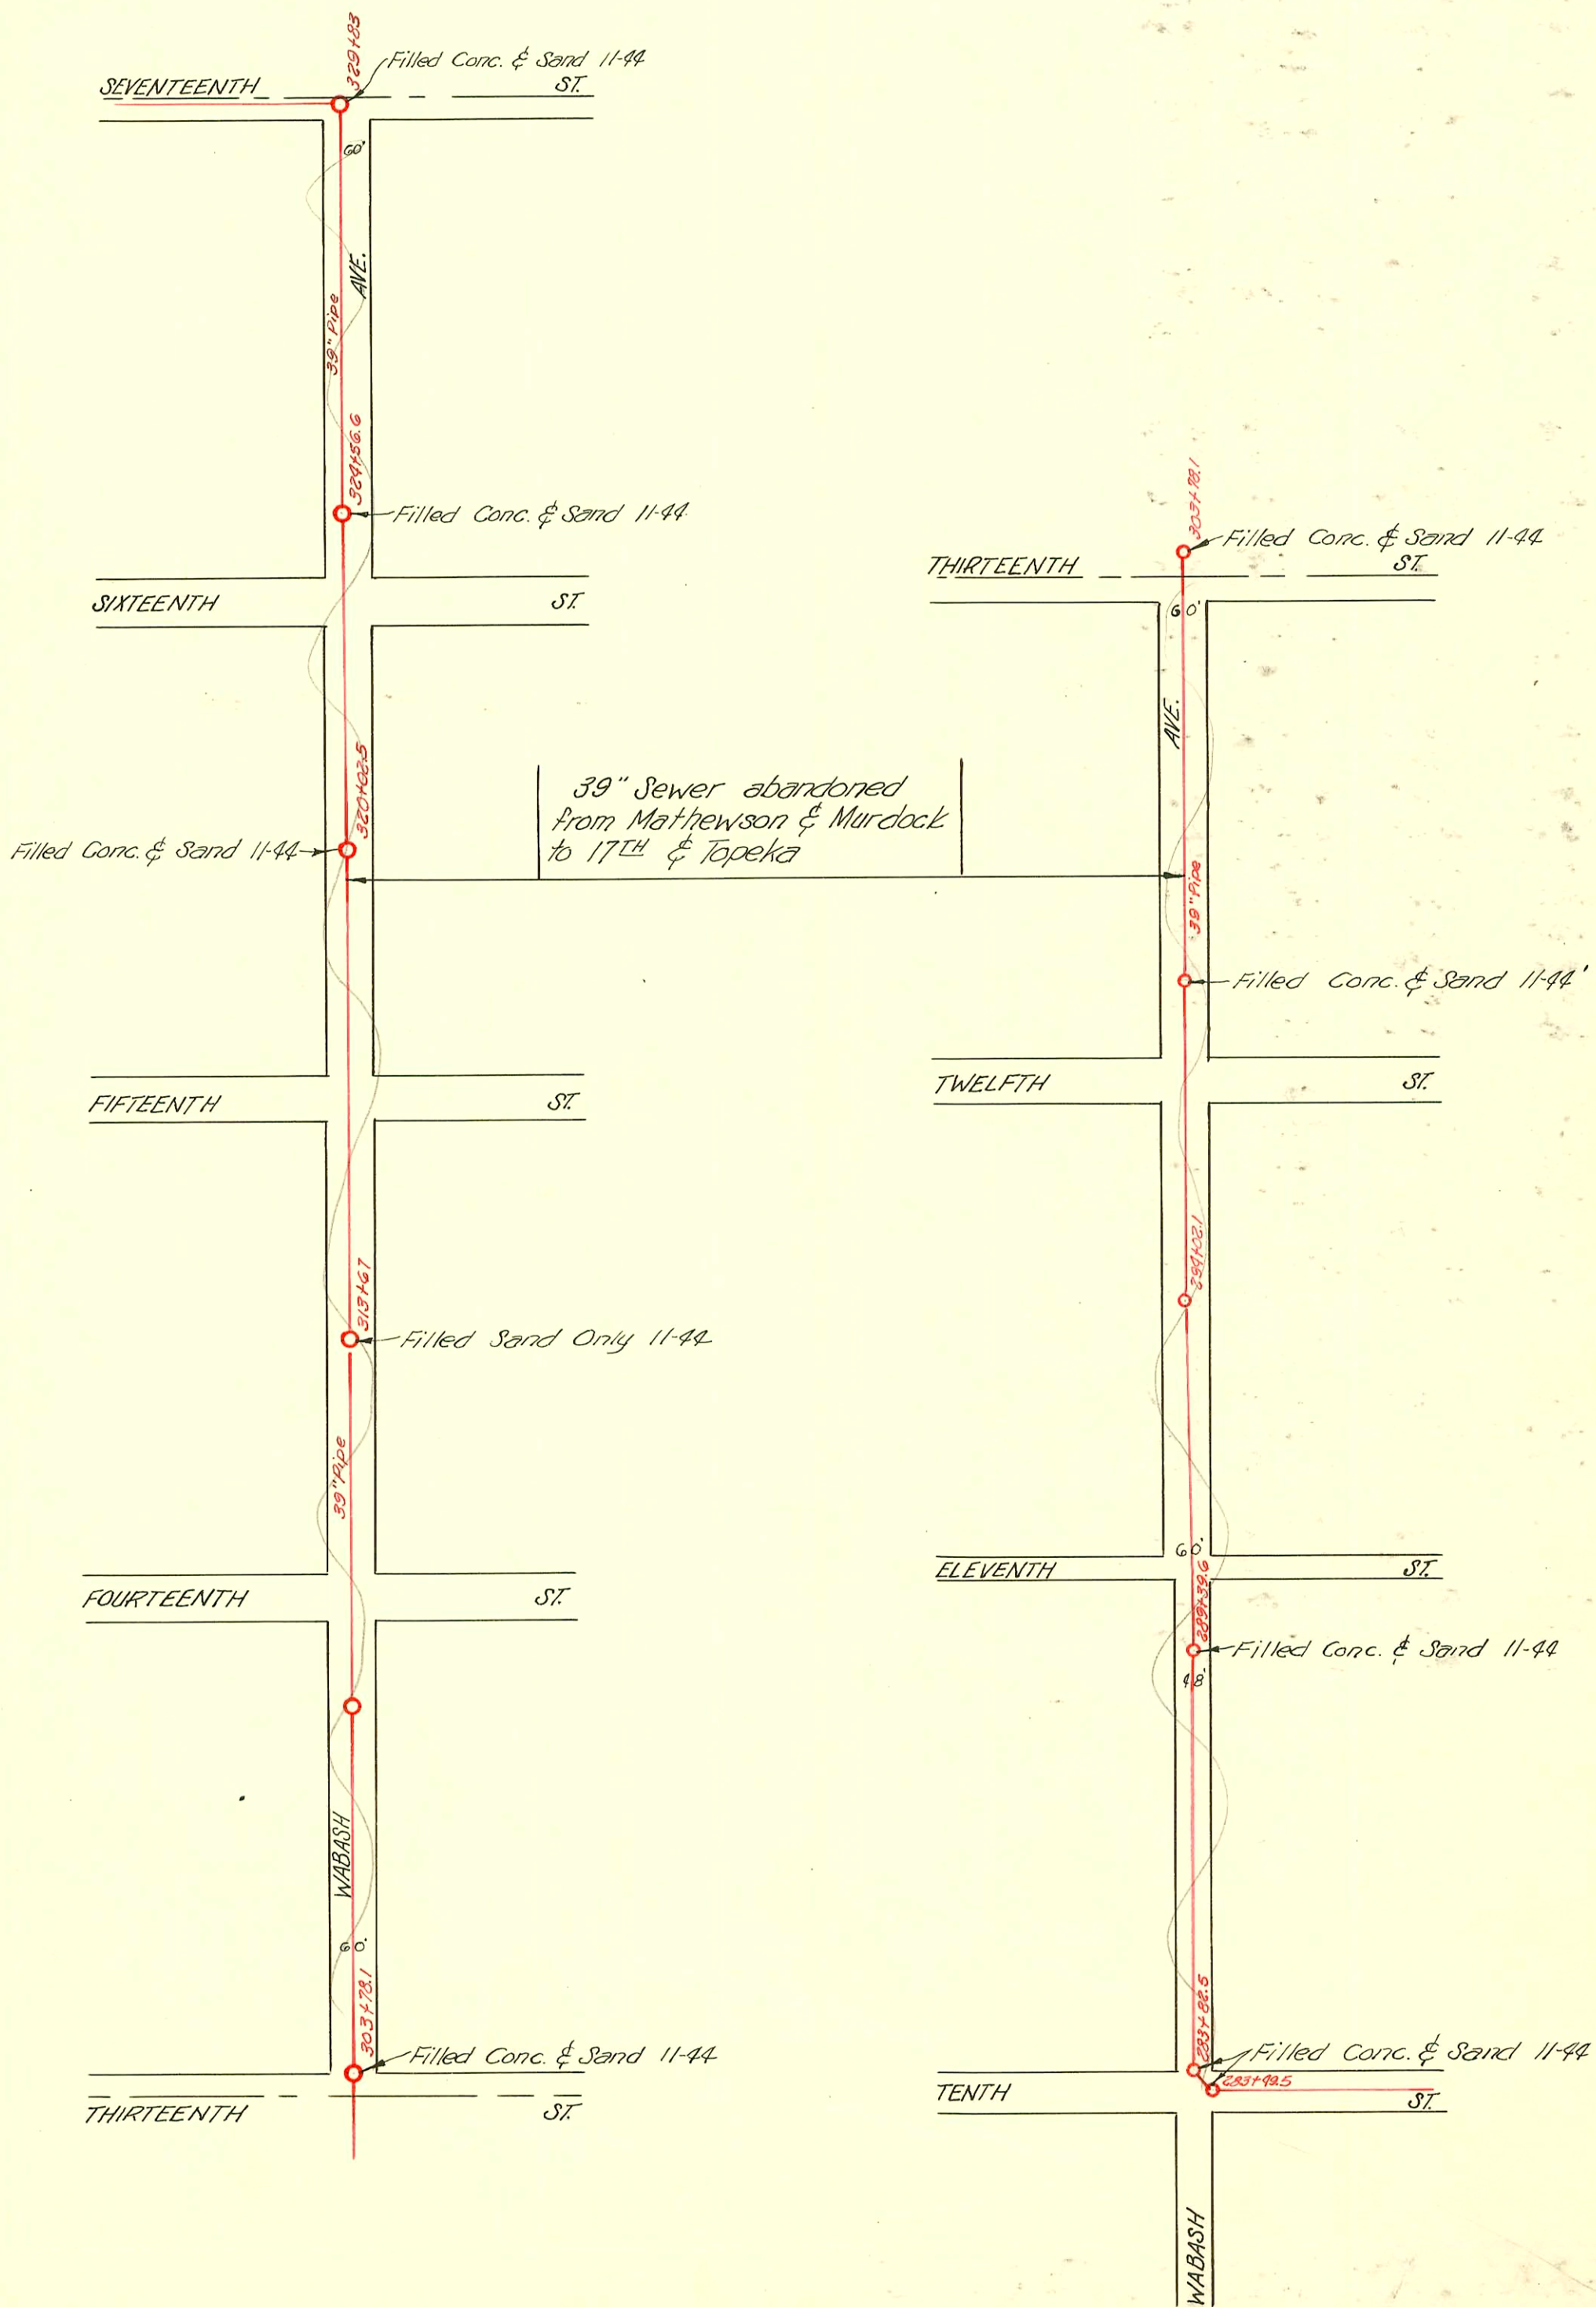

CONSTRUCTION RECORD						SERVICE RECORD						
STATION	ELEVATION		Depth	MANHOLE	4-INCH "Y" BRANCHES		No. of Permit		House Number		DATE OF PERMITS	
	Ground	Grade			North West	South East	North West	South East	North West	South East	North West	South East
283				49.5 +82.5								
284	114.92	103.00	11.97									
285	114.74	103.03	11.70									
286	115.10	103.10	12.00									
287	115.31	103.17	12.14									
288	114.76	103.24	11.52									
289	115.10	103.31	11.79									
				+39.6								
290	115.22	103.38	11.84									
291	115.24	103.44	11.80									
292	115.14	103.50	11.64									
293	115.42	103.57	11.85									
294	116.13	103.67	12.46									
				+02.1								
295	116.04	103.74	12.30									
296	116.14	103.80	12.34									
297	115.24	103.84	12.40									
298	115.94	103.91	12.03									
299	116.31	103.98	12.33									
300	116.75	104.04	12.71									
301	116.36	104.11	12.25									
302	116.72	104.18	12.54									
303	116.93	104.28	12.69									
				+78.1				#268	SW. 13th & Wabash		2-23-24	
304	116.91	104.33	12.58									
305	117.00	104.38	12.62									
306	117.10	104.45	12.65									
307	117.20	104.55	12.65									
308	117.20	104.63	12.57									
309	117.20	104.71	12.49									
310	117.20	104.79	12.41									
311	117.20	104.86	12.34									
312	117.40	104.93	12.47									
313	117.33	105.00	12.33									
				+67.0								
314	118.20	105.07	13.13									
315	118.50	105.13	13.37									
316	118.40	105.21	13.19									
317	118.30	105.27	13.03									
318	118.21	105.34	12.87									
319	118.51	105.41	13.10									
320	118.31	105.48	12.83									
				+02.5								
321	118.01	105.55	12.46									
322	118.91	105.62	13.29									
323	118.91	105.68	13.23									
324	119.01	105.78	13.23									
				+56.6								
325	119.31	105.84	13.47									
326	119.40	105.93	13.47									
327	119.30	105.99	13.31									
328	118.60	106.06	12.54									
329	118.40	106.16	12.24									
				+83.0								

Dunaway #254 11-17-24 13th & Wabash 150' N. of M.H. in Wabash Bemis Bag Co.
 Gittrich #674 8-10-27 1437 Wabash Tap, Special Fee \$14.50