


S.S. No. 20  
MAIN

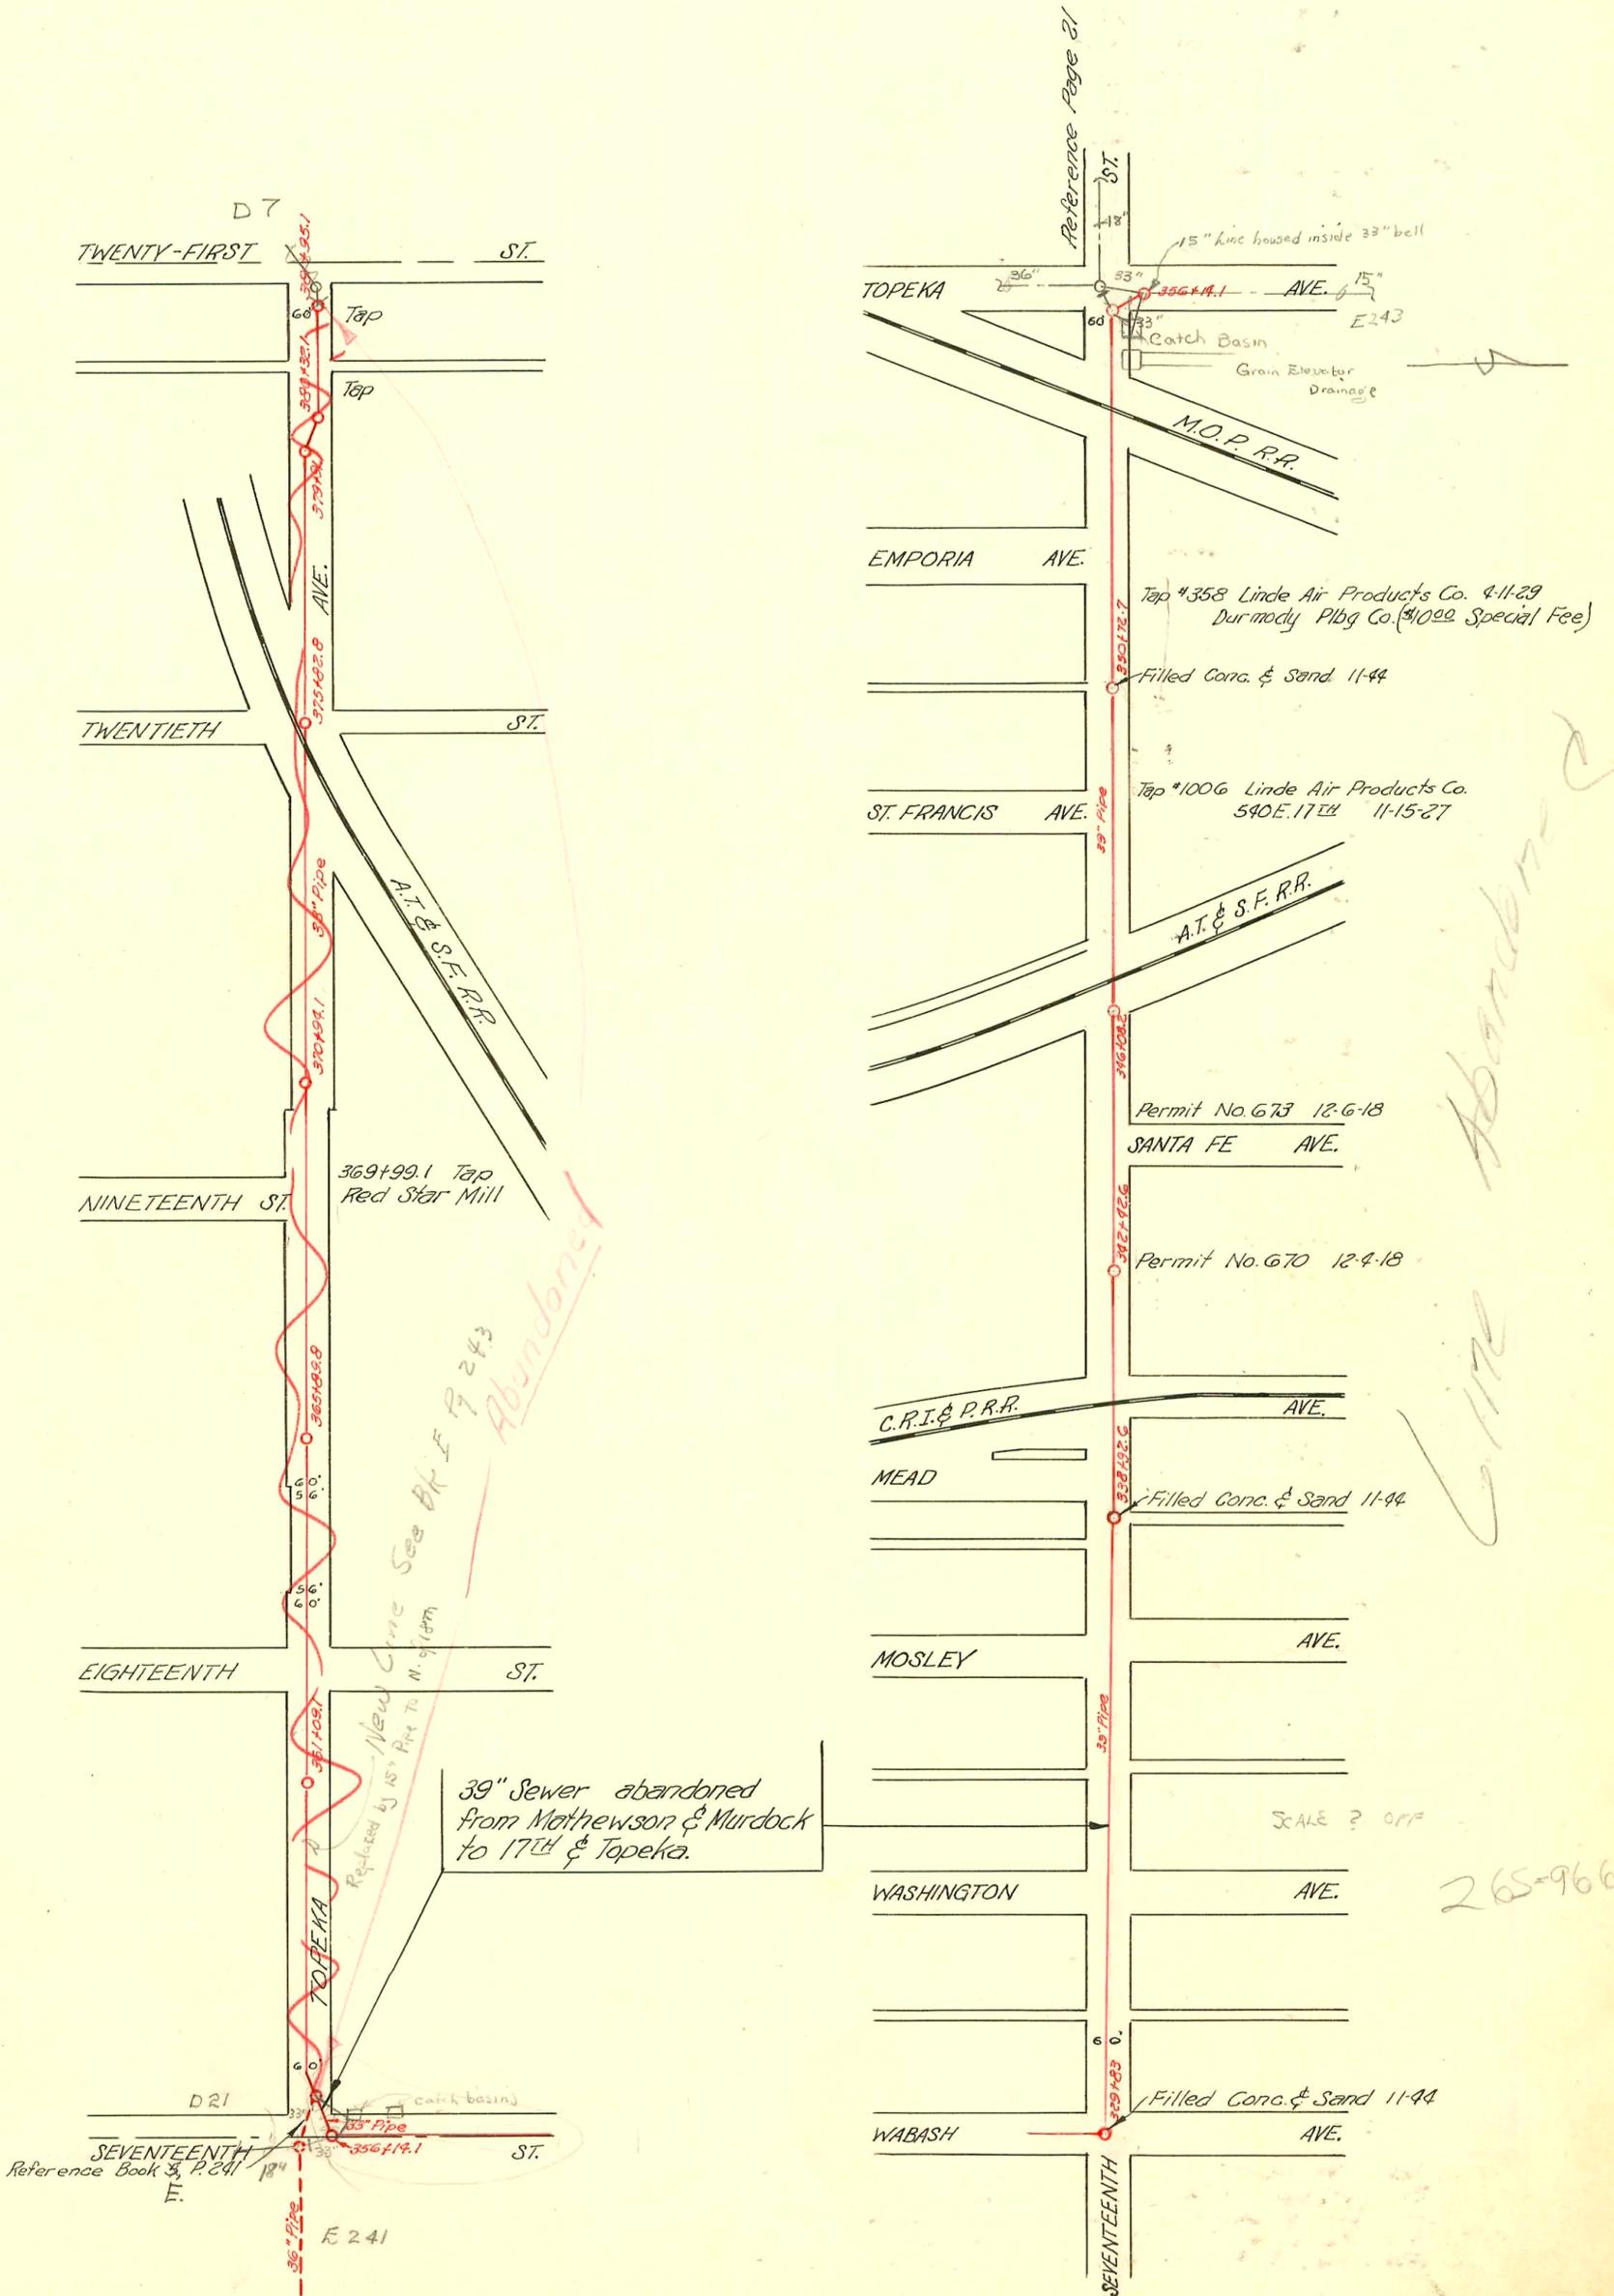

#651 Tap - 430 E. 18th 8-23-97 R. LaFoy

*Line Abandoned*

265-9664

D-6

CONSTRUCTION RECORD					SERVICE RECORD							
STATION	ELEVATION		Depth	MANHOLE	4-INCH "Y" BRANCHES		No. of Permit		House Number		DATE OF PERMITS	
	Ground	Grade			North West	South East	North West	South East	North West	South East	North West	South East
329	118.40	106.16	12.24									
				+83								
330	117.60	106.24	11.36									
331	117.56	106.32	11.24									
332	118.41	106.38	12.03									
333	118.76	106.45	12.31									
334	118.76	106.51	12.25									
335	118.46	106.57	11.89									
336	118.36	106.63	11.73									
337	118.66	106.69	11.97									
				+92.6								
338	118.26	106.75	11.51									
339	119.42	106.81	12.61									
340	120.22	106.89	13.33									
341	120.62	106.95	13.67									
				+43.6								
342	120.82	107.03	13.79									
343	120.92	107.10	13.82									
344	121.32	107.18	14.14									
345	122.62	107.25	15.37									
346	121.84	107.33	14.51									
				+08.2								
347	123.04	107.40	15.64									
348	121.94	107.48	14.46									
349	121.74	107.55	14.19									
350	121.54	107.63	13.91									
				+72.7								
351	122.14	107.70	14.44									
352	122.24	107.78	14.46									
353	121.95	107.85	14.10									
354	121.85	107.93	13.92									
355	122.03	108.00	14.03									
356	122.45	108.08	14.37									
				+14.1								
357	122.85	108.62	14.23									
358	123.17	108.71	14.46									
359	123.27	108.80	14.47									
360	123.07	108.89	14.18									
361	123.67	108.98	14.69									
				+09.1								
362	124.17	109.07	15.10									
363	124.47	109.16	15.31									
364	125.01	109.25	15.76									
365	124.35	109.34	15.01									
				+89.8								
366	123.65	109.43	14.22									
367	123.55	109.52	14.03									
368	123.25	109.61	13.84									
369	123.45	109.70	13.75									
370	123.15	109.79	13.36									
				+94.1								
371	122.85	109.88	12.97									
372	123.13	109.97	13.16									
373	123.23	110.06	13.17									
374	123.43	110.15	13.28									
375	123.03	110.24	12.79									
				+82.8								
376	123.03	110.33	12.70									
377	124.52	110.42	14.10									
378	122.80	110.51	12.29									
379	123.24	110.60	12.64									
				+91.1								
380	122.84	110.69	12.15									
				+32.1								
381	122.94	110.78	12.16			Tap at Alley S. of 21st		#120		407 E. 21st		1-24-23
				+95.1								
382	122.74	110.87	11.87									

#1296 Tap Dold Packing Plant 12-11-28 Moore & Robertson  
 #381 Tap N.E. cor. Topeka & 17th 7-17-29 J.C. Hendrick  
 #61 Tap 2146 N. Topeka 7-3-34 Simmons Plbg. (Hick Co.)  
 #2052 Tap Red Star Mill 12-22-39 Simmons Plbg. N.E. Co. 17th + 2nd  
 #2078 Tap 915 E. 17th Johnson Oil Co. 2-8-40 Albert V. Hoff

# 2072 2111 1/2 2227 N. Broadway - Sample Plbg -  
 Refer to Book D-46