
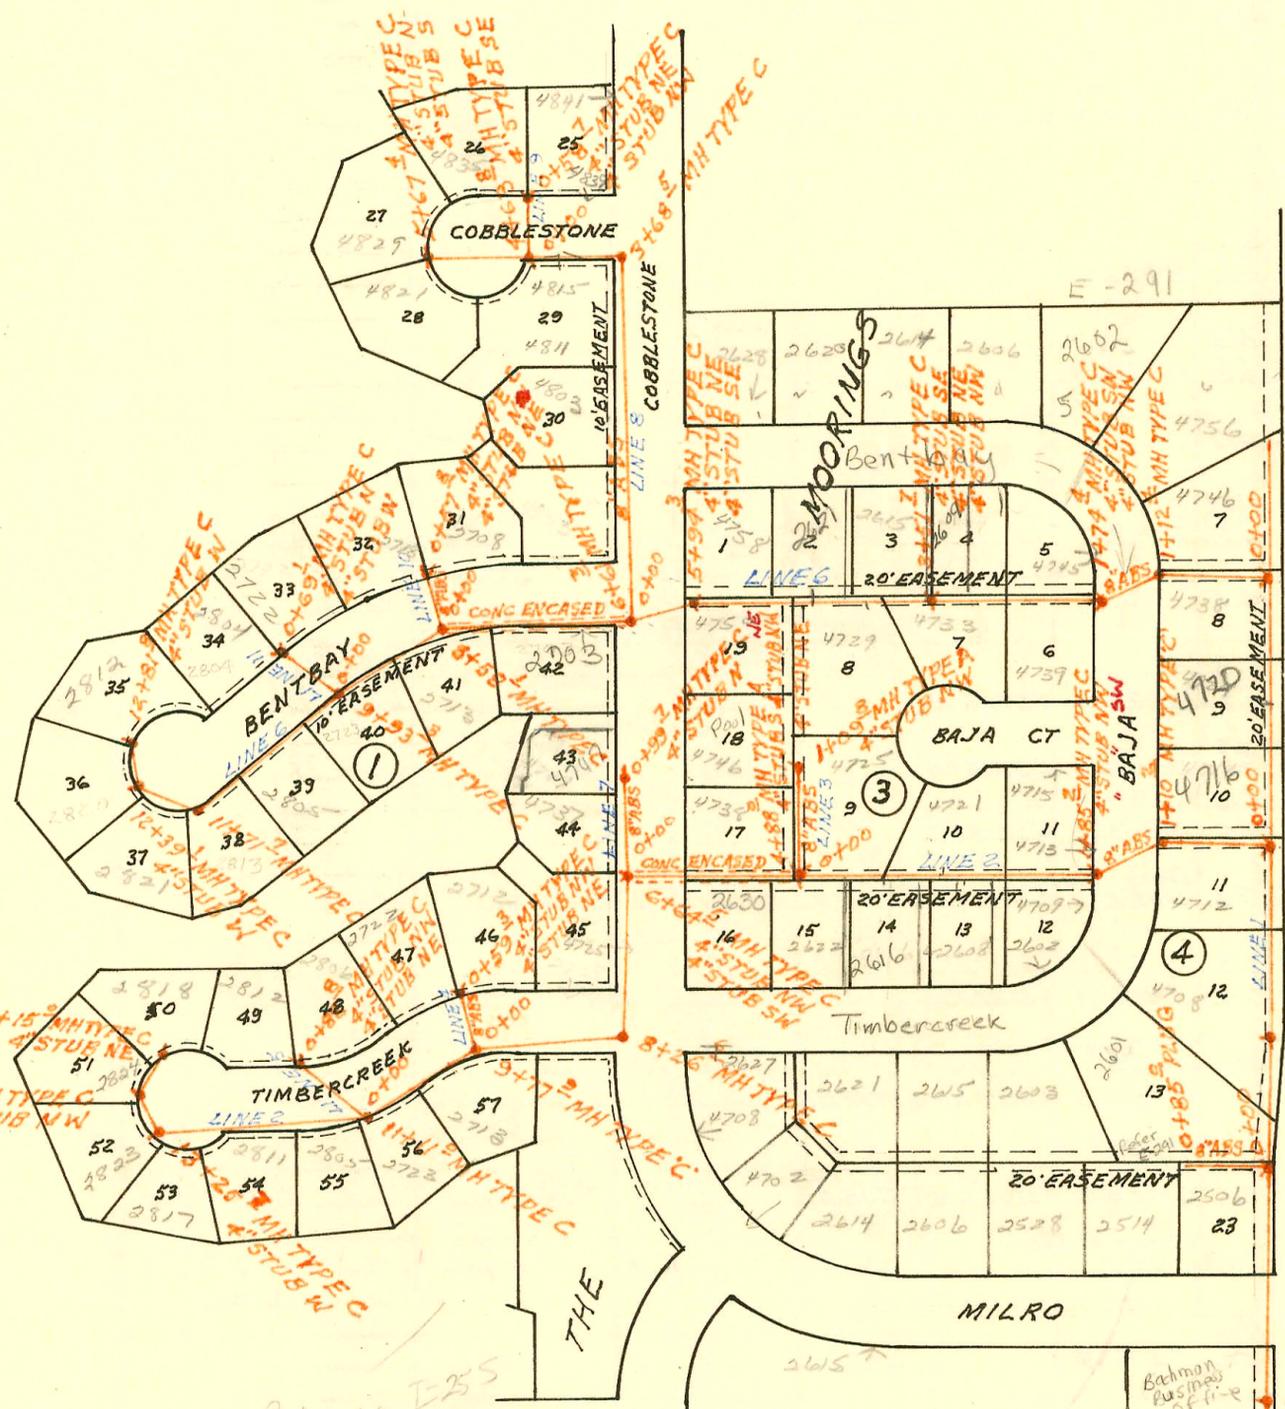


LATERAL 3 MAIN 19 WAR INDUSTRIES SEWER  
BUILT BY: ARKANSAS CONST. INC.  
PROJ. N<sup>o</sup> 468-76-245-80152-000-000-001  
BOOKED 11-4-78 FROM SLR4

on map


SCALE 1" = 300'

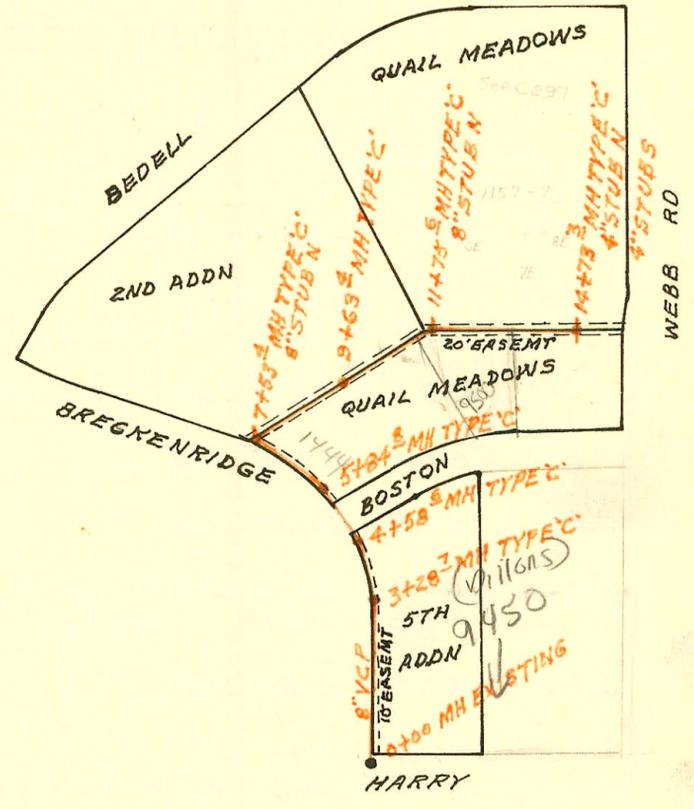

LATERAL 35 SAN SEWER N<sup>o</sup> 23  
BUILT BY: W.B. CARTER CONST. CO. INC.  
PROJ. N<sup>o</sup> DBKL 577084  
BOOKED 11-27-78 FROM ARBSS

on map

SCALE 1" = 150'

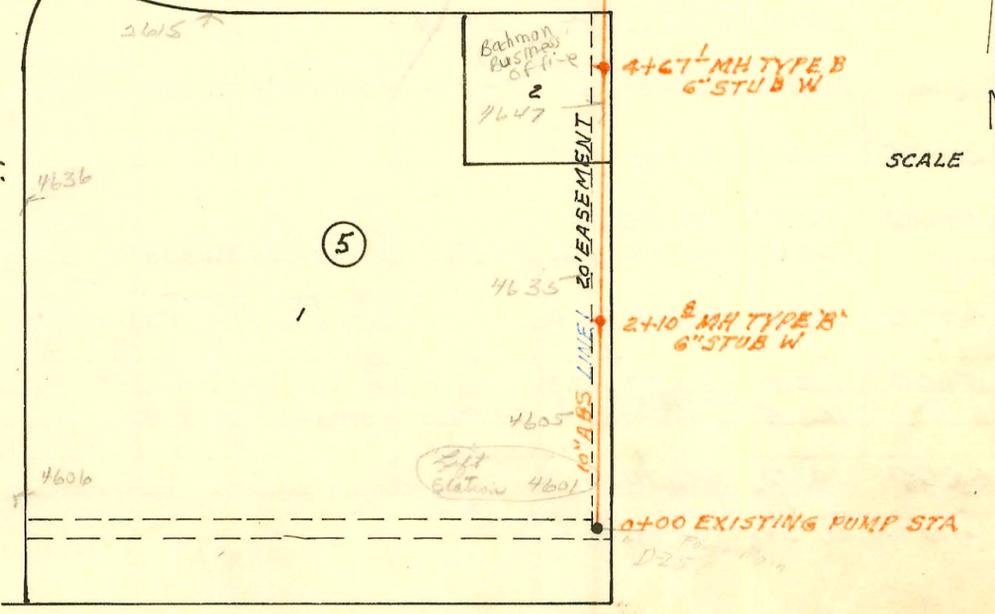

CONSTRUCTION RECORD

SERVICE RECORD

STATION	ELEVATION		Depth	MANHOLE	4-INCH "Y" BRANCHES		No. of Permit		House Number		DATE OF PERMITS	
	Ground	Grade			North West	South East	North West	South East	North West	South East	North West	South East
LATERAL 3 MAIN 19 WAR INDUSTRIES SEWER												
0+00	174.7	164.50	10.2	EXISTING								
1+00	175.0	164.90	10.1									
2+00	175.6	165.30	10.3									
3+00	176.0	165.70	10.3									
	176.0	166.81	9.2	3+28.7	4" CAST IRON 3+21.9		9536177		9450 E HARRY			3-17-95
4+00	175.9	166.30	9.6		4" CAST IRON 4+20.3		95-36167		9450 E HARRY			3-17-95
	175.9	166.73	9.2	4+58.6								
5+00	176.0	166.90	9.1									
	176.2	167.24	8.8	5+84.8	5+75.5		10924		1444 S Buckneridge			3-14-84
6+00	176.3	167.50	8.8									
7+00	176.5	167.90	8.6									
	176.5	168.11	8.2	7+53.4	8" STUB N							
8+00	176.6	168.50	8.1									
9+00	177.3	168.90	8.4									
	177.7	169.15	8.6	9+63.4								
10+00	178.4	169.30	9.1									
11+00	179.6	169.70	9.9									
	180.6	170.00	10.6	11+75.6	8" STUB N							
		170.20	10.4									
12+00	180.3	170.30	10.0									
					12+39.6		21726		9500 E Easton			10/19/88
					12+68.0		266828		1157 S Webb #6E			6-14-78
13+00	179.8	170.70	9.1									
					13+66.3		266829		1157 S Webb #7E			6-14-78
14+00	179.3	171.10	8.2									
	179.0	171.39	7.6	14+73.3	4" STUB N 4" STUB S		266830		1157 S Webb #8E			6-14-79
LATERAL 35 SAN SEWER No 23												
LINE 1												
0+00	139.7	122.79	16.9	LIFT STA								
1+00	141.2	122.99	18.2									
2+00	141.0	123.19	17.8									
	141.00	123.21	17.8	2+10.8	6" STUB W							
3+00	141.0	123.39	17.6									
4+00	141.0	123.59	17.4									
	141.0	123.72	17.3	4+67.1	6" STUB W	4" SDR 35	93-133387		4617 N Meridian			5-26-93
5+00	140.8	123.83	17.0									
6+00	140.8	124.01	16.8									
7+00	140.5	124.19	16.3	7+01.9	4" STUB NW 4" STUB SW							
8+00	140.0	124.39	15.6									
	139.8	124.46	15.3	8+32.6	4" STUB W		97-23567		4708 BUSA			2-18-97
9+00	139.6	124.59	15.0									
10+00	139.6	124.79	14.8									
	139.6	124.84	14.8	10+24.0	4" STUB NW 4" STUB SW		98-68897		4716 BUSA			4-20-98
							97-23567		4712 BUSA			2-18-97
11+00	139.9	124.99	14.9				98-14087		4720 BUSA			1-28-98
					4" RISER 1+65 W							
12+00	140.0	125.19	14.8									
	140.2	125.38	14.8	12+94.0			97-1247	97-3147	4716 BUSA	4738 BUSA		1-27-97
13+00	140.2	125.39	14.8									
14+00	140.0	125.59	14.4									
14+36.4	140.0	125.66	14.3									

CONSTRUCTION RECORD

SERVICE RECORD

STATION	ELEVATION		Depth	MANHOLE	4-INCH "Y" BRANCHES		No. of Permit		House Number		DATE OF PERMITS	
	Ground	Grade			North West	South East	North West	South East	North West	South East	North West	South East
LATERAL 35 SS N <sup>o</sup> 23 (CONT'D)												
LINE 2 0+00	139.6	128.84	10.8	0+00 = 10+27.0 LINE 1								
1+00	139.8 139.8	129.24 OUT 129.28 IN 129.38	10.6 10.5 10.4	1+10.2								
	139.8	OUT 129.68 IN 129.78	10.1 10.0	1+85.2	4" STUB NW	4" STUB SW	93-11047		4715 Mc Baja Ct		5-7-93	
2+00	140.1	129.84	10.3									
3+00	140.3	130.24	10.3		RISER 3+45 4"N	RISER 3+24 4"S	92-42047		4721 N Baja Ct		11-12-92	
4+00	140.5 142.2	130.64 130.99	9.9 11.2	4+88.0	4" STUB NE 4" STUB NW	4" STUB S 4" STUB S	91- 94-6550	96 2002-0995	4725 Baja	2616 Timbercreek 2622 R Timbercreek	See next pg 3-17-97	6-20-92 4-4-93 4-29-94
5+00	140.5	131.04	9.5	CONC ENCASED		5+63.0 5+68.4 4"S		072552		2630 Timbercreek		6-26-79
6+00	140.5 143.1	131.44 OUT 131.70 IN 134.48	9.1 11.4 8.6	6+64.5	4" STUB NW	4" STUB SW		3011		4725 Cablestone		4-6-81
7+00	140.8	134.59	6.2									
8+00	141.0 142.3	134.89 OUT 134.97 IN 135.07	6.1 7.3 7.2	8+26.6								
9+00	140.6 142.8	135.29 OUT 135.52 IN 135.62	5.3 7.3 7.2	9+77.9				7066		2713 Timbercreek		11-27-82
10+00	140.6	135.69	4.9									
11+00	140.7 143.3	135.99 OUT 136.02 IN 136.12	4.7 7.3 7.2	11+11.0				14909 24571		2723 Timbercreek 2895 Timbercreek		10-29-85 1-8-90
12+00	141.0	136.39	4.6					12+99.7	072808	2817 Timbercreek		7-6-79
13+00	142.0 144.2	136.69 OUT 136.76 IN 136.86	5.3 7.4 7.3	13+25.7	4" STUB W			072553		2823 Timbercreek		6-26-79
	144.3	OUT 136.99 IN 137.09	7.3 7.2	13+68.3	4" STUB NW			072554		2824 Timbercreek		6-26-79
14+00	142.0 144.2	137.19 137.23	4.8 7.0	14+15.0	4" STUB NE							
LINE 3 0+00	142.2	134.56	7.6	0+00 = 4+88.0 LINE 2 0+34.0				1214		4738 Cablestone		9-12-80
1+00	140.5 142.4	134.96 135.00	5.5 7.4	1+09.8	4" STUB NW			076395		4746 Cablestone		1-31-80
LINE 4 0+00	142.8 142.9	135.63 135.81	7.2 7.1	0+59.3	4" STUB NW	4" STUB NE	9502	9100	2722 Timbercreek	2717 Timbercreek	See 10-25-83	8-30-83
LINE 5 0+00	143.3 143.5	136.13 136.40	7.2 7.1	0+88.8	4" STUB NW	4" STUB NE	8461	6434	2812 Timbercreek	2806 Timbercreek		6-21-83 8-27-82
LINE 6 0+00	140.2	129.29	10.9	0+00 = 12+94.0 LINE 1 0+45.0				071349		2703 Bentbay		4-23-79
1+00	140.0 140.9	129.49 OUT 129.51 IN 129.61	10.5 11.4 11.3	1+12.4								
	140.9	OUT 129.73 IN 129.83	11.2 11.1	1+74.4	4" STUB NW	4" STUB SW	2004 01153	94- 18614-7	4745 Baja	4739 Baja		4-23-04 11-4-94
2+00	140.1	129.88	10.2									
3+00	140.2 141.4	130.08 130.19	10.1 11.2	3+51.7	4" STUB NE 4" STUB NW	4" STUB SE	93-2294-7 91	93-18218-7	2615 W Bentbay St 2629 Bentbay	4733 Baja Ct	8-30-93 3-17-97	7-7-93
4+00	140.7	130.28	10.4		RISER 4+73 4"N	RISER 4+20 4"S	93-10303-7	(see below) N/C 93-1633-7	2621 W Bentbay	4729 Baja Ct	6-23-93	1-27-93
5+00	140.8 142.5	130.48 OUT 130.67 IN 130.77	10.3 11.8 11.7	5+94.3	4" STUB NE	4" STUB SE		072773 18567	4758 Cablestone	4750 Cablestone	7-5-79	6-23-87
6+00	141.0	130.79	10.2									

CONT'D NEXT PAGE

#93-1633-7 - 4729 N Baja Ct - 4" SDR 25 - 4" Riser - 68' West - 1/4" pt - bsmt

