
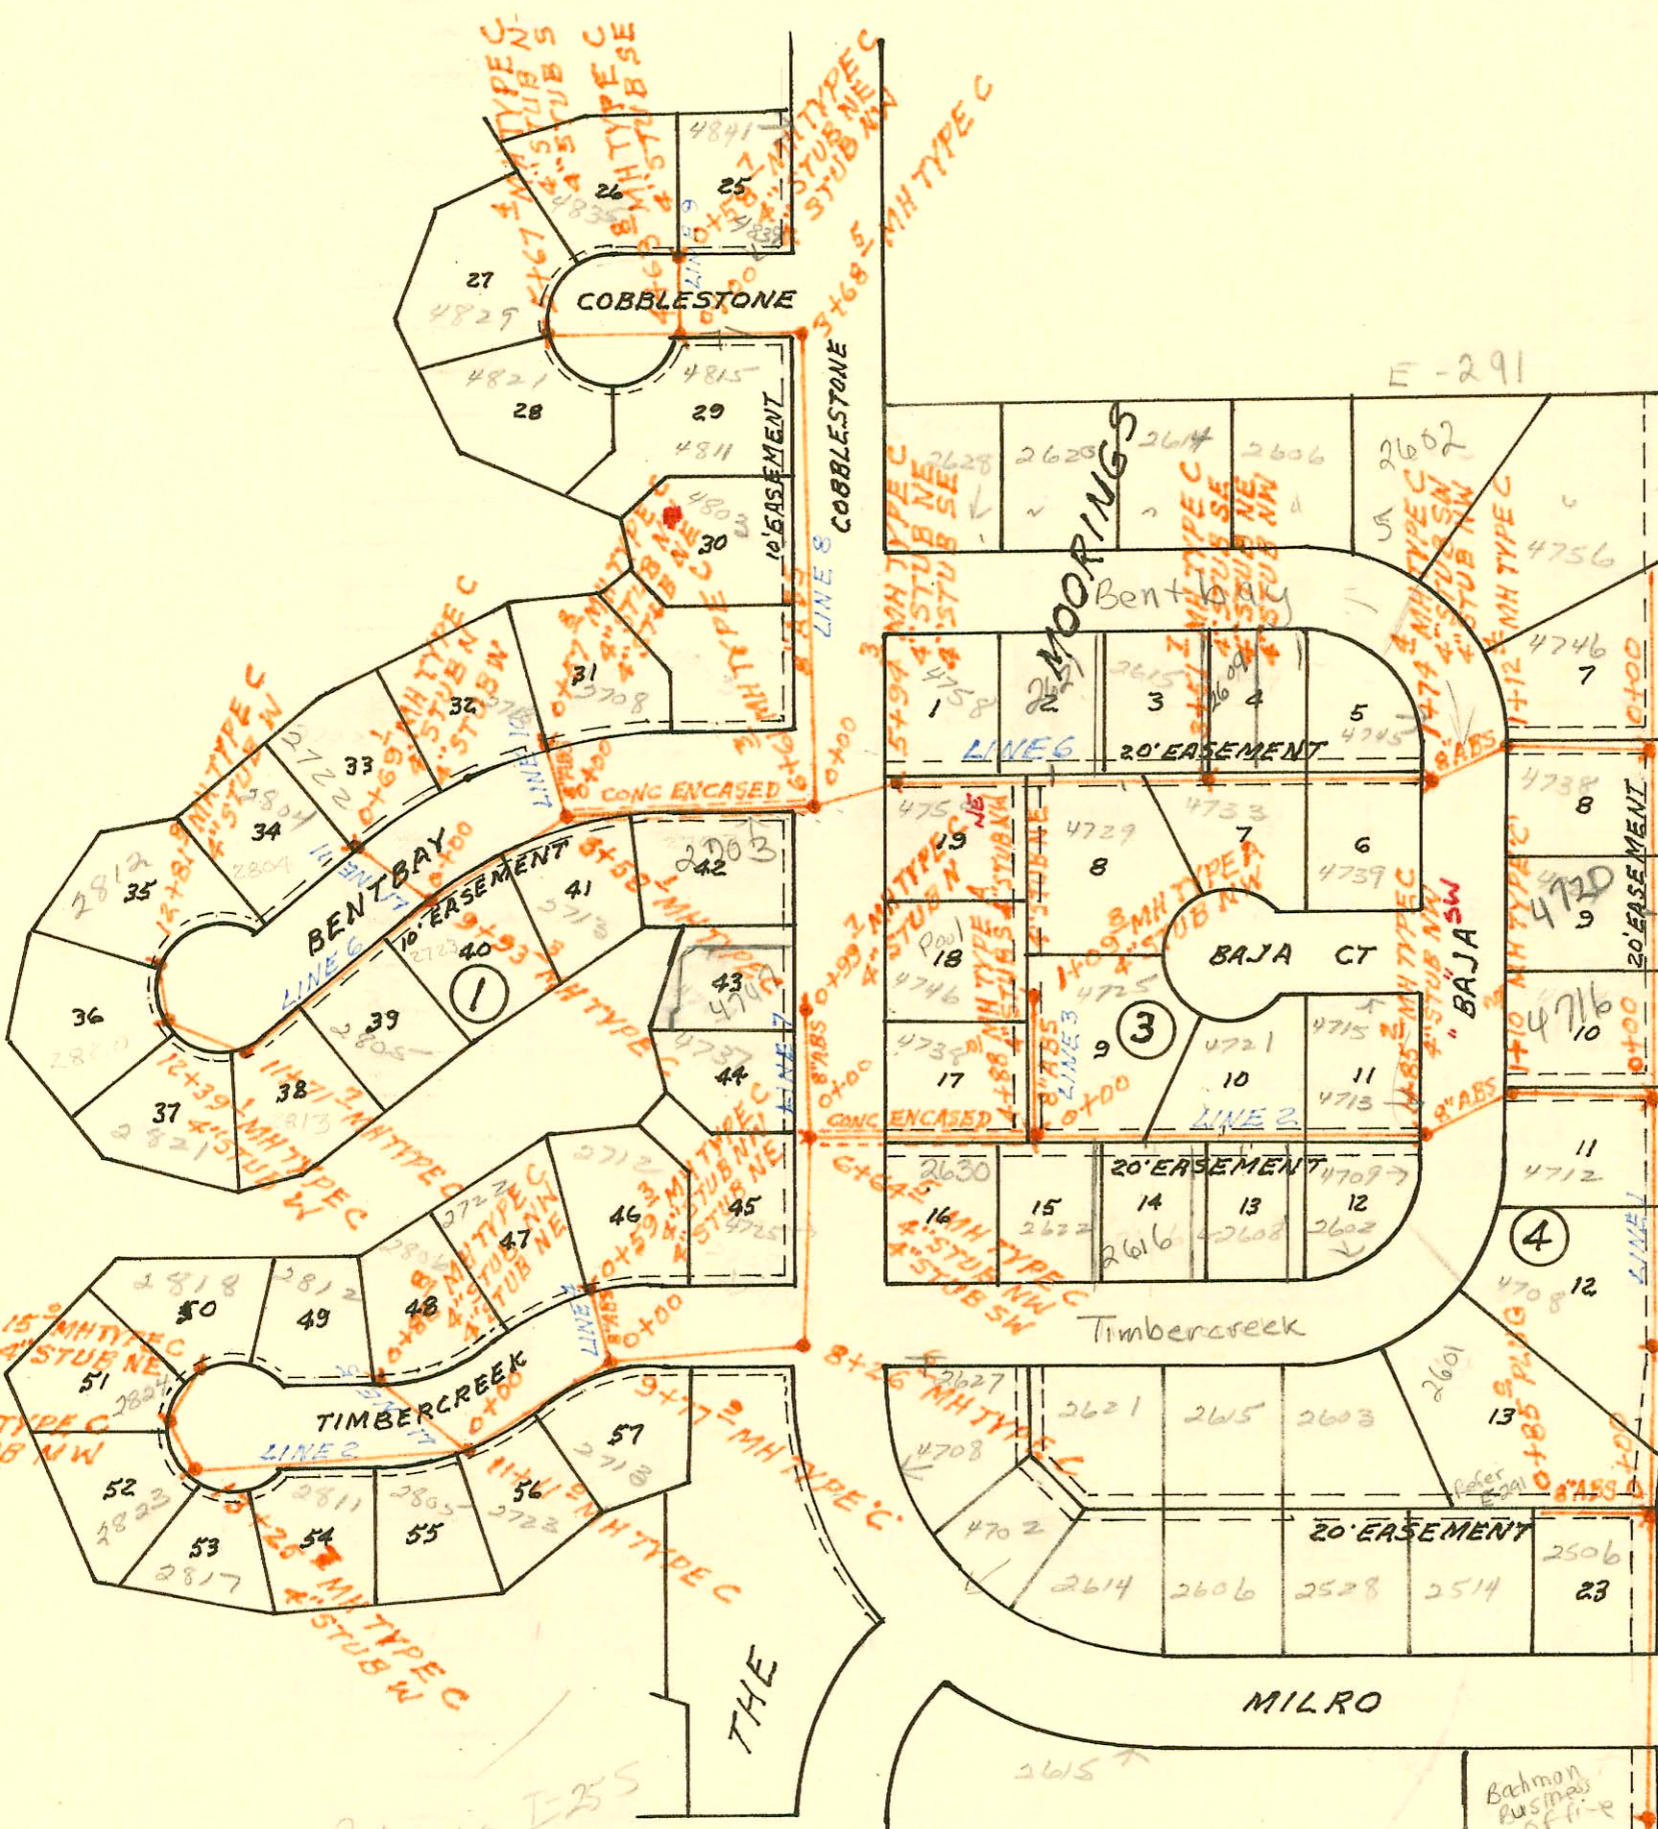


LATERAL 3 MAIN 19 WAR INDUSTRIES SEWER
BUILT BY: ARKANSAS CONST. INC.
PROJ. N^o 468-76-245-80152-000-000-001
BOOKED 11-4-78 FROM SLR4

on map

SCALE 1" = 300'

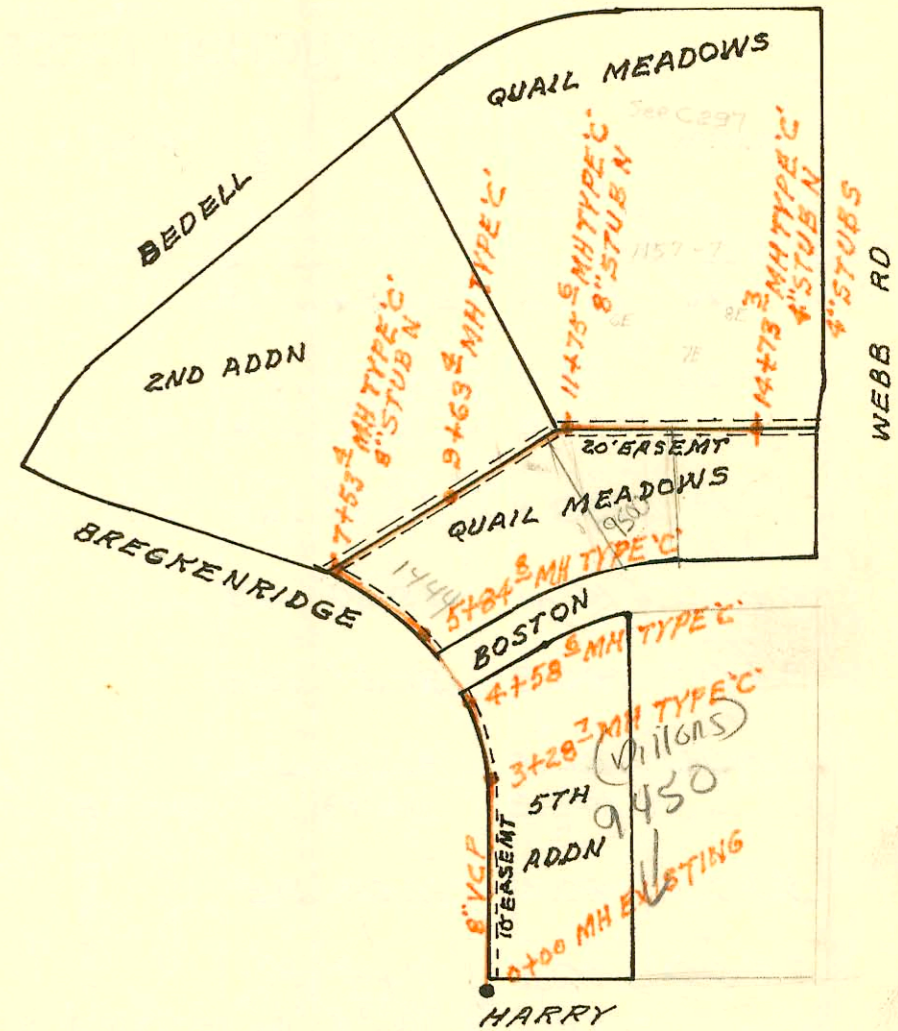

LATERAL 35 SAN SEWER N^o 23
BUILT BY: W.B. CARTER CONST. CO. INC.
PROJ. N^o DBKL 577084
BOOKED 11-27-78 FROM ARBSS

on map

SCALE 1" = 150'

