


S.S. No. 20 - 1919
LAT. Q - DIST. C

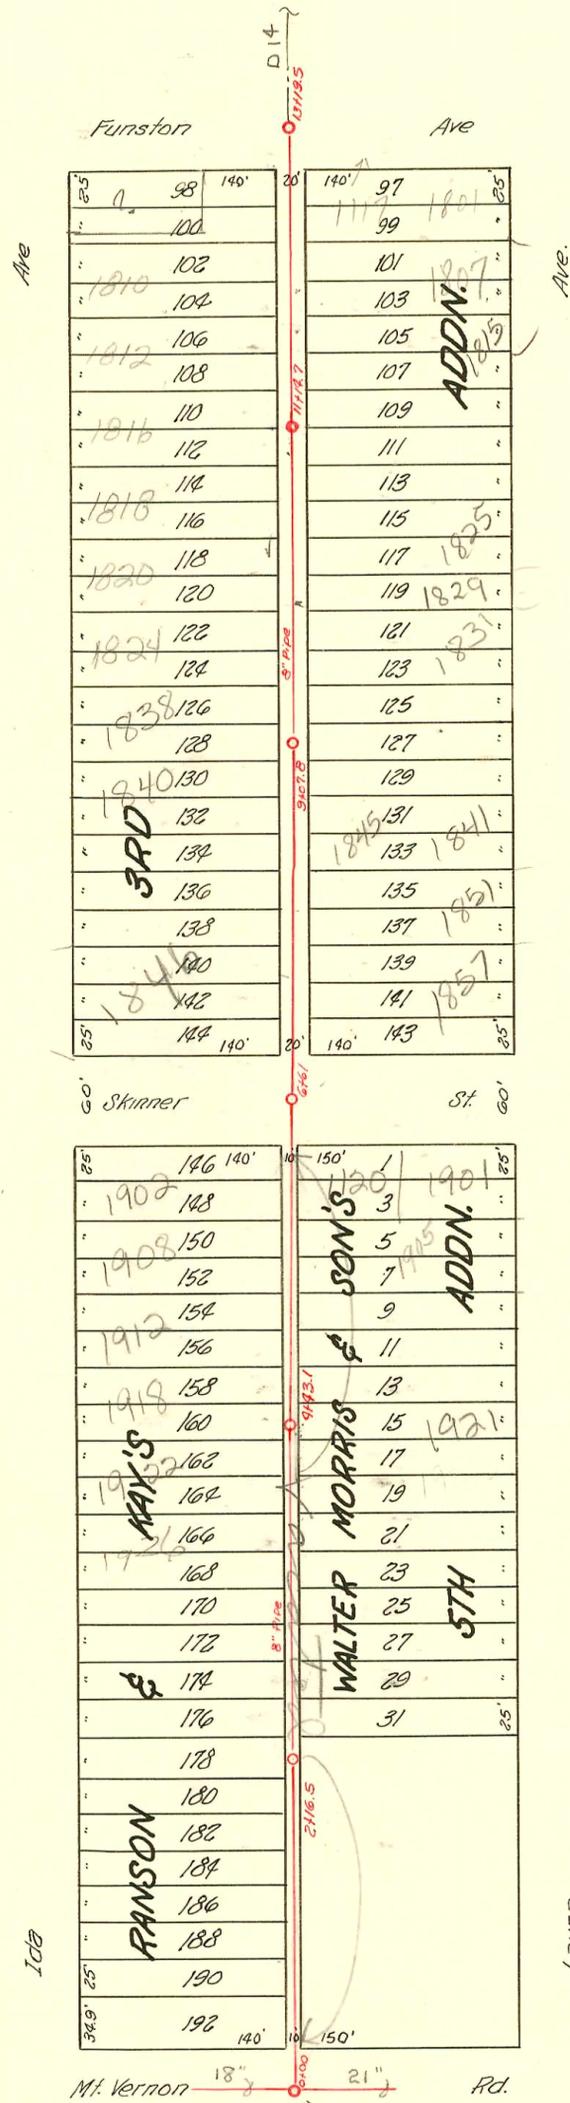

2004-00260 1/30/04 1810 S W2
Roto Rooter- 4" PVC - TWIN CO
No msmt

2003-00165 - 11/6/03 - 1851 Laura - Padgett Ex -
4" PVC city repair 109.5' N of MH 6161 (770.5)
2/22, TWIN CO, 4" Predco

Easement No. 751 - Main C, S.S. No. 20
S. 10' of this tract E. to A.T. & S.F. R/W

MHC
20 + 872
D 127

CONSTRUCTION RECORD						SERVICE RECORD						
STATION	ELEVATION		Depth	MANHOLE	4-INCH "Y" BRANCHES		No. of Permit		House Number		DATE OF PERMITS	
	Ground	Grade			North West	South East	North West	South East	North West	South East	North West	South East
13				13+19.5	13 +87.2 13 +61.6	+84.7 +59.1	961250 #2009		1757 Laura			8-19-6 8-18-50
					+86.8 +61.0 +35.4 +07.5	+84.3 +58.5 +32.9 +05.0			1802 Ida	1117 E. Funston	3-30-71 6-6-27	7-11-30
12	100.76	93.66	7.10		+83.7 +58.0 +32.0	+81.2 +55.5 +29.5	#288 #2513		1807 Laura			6-30-48 7-22-40
11	100.97	93.56	7.41	11+14.7	11+05.5	+03.0	95-9831 #755		1816 Ida		6-30-45 10-5-20	
					10+80.4 10+54.9 +29.2 10+03.5	+77.9 +52.4 +26.7 +01.0	#2053 #1403 #756 #3235		1818 Ida 10-5-20 1820 Ida	1831 Laura	9-9-24	11-3-48
10	101.01	93.46	7.55		9+63.8 +77.7	+75.2	1863 #340	97-345-7 #1403	1824 Ida	1831 Laura	11-11-80 4-17-22	9-7-97 11-3-48
9	101.35	93.36	7.99	9+07.8	9+27.2 +01.0	+49.6 +24.7	#2180	1519	1832 Ida	1825 Laura	10-29-49	5-9-39
					+76.5 +49.5 +24.5	+98.5 +74.0 +22.0	#1574		1890 Ida	1835 Laura	7-10-50	3-10-49
8	101.74	93.26	8.48		+99.0 +73.0 +47.5 +22.2	+96.5 +70.5 +45.0 +19.7	1588 #166	1892 Ida #2853	1861 Laura	7-11-22 see next		+16-43 3-21-46
7	101.82	93.16	8.66		6+96.6 6+21.5	+94.1 +19.0						
6	101.63	93.06	8.57	6+61	5+96.4 +69.5 +44.2 +18.8	+93.9 +67.0 +41.7 +16.3	2004- 00934 #487	#116	1902 Ida	1901 Laura	4-7-46 10-27-41	7-15-32
5	101.83	92.96	8.87		+90.5 +64.1 +38.2 +18.3	+88.0 +61.6 +35.7 +15.8	#485 #483		1908 Ida 1900 Ida	1923 Laura	10-27-41 6-13-24	
4	101.76	92.86	8.90	4+43.1	3+92.6 3+67.0 +40.0 +13.7	+90.1 +64.5 +37.5 +11.2	2004-5219 #484 #3239		1922 Ida	1921 Laura	7-23-41 10-27-41	1-23-44 3-27-41
3	101.39	92.76	8.63		2+86.4 +59.9 +33.5 +07.5	+83.9 +57.4 +31.0 +05.0						
2	100.76	92.66	8.10	2+16.5	+82.1 +56.8 +30.1 +04.0	+79.6 +54.3 +27.6 +01.5	2289				10-10-24	
1	100.61	92.56	8.05		+78.5 +52.5 +26.7	+76.0 +50.0 +24.2	273169		1926 Laura			7-23-77
0400	101.12	92.46	8.66									

#340 Tap 1841 Laura 10-29-52 Jack Durham lot # 4030 - 1841 Laura - Johnston Hwy. 7-21-67
 #6475 Tap 1926 Ida 9-17-53 Joe Mc Donald - tap in m. 2+16.5 ?
 10524 Tractor 1831 Laura Schuster Hwy 6-1-59
 10529 Tractor 1831 Laura Schuster Hwy 6-1-59
 AC 4031 - tap - 1841 Laura Johnston Hwy. 7-21-67 (8+18)
 C 26710 tap 1905 Laura - Harold Thompson - (5757) 8-3-71
 97-55952 4-11-77 1120 E Funston