


S.S. NO. 20 - 1919

LAT. Q. - DIST. C

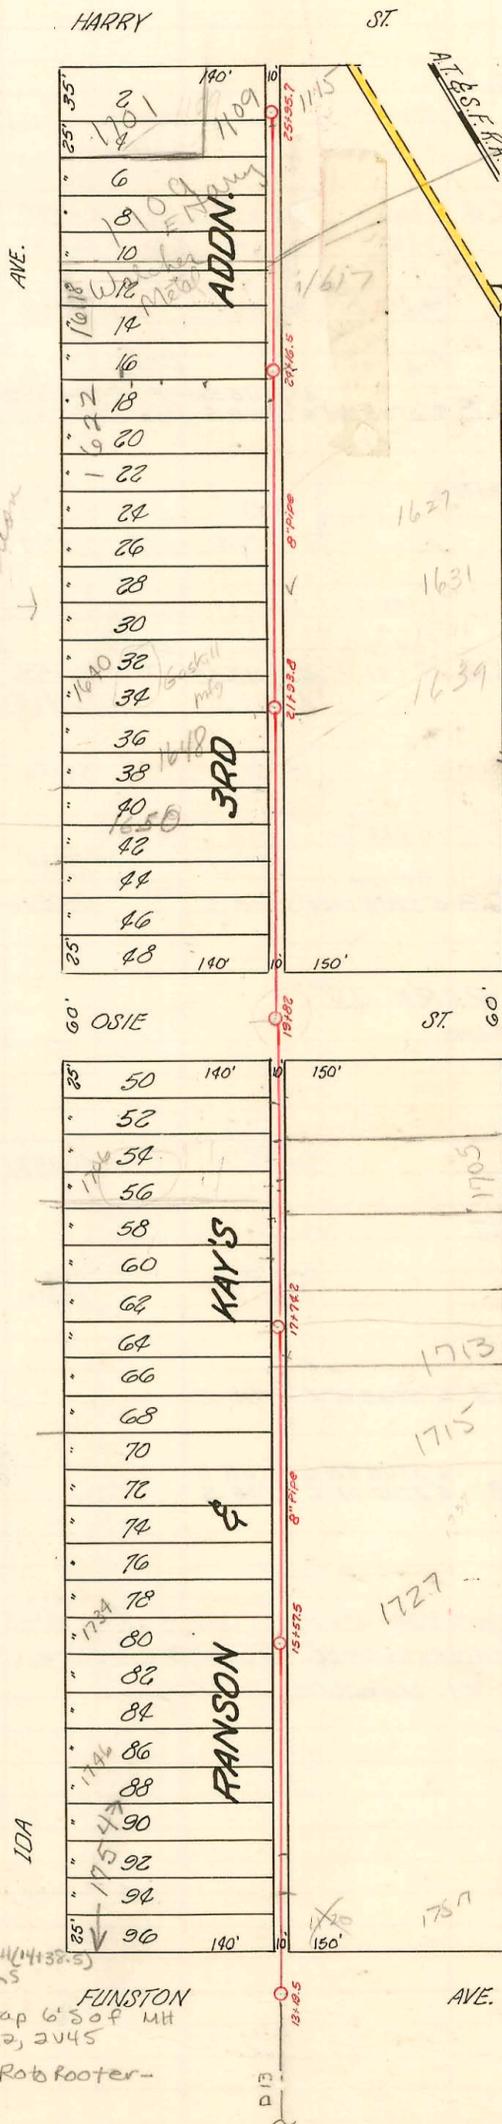

Refer to Storm Sewer Book A-54 24" Main also RUNS NIS in Alley

Easement #229  
S of E. side of following tract. Begin W of R/W of A.T. & S.F. on N. Line Sec. 33 W 41.7', S 20.1.8', E 133.46' to R/W. N.W. to beginning

Read note concerning easement on this section

\* C 76810 - 1622 - 1622 1/2 - 1624 S. Ida located on property at point line 42' w 75' w 95' w of main 9' S of MH.

Harry to Funston  
Laura to Ida

Note:  
City Main runs over-fall and work done between peaks. It would be best to check condition on city main prior to starting work on any bldg sewer.  
B.R. confirmed with Calvin - sewer maint 1-21-97

2005-03064-12-13-05 - 1748 S Ida - 119' S gmt (14132.5) Prdco, (1) 10, (2) 22H, (1) 45V, (2) 22V, shallow - 0511165  
2002-01618-6/12/02 - AE Henning - city tap 6' S of MH 1774 (1768.7) 4" 40 PVC, TWIN CO, 1U22, 2V45  
2002-02536 - 9/16/02 - 1754 S Ida - Rob Footer - 4" PVC 1TWIN CO

4569 Top 1753 Laura 3-27-52 C. Lee Tode  
2001-00139 #4771 Top 1727 Laura 4-9-53 Jack Durham 1/22/01 - Denny's Cleanout  
#6507 Top 1115 E. Harry 9-21-53 Max Hinshaw

# 23451 - 6/28/89 (1678 S Ida) - Henning - (sealed 4' S of MH in alley)  
Line used to dispose of water used in ATF relocated to storm sewer - Refer to storm Book #151  
per sewer maint

| CONSTRUCTION RECORD |           |       |       |         |                     | SERVICE RECORD |               |                 |                 |                                    |                 |               |          |                     |        |
|---------------------|-----------|-------|-------|---------|---------------------|----------------|---------------|-----------------|-----------------|------------------------------------|-----------------|---------------|----------|---------------------|--------|
| STATION             | ELEVATION |       | Depth | MANHOLE | 4-INCH "Y" BRANCHES |                | No. of Permit |                 | House Number    |                                    | DATE OF PERMITS |               |          |                     |        |
|                     | Ground    | Grade |       |         | North West          | South East     | North West    | South East      | North West      | South East                         | North West      | South East    |          |                     |        |
|                     |           |       |       | 25      | +95.7               |                |               |                 |                 |                                    |                 |               |          |                     |        |
|                     |           |       |       |         | 25                  | +89.3          | +86.8         |                 |                 |                                    |                 |               |          |                     |        |
|                     |           |       |       |         | 25                  | +62.5          | +60.0         | #490            |                 | 1012 Not<br>10114 correct          |                 | 6-10-20       |          |                     |        |
|                     |           |       |       |         | 25                  | +37.5          | +35.0         |                 |                 |                                    |                 | 7-1-27        |          |                     |        |
|                     |           |       |       |         | 25                  | +12.5          | +10.0         | #556            |                 |                                    |                 | 1606 Ida      |          |                     |        |
| 25                  | 100.55    | 94.96 | 5.59  |         | 24                  | +86.5          | +84.0         | #736            | 8-36            | 1618<br>Ida                        | 1115-2<br>Harry | 3-10-38       | 8-15-63  |                     |        |
|                     |           |       |       |         | 24                  | +60.8          | +58.3         |                 |                 |                                    |                 |               |          |                     |        |
|                     |           |       |       |         | 24                  | +32.5          | +30.0         | C76810<br>#649  |                 | 1622-227<br>1618 New<br>Ida (Bldg) | 1618<br>Harry   | 3-13-80       | 7-26-21  |                     |        |
| 24                  | 100.36    | 94.96 | 5.59  | 24      | +16.5               | 24             | +02.9         | #00504          |                 |                                    |                 | 6-7-80        |          |                     |        |
|                     |           |       |       |         | 23                  | +85.5          | +83.0         |                 |                 |                                    |                 |               |          |                     |        |
|                     |           |       |       |         | 23                  | +60.3          | +57.8         |                 |                 |                                    |                 |               |          |                     |        |
|                     |           |       |       |         | 23                  | +34.2          | +31.7         | C71032<br>#7026 | 5367            | 1632<br>Ida                        | 1617<br>Laura   | 4-4-29        | 7-17-25  | 9-25-37             |        |
| 23                  | 99.96     | 94.86 | 5.50  |         | 22                  | +83.0          | 22            | +80.5           | C71031<br>#1484 | 24854<br>16271                     | 163190<br>Laura | 4-4-23        | 10-8-23  | 2-26-40<br>5-20-64  |        |
|                     |           |       |       |         | 22                  | +61.5          | +59.0         |                 |                 | 1636<br>Ida                        |                 |               |          |                     |        |
|                     |           |       |       |         | 22                  | +33.3          | +30.8         | C70023<br>#1146 |                 | 1640<br>Ida                        |                 | 12-22-72      | 10-19-25 |                     |        |
| 22                  | 99.53     | 94.66 | 4.87  |         | 21                  | +93.8          | +80.4         | +78.9           | 11249<br>#1976  | #1632                              | 1648<br>Laura   | 1641<br>Laura | 8-23-84  | 6-13-52             |        |
|                     |           |       |       |         | 21                  | +55.7          | +53.2         |                 |                 | 1646<br>Ida                        | 1647<br>Laura   | 11-19-84      | 9-2-24   |                     |        |
|                     |           |       |       |         | 21                  | +30.3          | +27.8         |                 |                 | 1650<br>Ida                        |                 | 1-4-79        | 8-16-20  | 1-16-52             |        |
|                     |           |       |       |         | 21                  | +04.0          | +01.5         |                 |                 |                                    |                 |               |          |                     |        |
| 21                  | 99.82     | 94.56 | 5.26  |         | 20                  | +78.5          |               |                 |                 |                                    |                 |               |          |                     |        |
|                     |           |       |       |         | 20                  | +51.9          | +76.0         |                 |                 |                                    |                 |               |          |                     |        |
|                     |           |       |       |         | 20                  | +26.5          | +49.4         | C61884<br>#280  | #80             | 1658<br>Ida                        |                 | 2-25-24       | 2-8-27   | 1659 Laura          |        |
|                     |           |       |       |         | 20                  | +00            | +24.0         |                 |                 |                                    |                 |               |          |                     |        |
| 20                  | 99.98     | 94.46 | 5.52  |         | 19                  | +74.4          | +71.9         |                 |                 |                                    |                 |               |          |                     |        |
|                     |           |       |       |         | 19                  | +47.4          | +45.4         | C71521<br>#56   | 454<br>#1818    | 1702<br>Ida                        | 1648<br>Laura   | 1661<br>Laura | 8-14-28  | 12-11-23            | 4-9-56 |
|                     |           |       |       |         | 19                  | +22.5          | +20.0         |                 |                 |                                    | 1701<br>Laura   |               |          | 2-4-24              |        |
| 19                  | 99.26     | 94.36 | 4.90  |         | 18                  | +96.9          | +94.4         |                 |                 |                                    |                 |               |          |                     |        |
|                     |           |       |       |         | 18                  | +70.5          | +68.0         |                 |                 |                                    |                 |               |          |                     |        |
|                     |           |       |       |         | 18                  | +46.0          | +43.5         | 754             |                 | 1724<br>Ida                        | 1705<br>Laura   | 6-21-22       | 2-20-50  |                     |        |
|                     |           |       |       |         | 18                  | +22.2          | +19.7         | #29             | #2242           | 1701<br>Ida                        | 1709<br>Laura   | 1-15-24       | 8-24-45  |                     |        |
| 18                  | 99.69     | 94.26 | 5.43  |         | 17                  | +96.5          | +94.0         |                 |                 |                                    |                 |               |          |                     |        |
|                     |           |       |       |         | 17                  | +70.2          | +67.7         |                 |                 |                                    |                 |               |          |                     |        |
|                     |           |       |       |         | 17                  | +44.9          | +42.4         | #353            |                 | 1718<br>Ida                        | 1713<br>Laura   | 3-3-24        | 4-13-48  | 67562<br>10-26-51   |        |
|                     |           |       |       |         | 17                  | +19.3          | +16.8         |                 |                 |                                    |                 |               |          |                     |        |
| 17                  | 99.60     | 94.16 | 5.44  |         | 16                  | +92.5          | +91.0         | #366            |                 | 1730<br>Ida                        |                 | 3-4-24        |          |                     |        |
|                     |           |       |       |         | 16                  | +70.2          | +67.7         | #320            |                 | 1724<br>Ida                        |                 | 4-21-26       |          |                     |        |
|                     |           |       |       |         | 16                  | +44.1          | +41.6         |                 |                 |                                    |                 |               |          |                     |        |
|                     |           |       |       |         | 16                  | +18.6          | +16.1         |                 |                 |                                    |                 |               |          |                     |        |
| 16                  | 100.15    | 94.06 | 6.09  |         | 15                  | +92.5          | +90.0         |                 |                 |                                    |                 |               |          |                     |        |
|                     |           |       |       |         | 15                  | +67.0          | +64.5         | #3325           | #1311           | 1731-36<br>Ida                     | 1721<br>Laura   | 1737<br>Laura | 2-15-50  | 8-20-40<br>12-18-47 |        |
|                     |           |       |       |         | 15                  | +41.7          | +39.2         |                 |                 |                                    |                 |               |          |                     |        |
|                     |           |       |       |         | 15                  | +16.0          | +13.5         |                 |                 |                                    |                 |               |          |                     |        |
| 15                  | 99.83     | 93.96 | 5.87  |         | 14                  | +90.1          | +87.6         |                 |                 |                                    |                 |               |          |                     |        |
|                     |           |       |       |         | 14                  | +64.5          | +62.0         | #1597           | #467            | 1748<br>Ida                        | 1751<br>Laura   | 11-24-48      | 5-8-30   |                     |        |
|                     |           |       |       |         | 14                  | +38.1          | +35.6         | #205            |                 | 1746<br>Ida                        | 1748<br>Laura   | 3-27-50       |          |                     |        |
|                     |           |       |       |         | 14                  | +13.1          | +10.6         |                 |                 |                                    |                 |               |          |                     |        |
| 14                  | 99.87     | 93.86 | 6.01  |         |                     |                |               |                 |                 |                                    |                 |               |          |                     |        |

1724 Ida Jap - 1-21-26 #320 7-13-26 Jap Paid  
 #2555 Jap in main sewer 1015 E. Harry (Linwood Creamery) 8-5-40 - W. W. Pray.  
 #6287 Jap 1109 E. Harry 10-30-51 Linshaw Planting Co.  
 #2778 Jap 1706 Ida 11-24-51 Int Power #91-36497-7 10/30/8 1646 S Ida - 4" PVC 40' tied into sewer for 1648 Ida (rear Bldg) OK'd Per G. Sheppard  
 C71034 - 1647 Laura Bldg - 2-3-1-79 - New Conn. (20+66.0)  
 C71037 - 1640 Ida - 4-4-79 (top 22+18.4)  
 R #00561 - 1618 Ida 6-12-80 (Different location 2 listed above - Williams) (25+85.7) (10592595.7)