
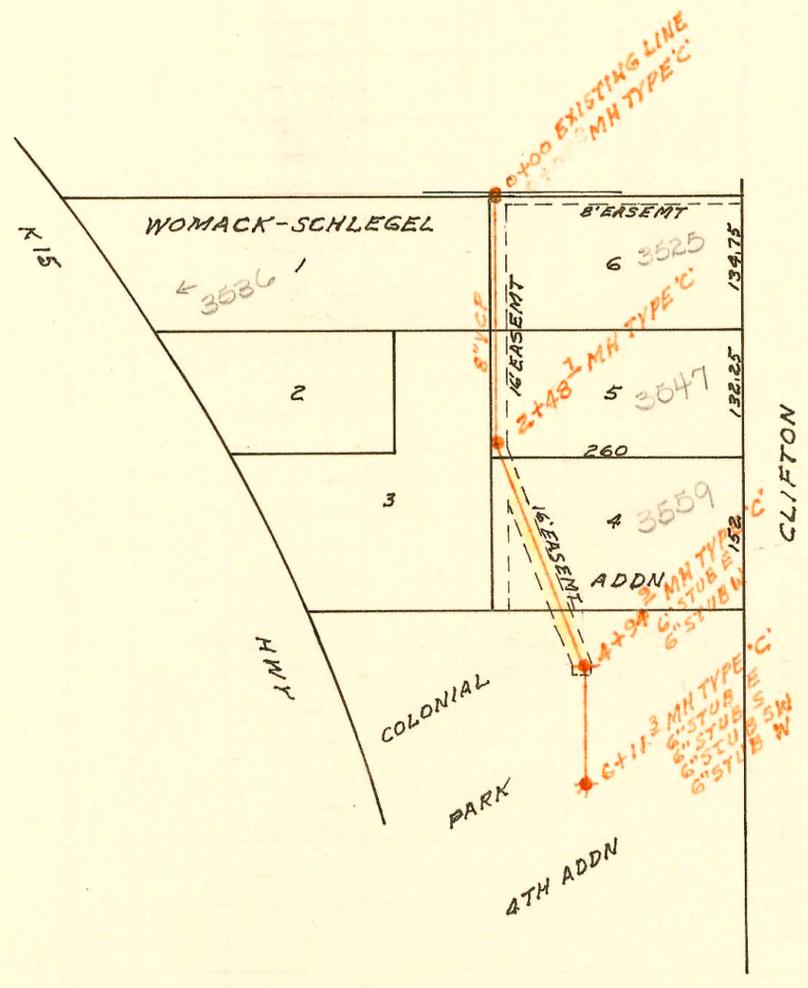


SCALE 1"=100'

SAN SEWER EXT TO PART OF LOT 1 WILLIE COLE 1ST ADD  
 BUILT BY: MID STATES CONST. CO. INC.  
 PROJ. N<sup>o</sup> DBKW 707088  
 BOOKED 11-29-78 FROM AR 92

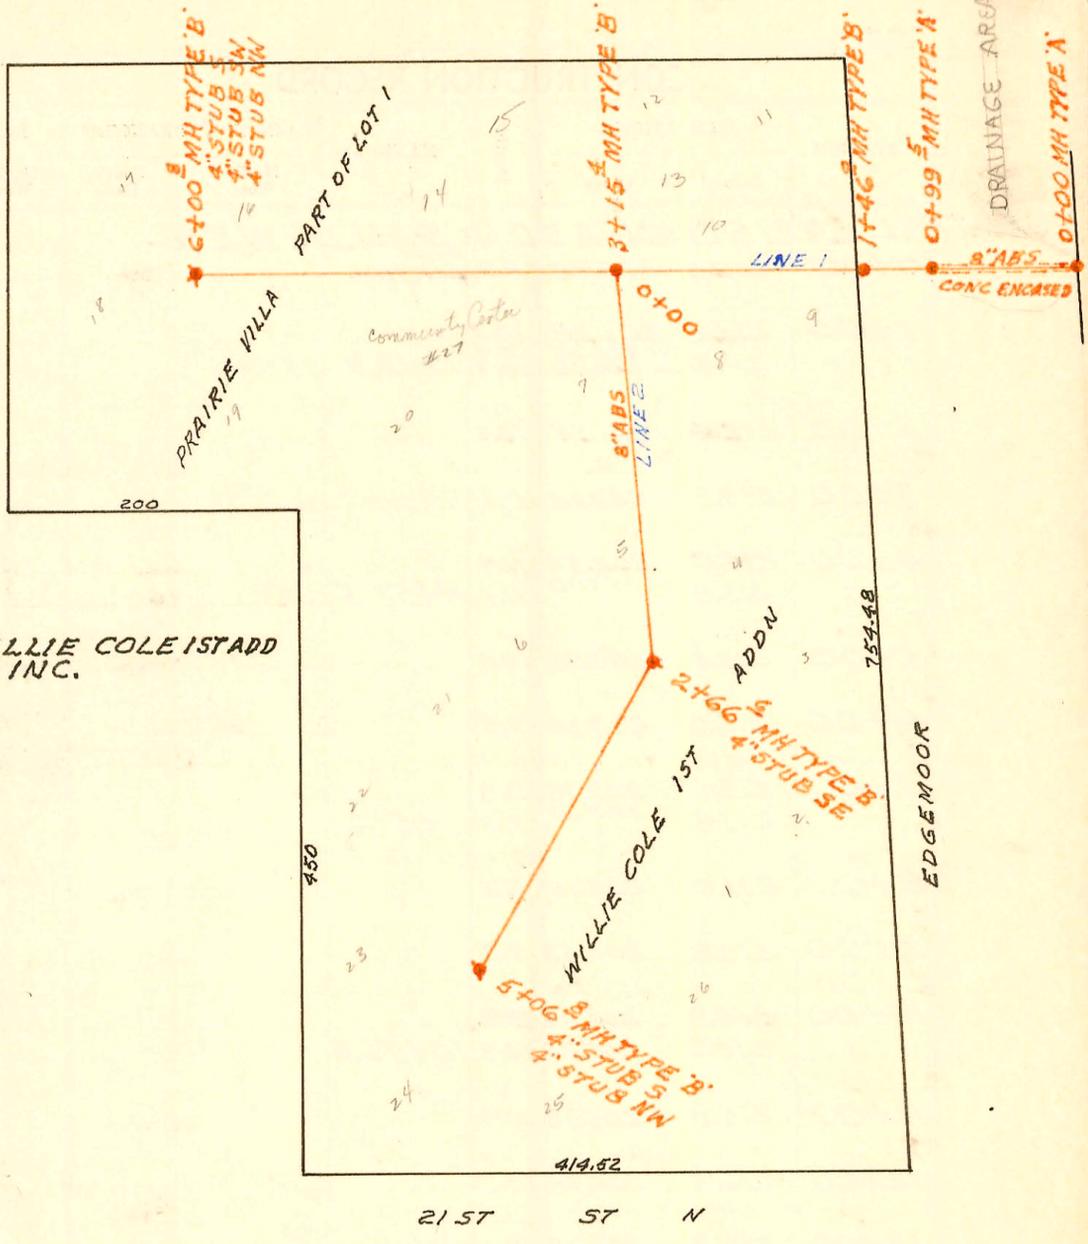

SCALE 1"=150'

SAN SEWER EXT TO COLONIAL PARK IV  
 BUILT BY: ARKANSAS CONST. CO.  
 PROJ. N<sup>o</sup> 468.76.245.80627.000.000.008  
 BOOKED 12-1-78 FROM AR 92

CONSTRUCTION RECORD

SERVICE RECORD

STATION	ELEVATION		Depth	MANHOLE	4-INCH "Y" BRANCHES		No. of Permit		House Number		DATE OF PERMITS	
	Ground	Grade			North West	South East	North West	South East	North West	South East	North West	South East
SAN SEWER EXT TO PART OF WILLIE COLE 1ST ADDN												
LINE 1 0+00	190.0	180.50	9.5	0+00		0+52.8		C66818		5640 E. 21st #9		8-15-78
1+00	190.0	181.01	9.1	0+99.5								
2+00	190.0	182.10 182.2	7.9 7.8	1+46.0	2+17.0 2+41.4			C67438 C66817		5640 E. 21st #13 5640 E. 21st #10		7-24-78 8-14-78
3+00	192.0	184.84 185.1 185.2	6.9 6.8	3+15.4	3+26.4 3+26.4	4+10.4 4+11.4		C67439 C67440	C67445 C67447	5640 E. 21st #14 5640 E. 21st #15	5640 E. 21st #14 5640 E. 21st #14	7-21-78 7-21-78
4+00		186.65			4+66.2	4+64.8		C67251	C67446	5640 E. 21st #21	5640 E. 21st #21	7-12-78 7-21-78
5+00		188.37			5+43.8			C67441		5640 E. 21st #16		7-20-78
6+00	197.0	190.10	6.9	6+00.8	4" STUB SW 4" STUB NW	4" STUB SE 4" STUB S		C67442 C67443	C67444	5640 E. 21st #17 5640 E. 21st #17	5640 E. 21st #18 5640 E. 21st #19	7-19-78 7-19-78
LINE 2												
0+00	192.0	185.2	6.8	0+00=3+15.4 LINE 1		0+75.7 0+96.7		C66821 C66817		5640 E. 21st #7 5640 E. 21st #8		8-14-78 8-14-78
1+00		186.29			1+94.2	2+26.0		C66820 C66822		5640 E. 21st #5 5640 E. 21st #4		7-25-78 7-25-78
2+00	195.3	187.38 188.1 188.2	7.2 7.1	2+66.6	2+88.6 2+97.6	4" STUB SE 3+07.6		C67435 C67437	C67436	5640 E. 21st #2 5640 E. 21st #6	5640 E. 21st #3 5640 E. 21st #3	7-26-78 8-11-78
3+00		188.88				4+30.8		C67256		5640 E. 21st #26		7-10-78
4+00		190.92			4+89.8			C67252		5640 E. 21st #22		7-7-78
5+00	200.0	192.96 193.10	6.9	5+06.8	M.H. 40 W. 4" STUB NW	4" STUB S 4" STUB S		C67253 C67254	C67255	5640 E. 21st #23 5640 E. 21st #23	5640 E. 21st #24 5640 E. 21st #24	7-11-78 7-7-78
SAN SEWER EXT TO COLONIAL PARK IV												
0+00				EXISTING LINE								
0+00	130.2	122.20	8.0	0+00								
1+00		122.58				WYE 2+05.0		C67474		3547 S. Clifton		11-17-78
2+00	130.2	122.98 123.19 123.29	7.0 6.9	2+48.7								
3+00		123.48				4" WYE 3+28.7		2003 03269		35595 Clifton	See Below	12-15-03
4+00		123.88										
5+00	130.1	124.28 124.38	5.8 5.7	4+94.9	6" STUB W	6" STUB E						
6+00	130.1	124.78 124.85	5.3	6+11.3	6" STUB SW 6" STUB W	6" STUB E 6" STUB S						

2003-03269-121503-35595 Clifton-Wichita Exc-4" PVC, 1/2" W.C., 1/2" 22, 1045, Note from Curtis Ledbetter (12116103) Curtis replaced rear 40' of pipe off of property only. ABS plastic house, CO to rear (point of replacement by Curtis) was laid in by someone unknown.

C67448 N.C. 5640 E. 21st #12 Dean Saffer 7-19-78 4" PVC T. to Bldg. To M.H. Stub 3+15.4  
C67449 N.C. 5640 E. 21st #11 Dean Saffer 7-19-78 4" PVC T. to Bldg. To Stub in M.H.?