


S. S. No. 20
LAT. 11 - DIST. A

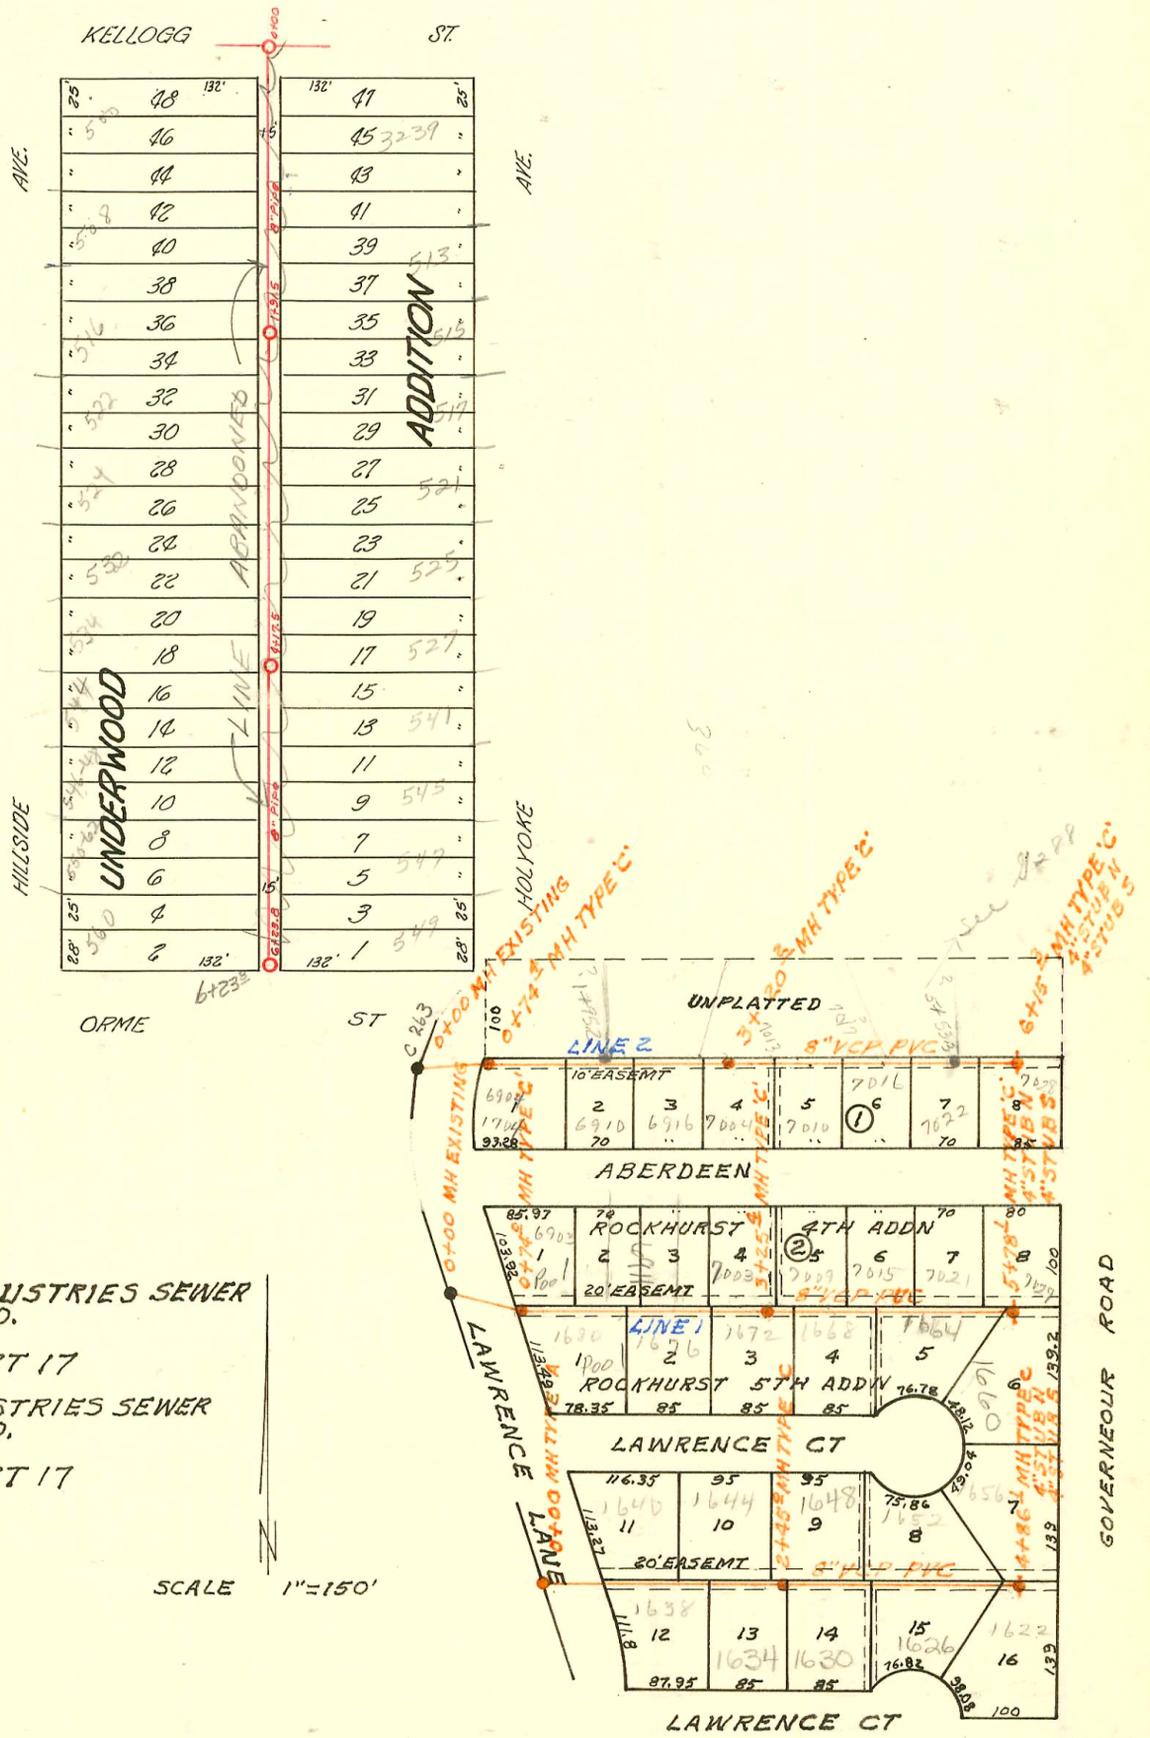

LATERAL 8 MAIN 20 WAR INDUSTRIES SEWER
BUILT BY: ARKANSAS CONST. CO.
PROJ. N^o DBKL 577089
BOOKED 12-6-78 FROM MRT 17

LATERAL 9 MAIN 20 WAR INDUSTRIES SEWER
BUILT BY: ARKANSAS CONST. CO.
PROJ. N^o DBKL 577115
BOOKED 12-7-78 FROM MRT 17

SCALE 1"=150'

