


SECTION B-DIST R.  
S.S. #20  
H.L. MILES  
1927

SCALE 1"=150'

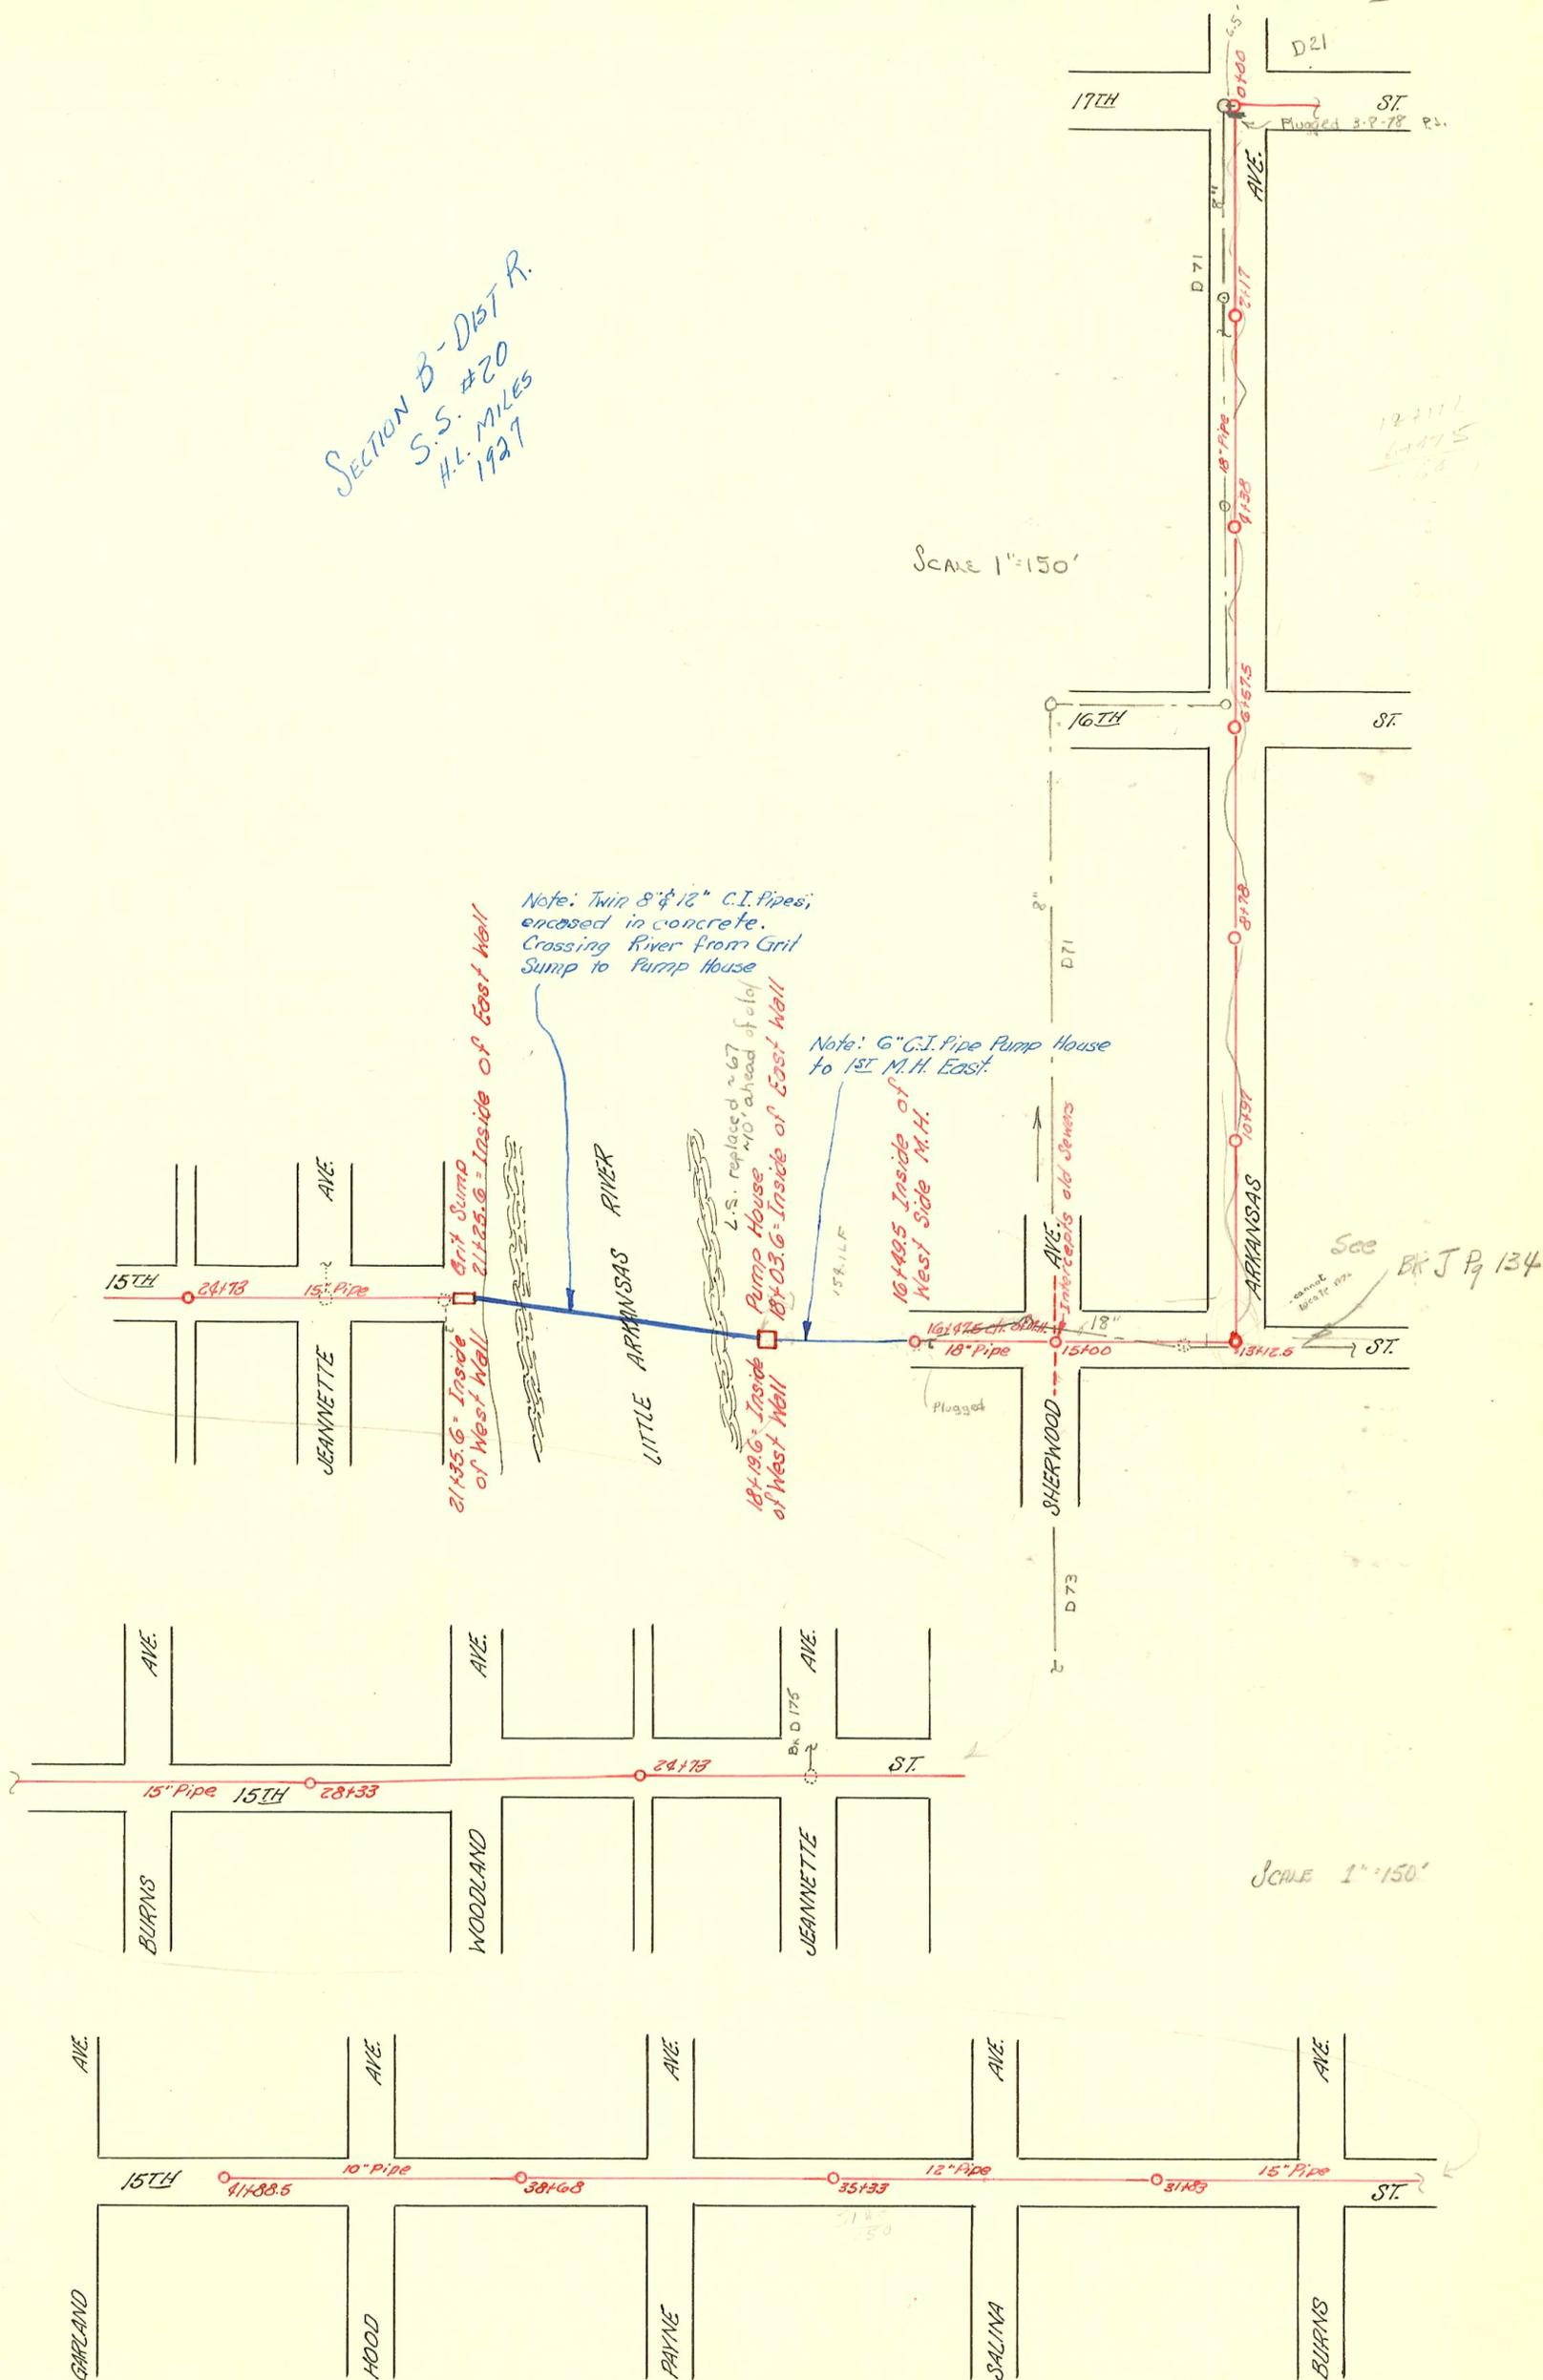

Note: Twin 8" & 12" C.I. Pipes, encased in concrete. Crossing River from Grit Sump to Pump House

Note: 6" C.I. Pipe Pump House to 1st M.H. East

21435.6 Inside of West Well

18419.6 Inside of West Well

16449.5 Inside of West Side M.H.

See BR J P 134

SCALE 1"=150'

CONSTRUCTION RECORD						SERVICE RECORD						
STATION	ELEVATION		Depth	MANHOLE	4-INCH "Y" BRANCHES		No. of Permit		House Number		DATE OF PERMITS	
	Ground	Grade			North West	South East	North West	South East	North West	South East	North West	South East
0+00	119.87	112.19	7.68	0+00								
1+00	119.67	112.29	7.38									
2+00	119.87	112.39	7.48	2+17								
3+00	119.57	112.49	7.08									
4+00	119.37	112.59	6.78	4+38								
5+00	119.23	112.69	6.54									
6+00	118.90	112.79	6.11	6+57.5								
7+00	119.29	112.89	6.40									
8+00	119.01	112.99	6.02	8+78								
9+00	118.97	113.09	5.88									
10+00	118.50	113.19	5.31	10+97								
11+00	119.56	113.29	6.27									
12+00	118.96	113.39	5.57									
13+00	119.18	113.49	5.69	13+12.5								
14+00	119.33	113.59	5.74									
15+00	119.22	113.69	5.53	15+00								
16+00	118.55	113.79	4.76									
16+47.5	115.83	110.0 In 113.84 Out	5.83 1.99	16+47.5								
17+00	113.97	109.90	4.07									
18+00	113.37	109.70	3.67	18+03.6								
		102.0										
		103.0										
19+00				18+19.6								
20+00												
21+00												
21+41.3				21+25.6								
21+52.7				21+35.6								
21+50	121.40	106.50	14.90									
22+00	121.22	106.57	14.65									
23+00	119.40	106.72	12.68									
24+00	119.33	106.87	12.46	24+73								
25+00	119.05	107.02	12.03									
26+00	118.81	107.17	11.64									
27+00	119.49	107.32	12.17									
28+00	119.64	107.47	12.17	28+33								
29+00	120.24	107.62	12.62									
30+00	120.09	107.77	12.32									
31+00	120.50	107.91	12.59									
31+83	120.45	108.03 Out 108.23 In	12.41 12.17	31+83								
32+00	120.50	108.31	12.19									
33+00	121.10	108.46	12.64									
34+00	121.38	108.66	12.72									
35+00	122.02	108.81	13.21	35+33								
36+00	120.72	108.96	11.76									
37+00	119.56	109.11	10.45									
38+00	120.03	109.28	10.75									
38+68	120.52	109.38 Out 109.54 In	11.14 10.98	38+68								
39+00	120.64	109.59	11.05									
40+00	121.14	109.74	11.40									
41+00	121.03	109.90	11.13									
41+88.5	121.39	110.03	11.36	41+88.5								

12-21  
105-15

#476 Tap 1557 Salina 5-8-30 J.E. Lansdowne  
 #2591 Tap (for Private Line) 1555 Ferrell Dr. 8-20-40 J.E. Lansdowne