


S.S. No. 20
LAT. L-DIST. T
W.B. CARTER 1945

1" = 80'

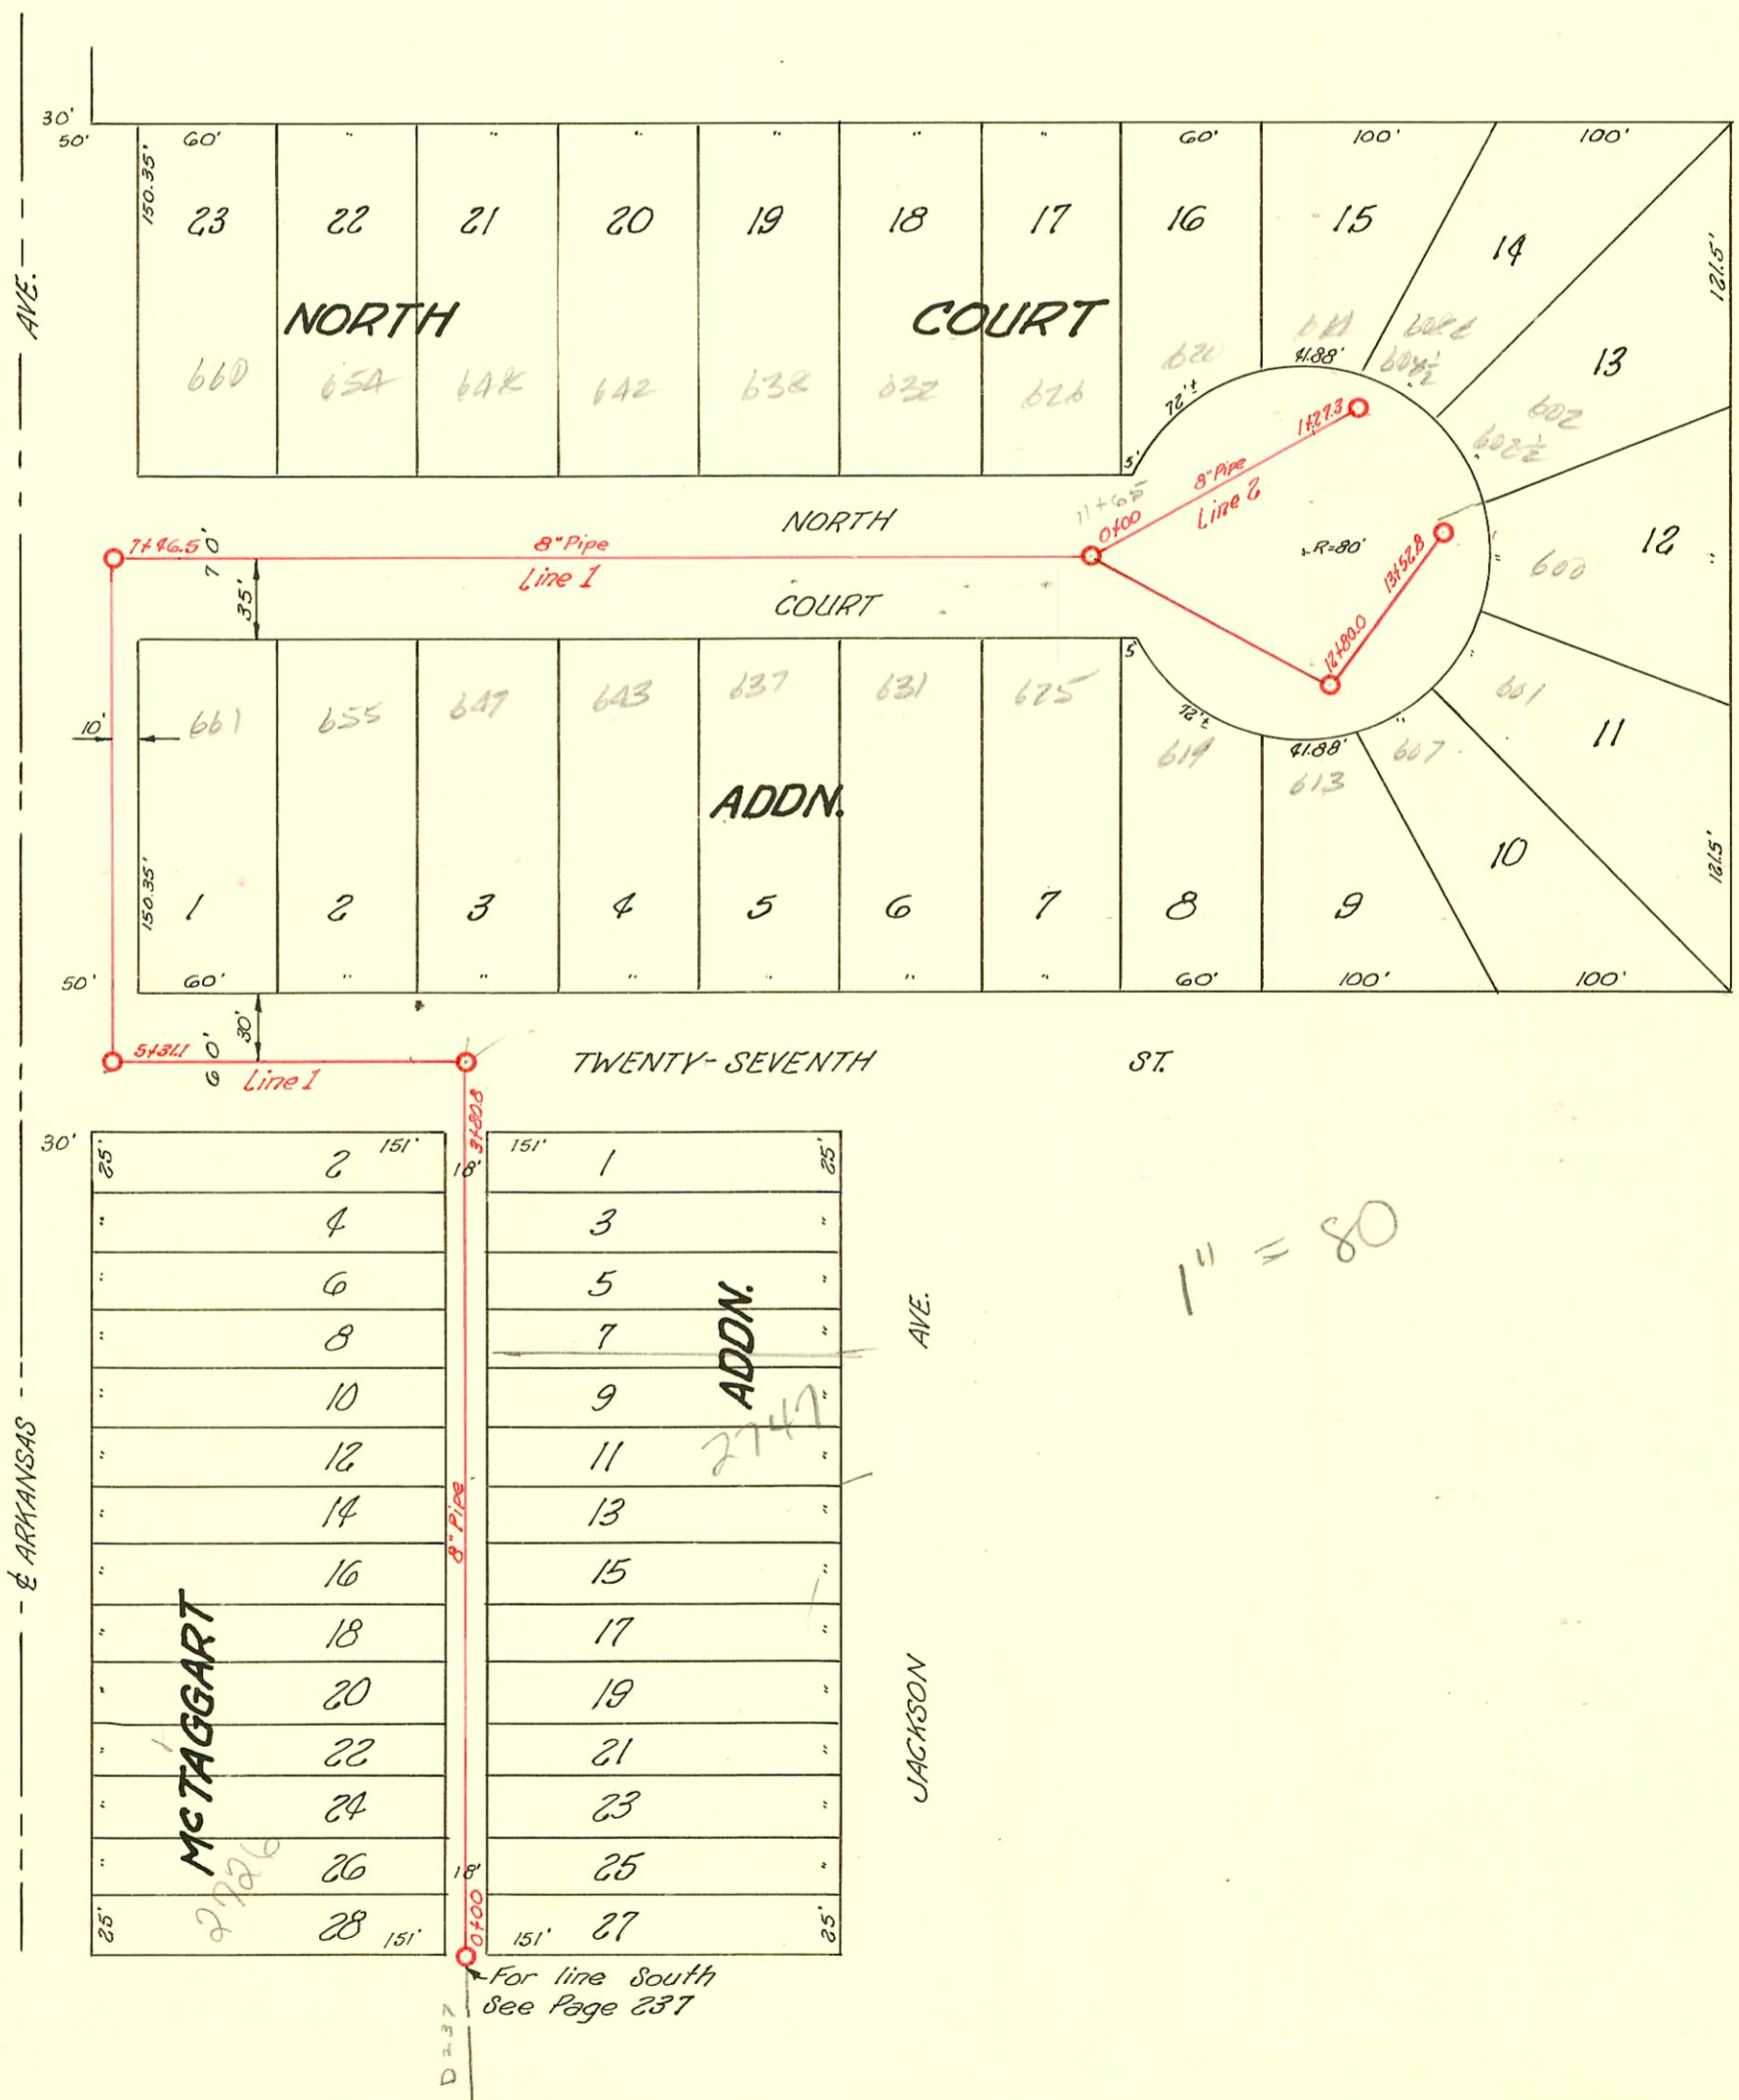

1" = 80'

For line South
See Page 237

D 237

CONSTRUCTION RECORD

SERVICE RECORD

STATION	ELEVATION		Depth	MANHOLE	4-INCH "Y" BRANCHES		No. of Permit		House Number		DATE OF PERMITS	
	Ground	Grade			North West	South East	North West	South East	North West	South East	North West	South East
0+00 3+63.8 M.H. Page 237	126.0	119.08	6.92	0+00 A1 Key E. of Arkansas	0+05.0 0+08.0 0+35.5 0+57.0 0+80.8	0+05.0 0+32.5 0+54.0 0+77.8	#3877 #3878	#831	2726 Arkansas 2730 Arkansas	2731 Jack 507	2-21-51 2-21-51	7-12-49
1+00	125.9	119.18	6.72		1+04.7 1+29.4 1+54.3 1+77.5	1+01.7 1+26.4 1+51.3 1+74.5	#693 #822 #5389		2737 Jack 507 2743 Jack 507		4-1-52 7-11-49	
2+00	125.7	119.28	6.42		2+06.0 2+30.6 2+54.0 2+79.2	2+03.0 2+27.6 2+51.0 2+76.2	2001-00754 #3467		2742 Arkansas 2747 R Jack 507	7-30-51 1-4-57 2-27-50	4-4-01 2-27-50	
3+00	125.6	119.38	6.22		3+05.5 3+31.5	3+02.5 3+28.5	#932	#498	2760 Arkansas	2757 Jack 507	8-8-43	8-10-46
3+80.8	126.0	119.46 119.54	6.46	3+80.8	1 Stub N.E. 1 " N.N.E.	Stub N.E. Stub N.N.E.	#36 #2848 C. 76044		643 N. Court 649 N. Court		5-15-47 3-20-46 1-9-49	
4+00	126.1	119.56	6.54		4+01.0 4+66.0		26224 #55		655 N. Court		9-17-47 5-21-47	
5+00	126.4	119.66 119.69 119.77	6.74			5+31.1						
6+00	126.5	119.84	6.66									
7+00	126.8 126.7	119.94 119.99 120.07	6.86			7+46.5						
					7+58.0 7+85.0	7+61.0 -	#2300		660 N. Court		9-24-45	
8+00	127.3	120.12	7.18		8+14.8 8+49.5	8+17.8 -	#1875		654 N. Court		4-24-47	5-21-47
9+00	127.2	120.22	6.98		9+08.8 9+34.3 9+66.0	8+74.8 9+37.3 -	#2284 #2271		648 N. Court 642 N. Court		9-14-45 9-7-45	
10+00	127.0	120.32	6.68		10+27.9 -	10+00 10+47.1	#1637		638 N. Court		3-18-47	
					10+56.0 10+87.0	10+59.0 -	#2388		632 N. Court	637 N. Court	11-6-45	11-12-45
11+00	126.9	120.42	6.48		11+17.3 11+65.0	11+09.0 11+40.0 11+69.2 11+99.2	#1865	#1820 #2242	624 N. Court 631 N. Court 625 N. Court		1-5-49	3-20-48 3-17-49
12+00	128.1	120.60	7.50			12+40.2 12+66.4 12+93.2		#2919 #1112	619 N. Court 613 N. Court		4-9-46 11-14-47	
13+00	128.4 128.7	120.68 120.76 120.78	7.92		12+80 (1 Stub SSE)	13+06.1 13+25.3 13+45.8 13+48.8 13+51.8		#250 #2932 #6470	607 N. Court 601 N. Court 600 N. Court		6-12-46 4-11-46 11-16-51	
O.H.	129.1	120.84	8.26		13+52.8							
14+00	127.8	120.57	7.23	0+00	0+14.4 0+37.6 0+77.0		#475		620 N. Court		8-2-46	
1+00	128.6	120.67	7.93		1+05.2							
	128.7	120.70	8.00	1+27.3								

LINE #1

LINE #2

beg. 11+65.0 Above

#2250 Tap at 13+52.8 602 N. Court 8-27-45 Fredrick Pibg. Co.
 #2251 Tap at 11+27.3 608 N. Court 8-27-45 Fredrick Pibg. Co.
 #2710 Tap 601 N. Court 2-18-46 Fredrick Pibg. Co. Conn. in Real