


DIST. G - S.S. NO. 20
1919

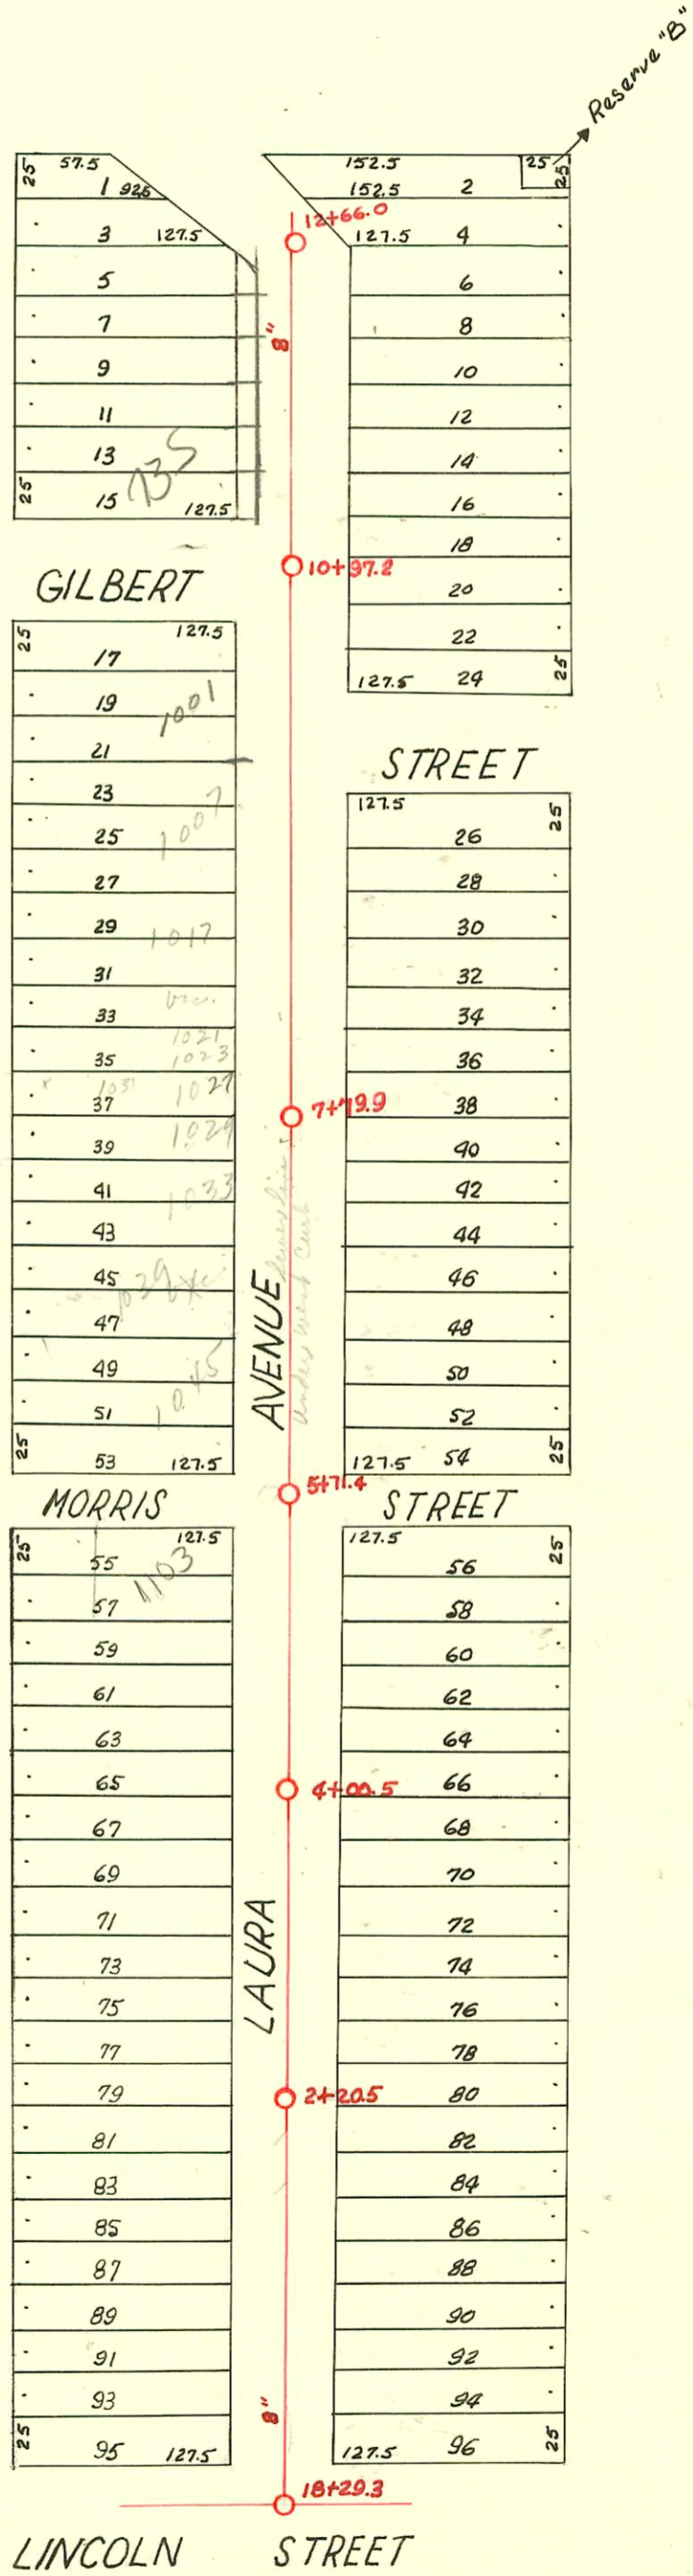

CONSTRUCTION RECORD						SERVICE RECORD						
STATION	ELEVATION		Depth	MANHOLE	4-INCH "Y" BRANCHES		No. of Permit		House Number		DATE OF PERMITS	
	Ground	Grade			North West	South East	North West	South East	North West	South East	North West	South East
				+66.0								
12	107.04	100.41	6.63		+60.5 +35.0 +10.0							
11	107.09	100.26	6.83	+97.2	+82.8 +57.4 4" SCH 40 11+33.2 +32.4		2552 #687	735 R Laura		6-21-02 5-8-23		
10	107.25	102.11	5.14		10+42.8 +19.4		C38571	1001 Laura		4-30-75		
9	107.00	99.96	7.04		+93.0 9+67.7 +43.5 +18.2		#493	1007 Laura		11-7-22		
8	107.42	99.81	7.61		4" SCH 40 8+90.6 +57.9 +43.2 4" SCH 40 +18.0		2002-00555 #266	1017 (R) Laura		2-25-02 4-8-20		
8	107.42	99.81	7.61	7+79.9	7+93.1 7+68.4 7+42.8 7+18.0		2000-00079 684	1023 R Laura	SEE Below	1-12-00 8-29-47		
7	107.15	99.66	7.49		7+94.1 7+68.9 7+43.5 7+28.3		#1742 #1775	1027-20 Laura 1033 Laura		12-16-48 12-3-23		
6	107.45	99.51	7.94	5+71.4	5+89.1 +37.6 +12.4		#18670 #175	1039 LAURA		4-6-70		
5	107.12	99.36	7.76		+87.4 +37.0 +11.8		#1039 1110	1045 Laura	1045 Laura	3-2-20		
4	107.05	99.21	7.84	+100.5	5+87.4 +37.0 +11.8		#867	1120 E. MORRIS		6-5-23		
3	107.30	99.06	8.24		+86.5 +60.6 +36.0 +10.8		#1039 1110	1107 Laura		9-24-28 7-26-23		
2	107.25	98.91	8.34	+120.5	+86.5 +60.6 +36.0 +10.8		#341	1117 Laura		4-30-20		
1	107.35	98.76	8.59		+85.7 +60.7 +36.0 +11.0 +86.0 +61.3 +35.4		#1034 #902	1129 Laura 1161 Laura		5-6-24 8-17-25		
0400	107.50	98.61	8.89		+11.0 +86.4 +60.8 +36.0		#1040 #753	1149 Laura 1151 Laura		12-1-26 4-9-24		

#144 Tap 1131 Laura 2-18-28
 #5914 Tap 1141 Laura 9-21-51 Harry Mann
 2000-00079 1023 S Laura 11200 Mies Const. 4" SCH 40 38' N of MH 7179.9 (8+17.9) Sidewalk cut - ITWIN CO, 1V22, 3H22