


DIST. G - S.S. NO. 20
1919

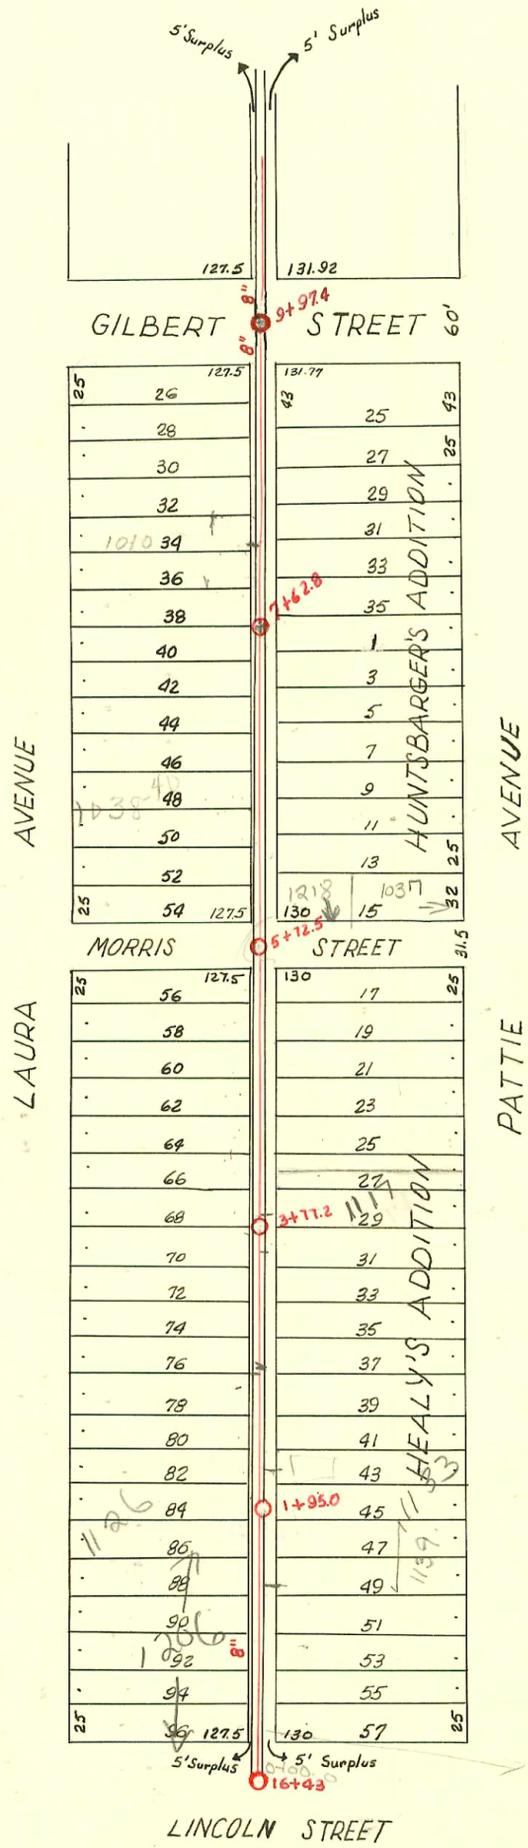

plat 9-57

Vac ord. 2421
2232
Alley may not exist
any more or be
shortened to 10'
BR
319193

CONSTRUCTION RECORD						SERVICE RECORD						
STATION	ELEVATION		Depth	MANHOLE	4-INCH "Y" BRANCHES		No. of Permit		House Number		DATE OF PERMITS	
	Ground	Grade			North West	South East	North West	South East	North West	South East	North West	South East
				9 + 97.4	+44.8	+42.3						
9	108.58	100.11	8.47		+20.8	+18.3	#448	72	1002 Laura		8-29-31	2-14-21
					+92.6	+90.1	#1047	#1293	1004 Laura	1003 Pattie	9-25-28	10-4-22
					+69.0	+66.5		#525	1007 Pattie			6-24-20
					+44.0	+41.5						
8	108.53	99.91	8.62		+18.9	+16.4	#2232	#428	1010 Laura	1011 Pattie	9-5-50	5-22-20
					+93.6	+91.1	#564		1014 Laura		5-16-29	
				7 + 62.8	+71.9	+69.4		#1067		1015 Pattie		12-11-30
					+43.7							
					+26.2	+41.2						
7	108.38	99.71	8.67		+01.0	+23.7		#217		1017 Pattie		3-26-20
						+99.5						
					+76.1	+73.6						
					+51.1	+48.6	#3838	#684	1032-40 Laura	1021 Pattie	4-19-73	8-9-21
					+26.5	+23.8	#23367	#285	1037 Pattie		6-3-91	6-6-91
					+02.5	+0.00	#704		1044 Laura		5-9-23	4-16-20
6	108.28	99.51	8.77									
				5 + 72.5	+43.9	+41.4	#595		1100 Laura		3-27-24	
					+19.5	+17.0	#2730	#497	1100 1/2 Laura	1101 Pattie	2-26-46	4-9-23
5	108.65	99.31	9.34									
					+96.8	+94.3	#766	#865	1106 Laura	1107 Pattie	4-10-24	10-12-27
					+72.2	+69.7						
					+36.1	+32.6	#444	#263		1111 & 1115 Pattie		5-27-20
					4 + 09.2	+06.7	#1574		1112 Laura		3-7-47	2-21-24
4	108.80	99.11	9.69									
				3 + 77.2	3 + 85.2	3 + 82.7		#1296		1115 Pattie		8-31-23
					3 + 60.7	3 + 58.2	#840	#416	1118 Laura		4-16-24	
					3 + 35.8	4 + 32.3	#763	25599	1120 Laura	1117 5/10 Pattie	7-10-25	6-21-90
					3 + 11.2	+08.7						
3	108.73	98.91	9.82									
					2 + 86.0	+83.5	9648	#2504	1122 1/2 Laura	1129 Pattie	3-19-59	3-31-20
					2 + 60.8	+58.3						
					2 + 37.7	2 + 35.2	#1009	#284		1133 Pattie	11-22-26	4-16-20
					2 + 12.4	+09.9	#879		1124 Laura	1129 Pattie	8-8-25	
2	108.53	98.71	9.82									
				1 + 95.0	+87.5	+85.0	#1061		1146 Laura		5-8-24	
					+62.2	+59.7		#1113		1139 Pattie		1-15-24
					+37.5	+35.0						
					+12.9	+10.4		#1232		1137 Pattie		8-20-23
1	108.28	98.51	9.77									
					+87.9	+85.4						
					+63.0	+60.5						
					+37.5	+35.0		#1007		1149 Pattie		7-10-23
0400	107.89	98.31	9.52									

231627 - #1286 Tap Rear of 1037 Pattie 9-30-29 J.E. Landowine - Kent Burgon
 #236 Tap 1206 E. Lincoln 2-23-43 Pray Pkg. Co.
 #852 Tap 1206 E. Lincoln 10-2-47 Buegan Pibg.
 #43-4695-7 - 1120 Laura - R - 4" SDR 35 - 4" Wye - 41.5' south
 Replaced lower 15' - 14" pf - (3+35.7)