



DIST. G - S.S. NO. 20
1919

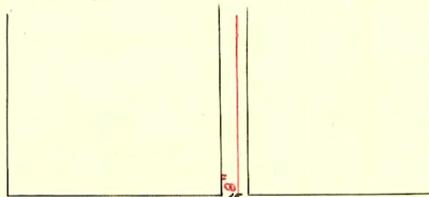

28' util ease platted
along all of Day
Addition


GILBERT ST. 157

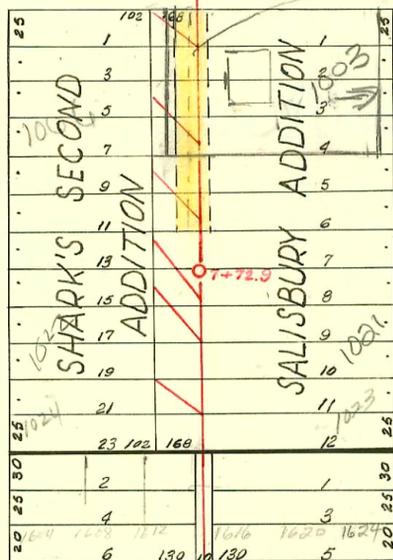

EASEMENT #805 - Sept. 9, 1919
AD Salisbury & Leona Salisbury, his wife,
Bag. 190' West of the N.E. corner of
Lot 1, Hydraulic Ave. Salisbury Addition,
thence South to South line of Lot 6,
Hydraulic Ave, Salisbury Addition,
thence West 10' thence North to North
line of Lot 1, Hydraulic Ave, Salisbury
Addition, thence East to place of beginning.

AVE.
FANNIE (NOV GREENWOOD)

MORRIS ST. 130

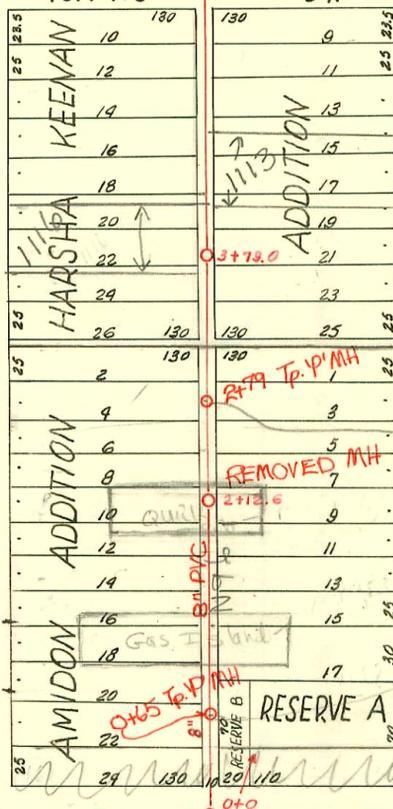

See N96

LINCOLN ST. 159.0

2001-00963-4/23/01-1116 Greenwood - Acacia Leaks - 4" SCH 40
City Repair Predco 15.6' N of MH 3779 (3774.6) Fernco to clay
1422, 1445

2001-03197-12/17/01-1113 S Hydraulic - McClung's - 4" SCH 40 64' N of MH 3779 (443) Predco Saddle - 2 TWIN CO, 1422

