



LATERAL 95 MAIN 4 SAN SEWER No 23
BUILT BY: W.B. CARTER CONST. CO.
PROJ. No 468-76-245-80557-000-000-001
BOOKED 2-13-79 FROM LES 14

on map

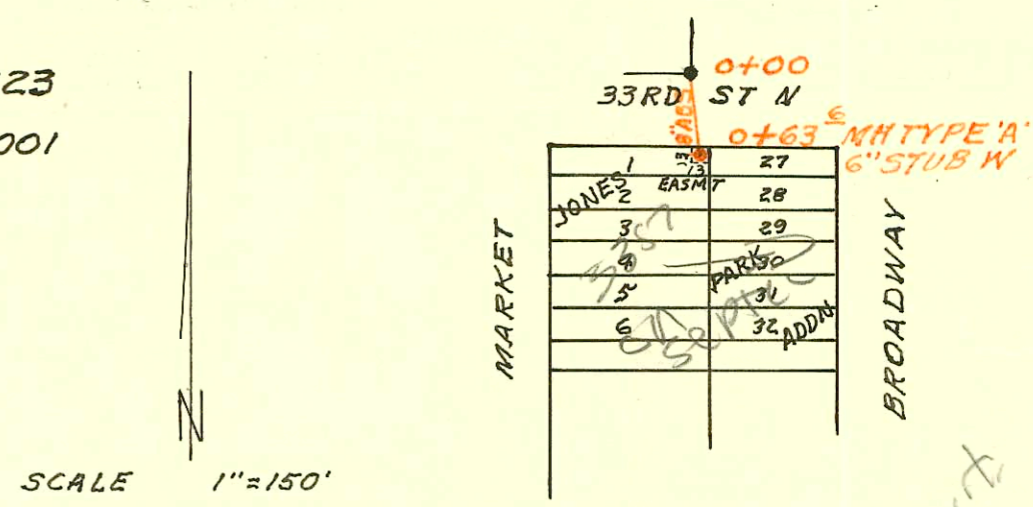


LATERAL 96 MAIN 4 SAN SEWER No 23
BUILT BY: UTILITY CONTR. INC.
PROJ. No 468-76-245-80566-000-000-001
BOOKED 2-13-79 FROM LES 14

on map

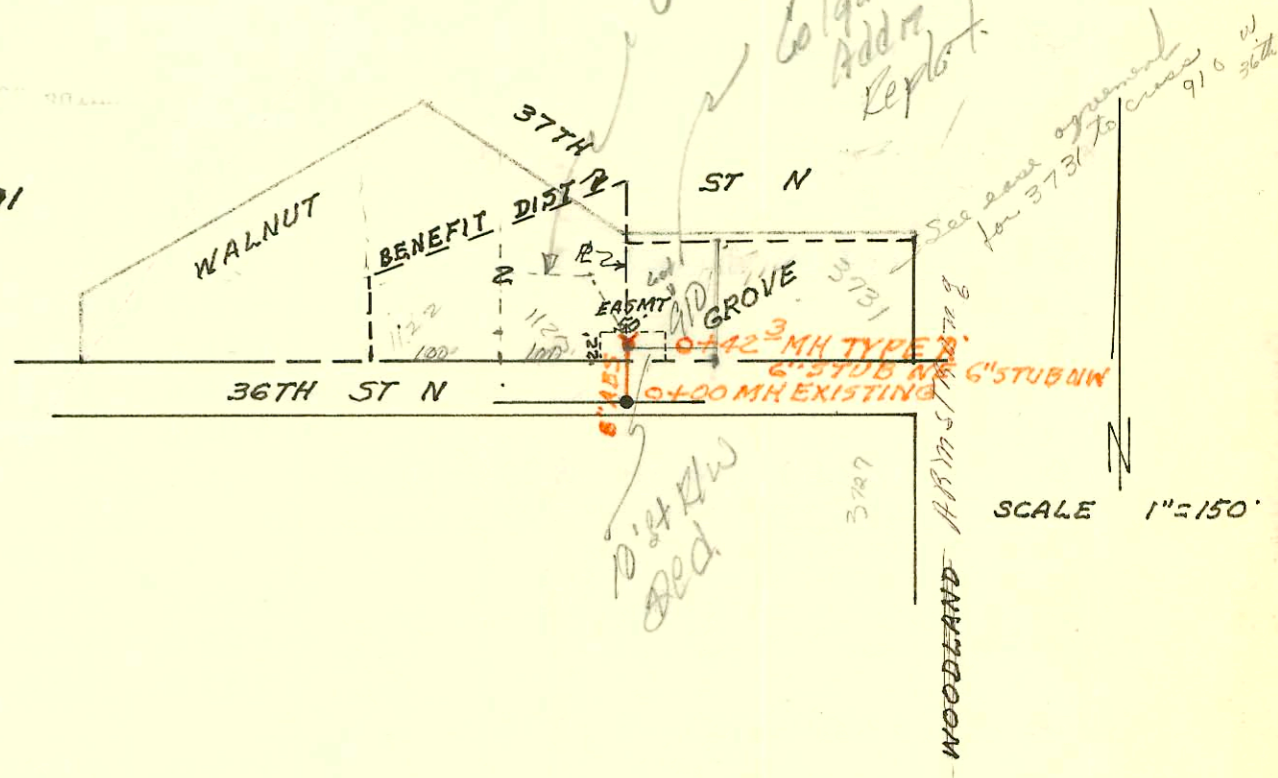

LATERAL 62 MAIN 17 SAN SEWER No 22
BUILT BY: MID STATES CONST. CO.
PROJ. No 468-76-245-80453-000-000-001
BOOKED 2-14-79 FROM LES 16

on map

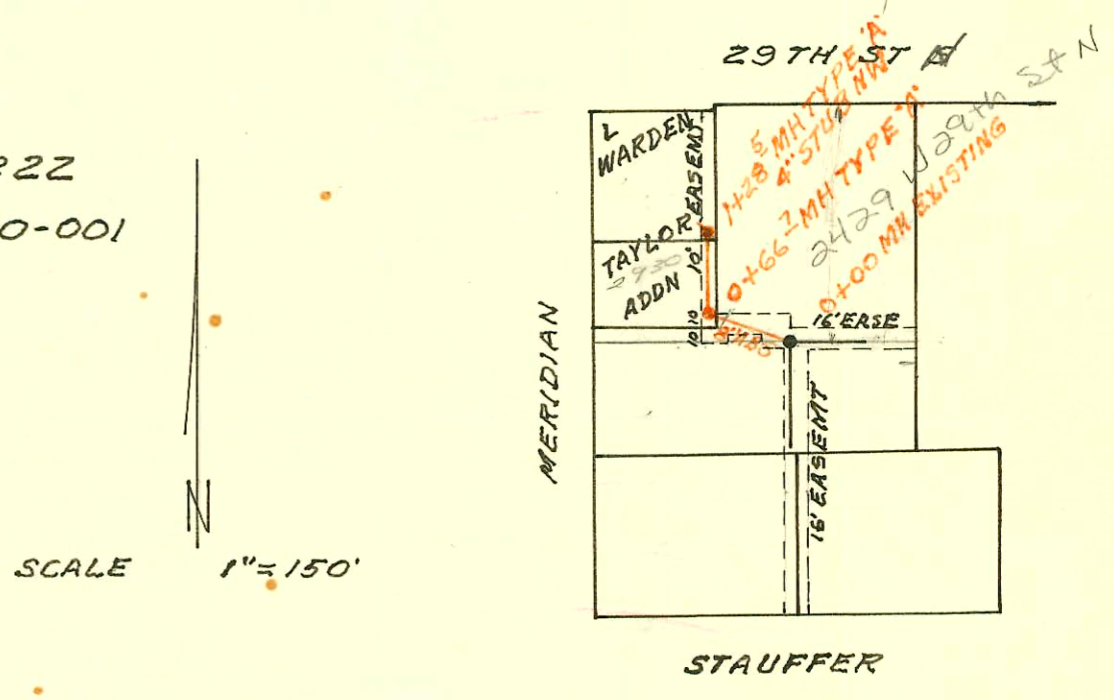

CONSTRUCTION RECORD

SERVICE RECORD

STATION	ELEVATION		Depth	MANHOLE	4-INCH "Y" BRANCHES		No. of Permit		House Number		DATE OF PERMITS	
	Ground	Grade			North West	South East	North West	South East	North West	South East	North West	South East
LAT 46 MAIN 1 SW1 (Cont'd)												
LINE 2 CONT 14+00	81.0	OUT 76.68 IN 76.78	4.3 4.2	14+00.8		13+50.8 ^{top} 14+20.8 ^{top} 14+68.6		#00296 2291 C75039	1226 1222 1218 Jolewild			5-14-80 1-14-81 10-24-79
15+00	82.5	77.08	5.4									
16+00	82.7 82.0	77.38 77.94	5.3 4.4	16+88.1		16+64.1 ^{top}		C72051	1212 Jolewild			5-30-79
17+00	82.7	77.78	4.9			17+35.1 ^{top}		660	1208 Jolewild			6-30-80
18+00	83.4	78.08	5.3			18+27.1		#00014	1204 Jolewild			4-7-80
19+00	83.9 82.5	78.38 78.54 78.64	5.5 4.0 3.9	19+54.6		19+36.6 19+58.6		C76466 C76743	5205 S. Lulu 5211 Lulu			2-8-80 3-10-80
20+00	84.4	78.78	5.6									
21+00	83.7	79.08	4.6			21+05.1 15' N. of SW Cor. of Property		C76742 2768	5219 Lulu 5225 Lulu			3-10-80 3-4-81
22+00	83.1 82.5	79.38 79.46	3.7 3.0	22+27.1	4" STUB NE	4" STUB SE		C70741 C71501	5229 S. Lulu 52nd St.		3-10-80	4-30-79
LINE 3 0+00	80.5	75.01	5.5	0+00=38+79.5 LINE 2								
1+00	80.5	75.31	5.2									
2+00	80.0	75.61	4.4			2+31.8						
3+00	79.1 79.0	75.91 75.95 76.05	3.2 3.1 3.0	3+14.6		3+20.1 ^{top} 3+31.6		C72058 2913	1403 Jolewild 1402 52 ST SO 1524 E 52nd ST			12-3-79 3-12-79 5-30-79 3-23-81
4+00	79.2	76.31	2.9			4+01.2 ^{top} 4+45.8 ^{top} 5+92.1 ^{top} 5+92.1 ^{top}		#41012 C72434 1333 1319 Jolewild 1309 Jolewild 1315 Jolewild 1203 Jolewild #22020	1393 Jolewild 1319 Jolewild 1309 Jolewild 1315 Jolewild 1203 Jolewild			3-9-81 6-20-79 9-23-80 3-2-81 5-30-79 3-26-81 1-8-81
5+00	79.5	76.61	2.9			5+18.6 ^{top} 5+40.8 ^{top}		1558 #02733 2482 C72057	1407 Jolewild 1402 52 ST SO 1524 E 52nd ST			10-22-80 3-2-81 5-30-79
6+00	80.0	OUT 76.91 IN 77.01	3.1 3.0	6+00.4		6+47.6 ^{top} 6+94.2 ^{top}		2950 2311 #22020	1203 Jolewild 1209 Jolewild			3-26-81 1-8-81
7+00	80.1	77.31	2.8			7+01.4 7+82.1 ^{top}		C73251 2243 C70068	12125 52nd ST 5224 Jolewild			8-1-79 1-2-81 1-8-79
8+00	80.3 81.0	77.61 77.79	2.7 3.2	8+59.6	4" STUB NE			C71145	5212 Lulu			3-10-80
LINE 4 0+00	80.5	74.07	6.4	0+00=5+98.6 LINE 2								
1+00	79.0 78.5	74.37 74.47	4.6 4.0	1+35.0								
LATERAL 95 MAIN 4 SAN SEWER No 23												
0+00	130.5 131.0	125.01 125.27	5.5 5.7	0+00 EXISTING 0+63.6	6" STUB W			C70357	384971 Broadway			2-27-79
LATERAL 96 MAIN 4 SAN SEWER No 23												
0+00	133.5 133.9	126.96 127.13	6.5 6.8	0+00 EXISTING 0+42.3	6" STUB NW 6" STUB NE			8309 5494 7998	90 W. 36th St 1120 W 36th St 3731 R Remington 112 W 36th St			6-283 3-24-82 11-8-78 4-29-83
LATERAL 62 MAIN 17 SAN SEWER No 22												
0+00	129.5	122.95	6.6	0+00 EXISTING				2000- 01543	2429 W 29th STN			7-10-00
	129.7	OUT 123.22 IN 123.32	6.5 6.4	0+66.7				C69613	2430 W Meridian			11-30-78
1+00	129.7	123.45 123.56	6.3 6.1	1+28.5	4" STUB NW			269468	2940 W. Meridian			11-17-78

NR 3787- 1208 E 52nd S. 3-9-81 Kenneth Jankus (760.3 - 99.3 E)

NR 2000-01543 - 2429 W 29th STN - Reddi Root - City Tap - 4" Preco - 2 Twin cleanouts, 1-4" Y, 5 H45
 NOTES: OBSTACLE POOL