


LAT. A - DIST. T - S.S. NO. 20
1919

Sewer Repair
April 7, 1989
Without Const
Repaired m.h. and replaced
broken 8" Pipe South
Ender # 180216

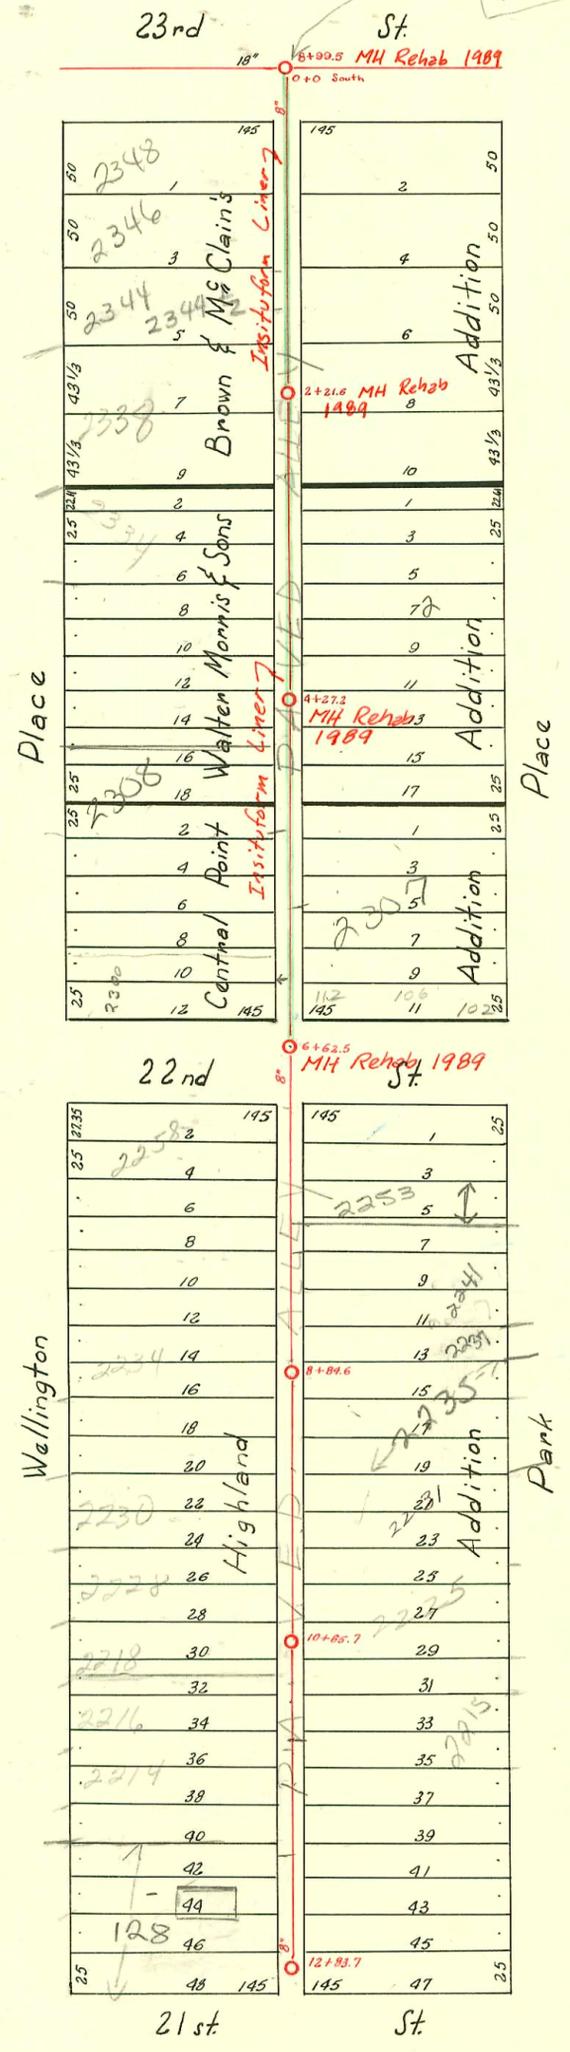

1988 Sanitary Sewer
Reconstruction Program
(Phase 2)
468-81886 (600817)
Built By Insituform Plains

1988 Sanitary Sewer
Reconstruction Program
(Phase III)
468-81886 (600817)
Built By Insituform Plains

Neighbor Rental

SWR 2002-02685 9/27/02 - n/c - 2235 N Park Pl - Overnight - Predco Saddle 46'5 of MH 8184.6 (9+30.6)
2022, Paved alley cut, TWIN CO

#93-7624-7-2335 N. Park Place - 4/9/93 - 5/0 6' from main and 111' north
of M.H. (3116.2) No alley cut - 4' Clay tile line

CONSTRUCTION RECORD						SERVICE RECORD						
STATION	ELEVATION		Depth	MANHOLE	4-INCH "Y" BRANCHES		No. of Permit		House Number		DATE OF PERMITS	
	Ground	Grade			North West	South East	North West	South East	North West	South East	North West	South East
0+0	123.66	114.55	9.11	0+0	+37.5	+40.0	#290	#2575	2348 Wellington	2349 Park Pl.	3-28-25	11-20-24
					+62.8	+65.3						
					+88.0	+90.5		#2574		2347 Park Pl.		11-20-24
1	122.41	114.75	7.66		+13.3	+15.8	#1351		2346 Well. Pl.		6-9-24	
					+38.3	+40.8	#1734		2344 1/2 Well. Pl.		6-19-24	
					+63.5	+66.0	#1504		2346 Well. Pl.		9-6-49	
					+88.7	+91.2	#1810	#2515	2348 Wellington	2345 Park Pl.	11-10-44	12-4-45
2	122.66	114.95	7.71		+13.2	+15.7						
				2+21.6	+38.0	+40.5	#1399		3338 Well. Pl.		8-9-71	
					+63.3	+65.8	#2743		2340 Wellington	2343 Park Pl.	6-22-72	11-10-48
					+88.4	+90.9						10-17-50
3	124.46	115.15	9.31		+13.7	+16.2	#932		2334 (P) Wellington	2335 Park Pl.	10-13-81	
					+38.4	+40.9	#628	#1840	2328 Well. Pl.	2329 Park Pl.	2-20-73	8-24-25
					+64.0	+66.5	#1315	#1839	2319 Well. Pl.	2327 Park Pl.	10/31/72	8-12-24
					+89.0	+92.5					6-5-24	8-12-24
4	124.54	115.35	9.19		+14.2	+16.7	#1582		2326 Well. Pl.		7-9-24	
				+27.2	+39.3	+41.8	#1524			2319 Park Pl.		7-1-24
					+63.8	+66.3	#2112			2317 Park Pl.		9-16-24
					+89.8	+92.3	#1339	#2278	2308 Well. Pl.	2311 Park Pl.	12-9-22	10-9-24
5	124.84	115.55	9.29		+14.3	+16.8	#1539		2308 Well. Pl.		10-11-41	
					+39.0	+41.5	#1445		2332 Well. Pl.		6-20-24	
					+66.8	+69.3	#1444	#2034	2330 Well. Pl.	2307 (R) Park Pl.	6-20-24	8-8-24
					+92.3	+94.8	#1235		2304 Well. Pl.		5-29-24	
6	125.69	115.75	9.94		+17.4	+19.9	#1289	#66	2300 Well. Pl.		6-4-24	2-1-22
7	125.11	115.95	9.16		+02.5	+05.0	#1203	#1843	2258 Well. Pl.	2245 Park Pl.	6-16-74	
					+26.8	+29.3	#253	#1441	2257 Well. Pl.	2253 Park Pl.	5-26-24	12-14-23
					+52.5	+58.0	#1827	1827			3-20-25	9-28-23
					+78.0	+80.5				2251 Park Pl.		12-12-23
8					+02.8	+05.3	#3424			2239 Park Pl.		5-5-41
					+28.2	+30.7	#983			2239 Park Pl.		7-5-23
					+51.0	+53.5	#1111		2240 Well. Pl.		10-7-25	
					+77.6	+80.1	#1208	#314	2234 Well. Pl.	2245 (S.O.) Park Pl.	5-26-24	3-29-73
9	126.31	116.35	9.96		+03.4	+05.9	#1621	#1419	2232 Well. Pl.	2235 Park Pl.	3-18-47	9-25-23
					+29.0	+31.5	#720	#315	2230 Well. Pl.	2232 Park Pl.	6-30-25	3-3-23
					+53.8	+56.3						
					+79.0	+81.5						
10	126.98	116.55	10.43		+03.2	+05.7	#1101	#1411	2214 Well. Pl.	2220 Park Pl.	5-13-24	3-29-73
					+29.5	+32.0	#87	#1457	2228 Well. Pl.	2227 Park Pl.	2-18-25	9-25-23
					+54.6	+57.1	#1389			2225 Park Pl.		10-2-23
					+79.8	+82.3	#1448	#1475	2216 Well. Pl.	2219 Park Pl.	6-20-24	10-5-23
11	124.88	116.75	8.13		+05.1	+07.6	#311			2219 Park Pl.		4-5-29
					+30.2	+32.7	#5895	#1517	2222 Well. Pl.	2215 Park Pl.	7-22-53	11-10-22
					+55.3	+57.8	#1183		2208 Well. Pl.	2213 Park Pl.	5-22-24	3-7-79
					+80.2	+82.7	#1182		2206 Well. Pl.		5-22-24	
12	124.08	116.95	7.13		+05.6	+08.1	#1440			2205 Park Pl.		9-28-23
					+30.0	+32.5	#5891	#472	2203 Well. Pl.	2203 Park Pl.	7-27-53	5-9-22
					+61.0	+63.5						
				12+83.7								

59123-2231 Park Place -12-16-76
 59126-2225 Park Place -12-16-76
 SO 37981-2317 Park Place - At Kennin 3/29/73 (5+55.2)
 SO C24038-2328 Wellington Pl. - At Kennin - 4/29/71 (3+46.2)
 SO C34536-112 W. 21st - At Kennin - 8/28/72 (39' m of 22" H - 11.8' E. of alley)
 SO C34535-106 W. 21st - At Kennin - 8/28/72 (39' m of 22" H - 66' E. of alley)
 C3286 3-2338 Wellington Pl. Von White 6-12-77 map, 2+38.0
 #5895 - Tap - 122 W. 21st. - 7-22-53 - C.G. Coleman
 #377 - Tap - 2258 Wellington Place - 9-19-36 - Simmons Plbg. Co.
 #193 - Tap - 2309 Park Place - 4-29-37 - Johnson Plbg. Co.
 #2266 - Used old connection - 116-118 W. 21st - 9-4-45 - Davidson Plbg. Co.
 #314 - Tap - 100 W. 21st. - 6-21-46 - R La Foy
 #5840 - Tap - 2240 Wellington Place - 7-18-53 - Coleman Plbg. Co.
 + 1043 - tap - 2342 Wellington Pl. - At Kennin - 8/9/71
 - 8202 - seal off - 2304 Wellington Pl. - At Kennin - 8/9/71
 92-36953-7 10-16-42 - 2214 Wellington - At Kennin - 11+35.7