


LAT. A-DIST. T-S.S. NO. 20

1919

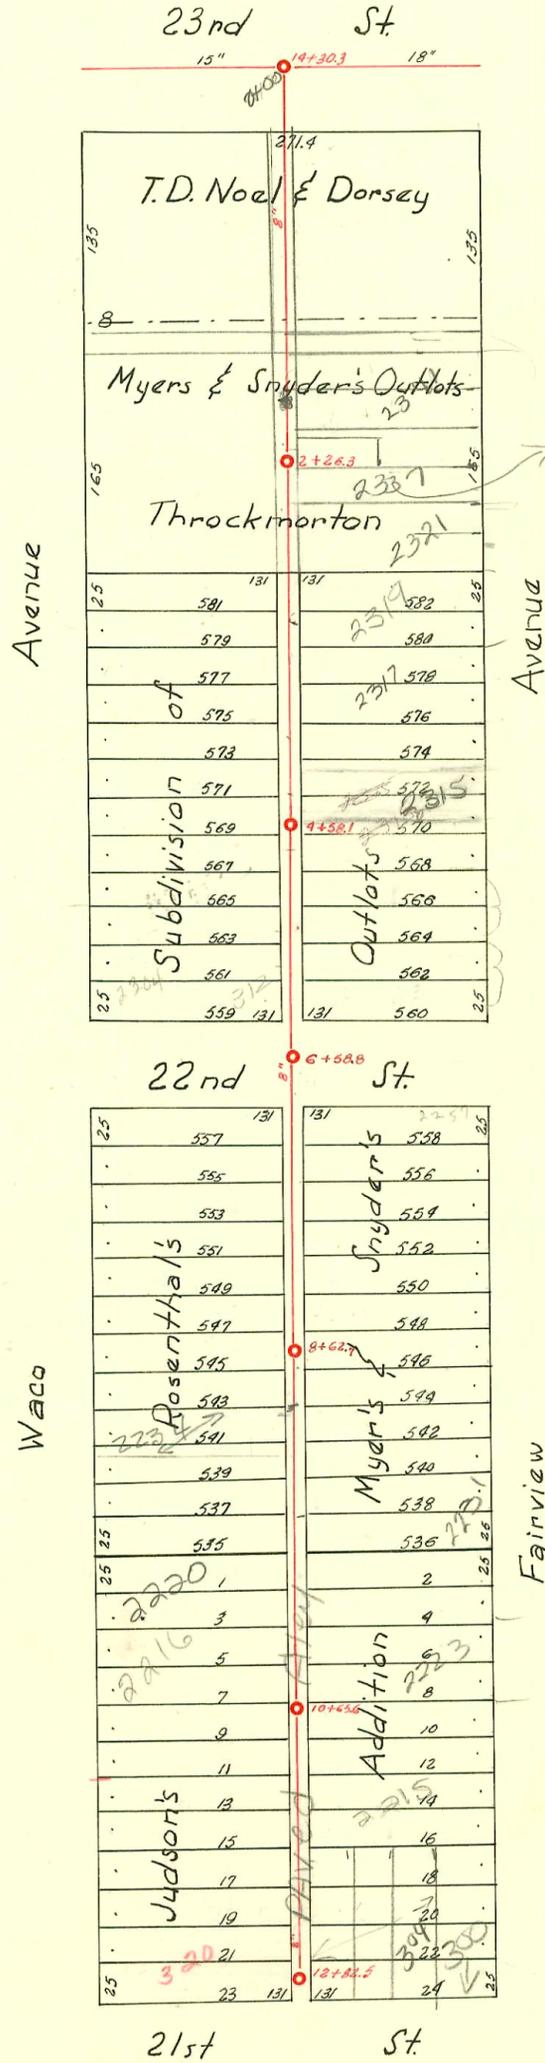

2337 N Fairview  
 Convert New Garage (1999)  
 into single fam dwelling  
 (2001)  
 Wash back  
 Reutilization  
 Area

2001-00554- 3/15/01- 2231 N Fairview Ave- Lubbers Exc- 4" SCH 40, 17WIN CO, 2H22, 2H45 - Tied to PVC at fence line  
 (NOTE: Someone made a repair 1yr ago in alley- See Below)  
 2000-00482- 2/23/00- 2231 N Fairview Ave- Ks Ditching- 4" PVC- CITY REPAIR 115.5' S of MH 8+62.7 (9+78.2)  
 1V22, 1V45

SWR 2001-01498 67801 2337 N/C Fairview - Bowers - 4" SCH 40 - Predco 28' S of MH 2+26.3 (2+54.3)  
 17WIN CO, 1V45, 2H45

D-50

CONSTRUCTION RECORD						SERVICE RECORD						
STATION	ELEVATION		Depth	MANHOLE	4-INCH "Y" BRANCHES		No. of Permit		House Number		DATE OF PERMITS	
	Ground	Grade			North West	South East	North West	South East	North West	South East	North West	South East
0+0	122.65	115.96	7.69	0+0	+36.9	+39.4						
					+61.7	+64.2						
					+88.8	+91.3	#1123	#1169	315 W. 23rd.	311 W. 23rd.	12-13-71	10-23-25
1	124.82	116.16	8.66		+14.3	+16.8		#1335		307 W. 23rd.		12-12-25
					+39.8	+42.3						
					+66.4	+68.9						
					+91.6	+94.1	#1757		2342 N. Waco			12-24-29
2	125.59	116.36	9.23		+17.4	+19.9		#569		2342 N. Waco		7-24-73
				2+26.3				#569		2342 N. Waco		7-1-26
		116.70						#569		2342 N. Waco		9-27-72
					51.3	2+45.6	#284	#1808	2340 N. Waco	2327 Fairview	4-29-71	2-13-64
					+69.2	+71.7	#285		2336 N. Waco			
					+95.4	+97.9		#1809		2321 Fairview		8-7-24
3	126.22	116.56	9.66		+21.5	+24.0	#85	#1027	2332 N. Waco	2317 Fairview	2-9-27	5-5-77
					+47.5	+50.0						7-1-27
					+72.1	+74.6	#338		2322 N. Waco			3-3-24
					+95.6	+98.1		#410		2315 Fairview		4-22-25
4	126.20	116.76	9.44		+20.9	+23.4		#523	2053 2312 N. Waco	2315 Fairview		4-19-88
				4+58.1	+45.9	+48.4		#2459				11-1-24
		116.88			+70.4	+72.9		#1558		2313 Fairview		7-7-24
					+95.8	+98.3	#688		2316 N. Waco			4-4-24
5	126.15	116.96	9.19		+21.7	+24.2	#1029	#24	2310 N. Waco	2311 Fairview	5-6-24	2-2-25
					+47.1	+50.6	#687	#276	2308 N. Waco	2309 Fairview	4-4-24	7-13-36
					+72.3	+74.8	#619	#1865	2306 N. Waco	2301 Fairview	3-31-24	8-15-24
							#10		2305 Fairview			1-13-37
					+97.8		#618		2304 N. Waco			3-31-24
6	125.20	117.16	8.04			+00.3						
		117.28		6+58.8								
7	123.90	117.36	6.54		+00.0			#514	2686 2246 N. Waco		8-29-71	3-20-24
						+02.5						
					+25.0	+27.5		#10280				
					+50.0	+52.5		#1453		2251 Fairview		2-22-84
					+75.0	+77.5	#1409		2242 N. Waco			6-16-24
8	123.55	117.56	5.99		+00.0	+02.5	#1408	#2099	2240 N. Waco	2247 Fairview	6-16-24	12-13-71
					+25.0	+27.5		34547				9-15-24
					+50.3	+52.8	#293	#1868	2236 N. Waco	2243 Fairview	2-25-24	8-15-24
		117.68		8+62.7	+75.4	+77.9						
9	123.60	117.76	5.84		+00.3	+02.8	#508		2234 N. Waco			3-18-24
					+25.7	+28.2	#236	#696	2232 N. Waco	2237 Fairview	2-18-24	7-19-91
					+51.0	+53.5						4-11-24
					+78.2	+80.7	#235	#1821	2230 N. Waco	2231 Fairview	2-19-24	8-11-24
10	123.20	117.96	5.24		+01.0	+03.5		#1951		2225 Fairview		8-28-29
					+25.4	+27.9	#234		2220 N. Waco			2-19-24
					+50.6	+53.1		#1452		2223 Fairview		6-20-24
		118.09		10+65.6	+75.7	+78.2						
11	123.06	118.16	4.90		+01.0	+03.5	#292		2210 N. Waco			2-25-24
					+26.0	+28.5	#271	#1816	2216 N. Waco	2217 Fairview	2-23-24	8-8-24
					+51.3	+53.8	#609	#1523	2208 N. Waco	2207 Fairview	3-20-24	7-1-24
					+76.0	+78.5						
12	122.92	118.36	4.56		+01.5	+04.0	#228		312 W. 21st.			5-7-59
					+27.0	+29.5						2-18-24
					+51.5	+54.0						6-9-59
		118.52		12+82.5								

#1129 (308 W 52nd N) Walt Noren 9-3-80 (5/ 12+08.5)

- #1130-Tap-325 W. 23rd. - Preston (100' W. of 14+30.3)
- #207-Tap-310 W. 22nd. - 6-10-36 - Plummer & Skinnell
- #433-Private Line-312 W. 22nd. 10-17-41 - C.A. Preston
- #2031-2344 N. Waco - Private Line - 6-5-42 (2+68.9)
- #2586-Tap-2306 N. Waco - 1-14-46 - Roy E. Miller
- #1270-2257 Fairview - 11-15-43 - George Sargent
- #5915-Tap-2347 Fairview - 9-26-51 - Harry Mann

Seal off 4-29-71 - ad Henning (9+38.8)

99-6764-7 4-15-49 2216 30 Waco - Mills