
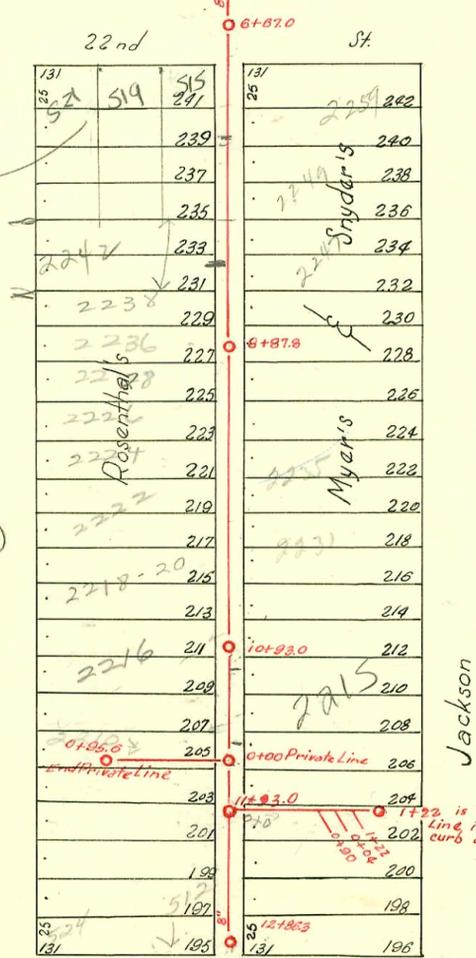


LAT. A - DIST. T - S.S. NO. 20

1919

23rd St

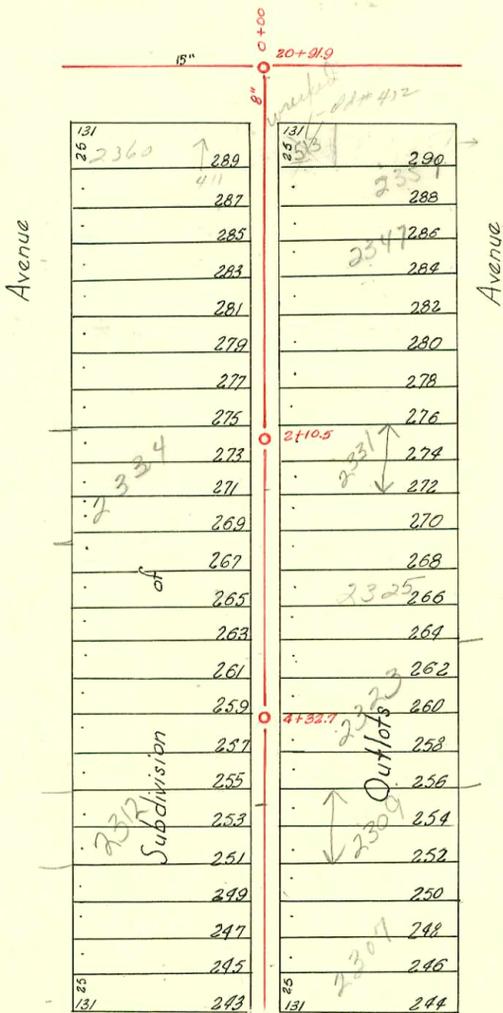

SLG W 22nd
1/22/02
Dan Kelly, MHC Chief
adv. to issue
Permit to issue
Comte to issue
SERU Line to PUC
for SLG so
add SLG to
over can be done
Crew in Maint advised
that all three houses
515, 519, 521 appear
to be on one line
OSL

2/24/03
Confirmed by
Oye test
By sewer
Main that
all three houses
are on one line that
TAPS 55' S. of
MH 6187
35X
Rosenthal

21st St
203-03199 12/8/03 2312 N. Rosenthal - Brand P/b's = 4" 40
PUC-Predco 60.3' 50' of MH 4+32.7 (4+93) 2V22, 1H45, 1TWIN CO, shallow
2003-01954 7/28/03 2309 Jackson Lonny Wright - City Wye
repair 4" Predco 149.6' N of MH 6167 (5+17.4) 2V45, 1U22,
1 Fernco, 4" 40 PUC, alley cut, Repair 10' sewer line @ Main

ref
SWR 2002-00188 1-22-02 519 W 22nd St N - Clearwater EFC - 2-6" Fernco at East
and west property lines, 2 wyes (6x4), 1 Fernco @ 4" line to 521 W 22nd St N, 2H22, 6" SCH 40 PUC
SWR 2003-0352 2-28-03 2242 N Rosenthal Brand P/b's - City Tap - 4" Predco 55' N of MH
6+87.8 (6+32.8) 2H22, 1TWIN CO, shallow, 4" 40 PUC

D52

CONSTRUCTION RECORD

SERVICE RECORD

STATION	ELEVATION		Depth	MANHOLE	4-INCH "Y" BRANCHES		No. of Permit		House Number		DATE OF PERMITS		
	Ground	Grade			North West	South East	North West	South East	North West	South East	North West	South East	
0+0	125.79	115.50	10.29		+93.8	+96.8	#2073		2360 Rosenthal	513 W 21st	9-21-54	4-3-74	
					+70.0	+72.5	#1079	#491	411 West 23rd	234 3116 Con Jackson	9-13-38	6-6-21	
					+94.1	+66.6	#2335	C44330	Rosenthal	2352 2357 Jackson	10-16-24	4-5-74	
1	126.34	115.65	10.69		+19.4	+21.0							
					+44.3	+46.8	#2179	#239	2340 Rosenthal	2337 Jackson	9-24-24	3-25-30	
					+67.7	+70.2	#2586		Rosenthal		11-21-24		
					+92.0	+94.5							
2	124.81	115.80	9.01	2+10.5	+17.6	+20.1	#967	#2414	2338 Rosenthal	2345 Jackson	9-2-25	9-16-24	
					+43.0	+45.5	#2177	#229	2336 Rosenthal	2331 Jackson	4-21-72	3-94	
					+68.2	+70.7					10-28-24	3-17-25	
					+88.8	+91.3	C54120	#855	2334 Rosenthal	2327 Jackson	3-10-76	8-14-24	
3	123.68	115.95	7.71		3+06.7		C31773		2332 Rosenthal		4-21-72		
					+13.7	+16.2	#692		2330 Rosenthal		6-26-25		
					+38.8	+41.3		#2712		2325 Jackson		12-16-24	
					+64.0	+66.5		C259		2325 Jackson		10-10-63	
					+89.0	+91.5		#2090		2319 Jackson		9-12-24	
4	123.16	116.10	7.06		+14.3	+16.8	#2343	C39459	2326 Rosenthal	2323 Jackson	6-11-73	10-16-24	
				1+32.7	+39.6	+42.1		C32167		2315 Jackson		5-12-72	
					+65.0	+67.5		#2711				12-16-24	
					+90.5	+93.0	#2481		2312 Rosenthal		10-31-24		
5	122.92	116.75	6.17		+17.0	+19.5		C4-10291-7		2309 Jackson	7-28-03	8-8-73	
					+41.0	+43.5		#589		2306 Jackson	5-27-25	5-12-72	
					+63.8	+66.3		C32167		2306 Jackson	8-21-24	8-21-24	
					+89.2	+91.7	C2172	#2581	C53304	2302 Rosenthal	2307 Jackson	5-12-72	1-21-76
6	122.67	116.90	5.77		6+16.5	6+19.0		C39987		2301 Jackson		3-29-75	
				6+67.0				#76				5-6-32	
7	122.28	117.05	5.23		+00.5	+25.7		C8255		2259 Jackson		9-8-75	
						+48.9		#167				7-24-35	
						+71.3		#395		2249 Jackson		5-12-26	
					+94.0								
8	122.13	117.20	4.93		+06.6	+09.1	#44457	#738	2242 Rosenthal	2247 Jackson	9-10-47	9-10-47	
					+31.9	+34.4	2240		2242 Rosenthal		5-26-25	3-29-73	
					+57.2	+59.7	577	#1372	2238 Rosenthal	2243 Jackson	12-11-24	5-23-52	
					+82.9	+84.9	C31989	#1124	2241 Rosenthal	2241 Jackson		10-12-25	
				8+87.8									
9	121.58	117.34	4.24		+07.3	+09.8	#2470		2228 Rosenthal		11-3-24		
					+32.7	+35.2	#2471		2226 Rosenthal		11-3-24		
					+57.5	+60.0	#2472		2224 Rosenthal		11-3-24		
					+82.5	+85.0		15585		2235 Jackson		5-7-62	
10	121.57	117.49	4.08		+07.9	+10.4	#1953		2231 Jackson		8-28-24		
					+32.8	+36.3	C33621	#3729	2222 Rosenthal		5-12-66	1-18-51	
					+58.4	+60.9		#654	2223 Jackson			6-17-25	
					+83.3	+85.8	#2257		2236 Rosenthal		10-9-24		
				10+93.0									
11	121.62	117.63	3.99		+08.2	+10.7	#2352	#1807	2216 Rosenthal	2215 Jackson	10-17-24	8-7-24	
					+33.5	+36.0		#334	2237 Jackson			2-7-55	
					+58.5	+61.0	#2541	#1028	2222 Rosenthal	2241 Jackson	11-29-26	11-14-24	
					+83.8	+86.3	C2293	#1895	502 West East 21st		11-2-64	8-19-24	
				11+93.0									
12	122.22	117.78	4.44		+09.3	+11.8	#2399		2222 Rosenthal		6-1-66	10-24-24	
					+36.8	+39.3	#1369		512 West 21st		6-10-24		
				12+86.3									

Private line West of alley				Y North	Y South							
0+00				0+00	0+92.6	#3726	#3725	2210 Rosenthal	524 West 21st		1-18-51	1-18-51
0+95.6				0+95.6								

26426 506 W. 21st - 10-31-90 - Clarence Fitzer
 502 W. 21st - 2-24-73 - M. Farland

97-217767 12-12-97 508 W 21st - Boardman

#2730
#2730
#2730

North End 8-19-24 - Ran private line from alley East to serve
 502-504-506 East 21st - Connected about 100' North of 12+86.3
 C.A. Baker - 514 West 21st - New Y set 57' North
 Day Night - 521 West 22nd - New Y set 75' South of 6+67 (7+42)
 #510 - Tap - 2338 Rosenthal - N.W. Brown - 5-15-28
 #234 - Tap - 512 West 21st - 5-19-37 - Brodie Pkg. Serv.
 #1117 - Private line - 2210 Rosenthal - 9-30-38 - O.W. Stinnett
 #2568 - Tap - 2218 Rosenthal - 8-19-42 - C.G. Leidy
 #3947 - Private line - 504 West 21st - 2-20-51 - Sheppard
 #2558 - Seal - 2218 Rosenthal - Jackson - 1-14-65 (11+58.5)
 C36527 - 2216 Rosenthal - Herb Hoover - New Conn. - 12-28-72 (11+88.2) (See C36436-5a)

2309 N. Jackson - 93-2392-7 - 4" SDR 35 - Tied into 4" clay tile line
 4" from main. Replaced 15' section 14" pf shallow
 wgt = 5+10.5 MHI = 4+07
 2309 N. Jackson - 94-10281-7 - Rep 150' N of MH 25+120 W 21st 4085
 93-2870 (11-8-93) 315 W 21st - Redd. Rupp - Sent notes to owner
 of 3 houses - no response from 515 W. 21st 51' North, per Dan.