



SEC. A - SUB-MAIN D - 1919
 LAT. D OF D - 1918
 S.S. NO. 20

1=100

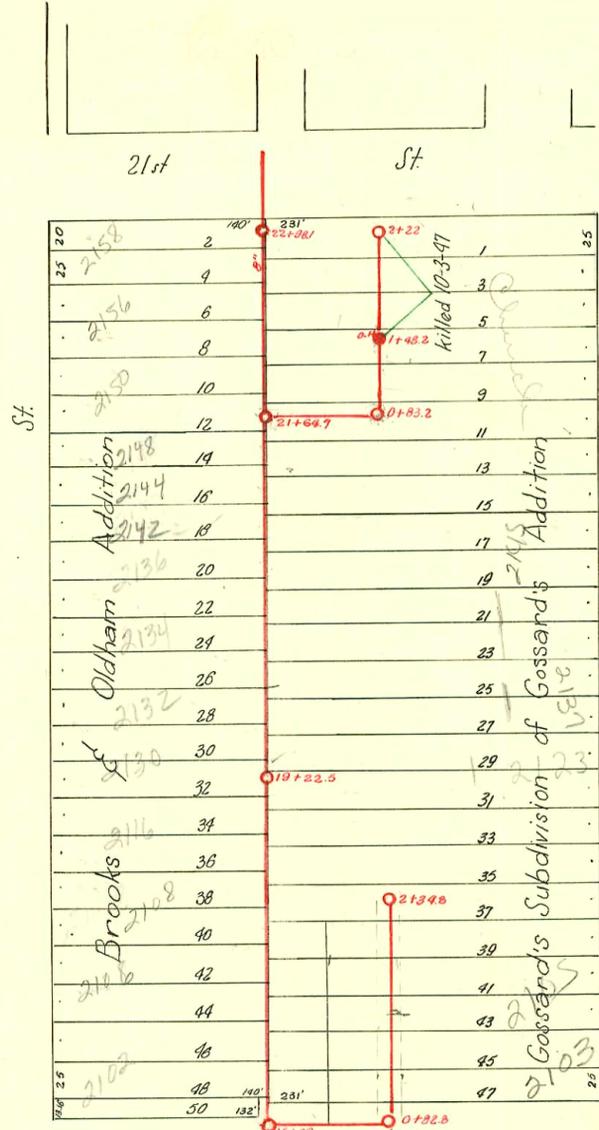

#124-2143 Wellington Place
 #125-2145 Feb. 13, 1928
 In private line South from
 from M.H. 0+83.2

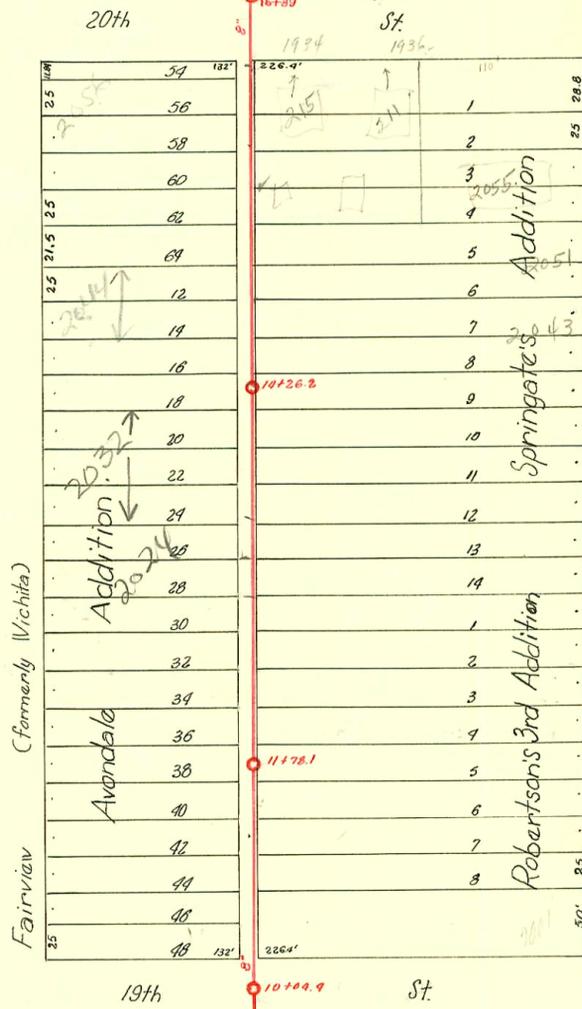

Fairview
 (Formerly Wichita)

Wellington

