


SEC. A - SUB-MAIN R - 1919
 LAT. F OF R - 1918
 S.S. NO. 20

1=150

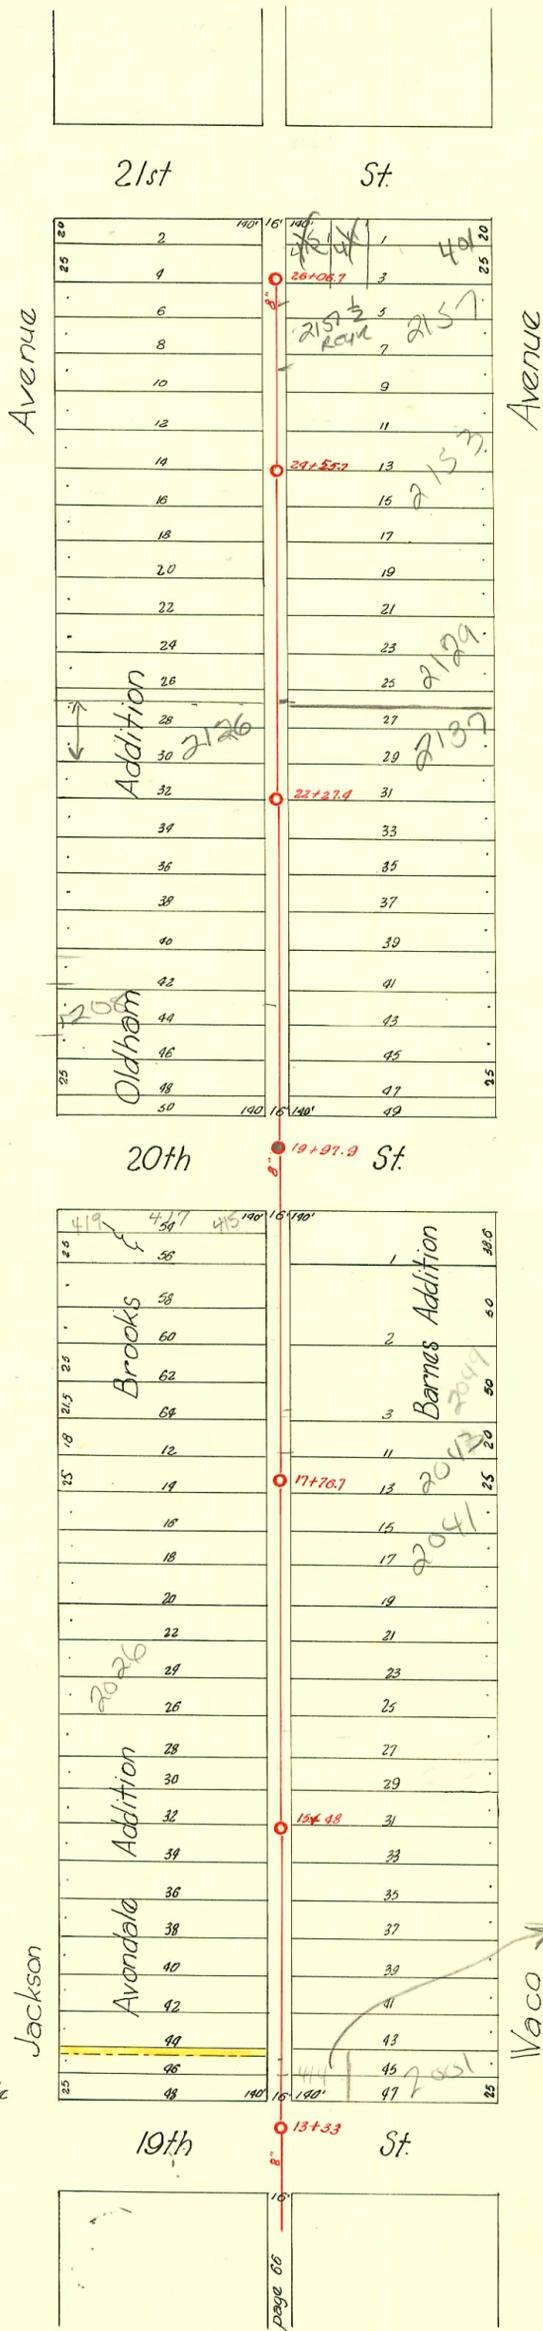

Easement #8M - July 12, 1920
 Otto Zimmerman & City of Wichita
 N. 5, lot 46, Jackson Avenue, Avondale
 Addition.

414 with private eas granted to 2001 N Vaco to maintain their sewer line across 19th. No special assessment recorded 11/29/94 at Reg. of Deeds Sedg Co. SK

Sub 2002-01619 411 w 21st^{S10} Boardman (19' S. of MH) 6/6-2002 5/0 15' 5 of MH
 Sub 2002-01580 415 w 21st^{S10} Boardman (18.6' S. of MH) 6/6/2002 5/0 18.6' 5 of MH
 Sub 2002 03175 11-21-02 401 w. 21st N - ASAP : tied into old s/p @ 18' S of MH
 MH 2610617 (25+88.7) ferno 3' from main, 1045, 1 twin co, ferno @ structure, 4" 40 PUC

CONSTRUCTION RECORD							SERVICE RECORD					
STATION	ELEVATION		Depth	MANHOLE	4-INCH "Y" BRANCHES		No. of Permit		House Number		DATE OF PERMITS	
	Ground	Grade			North West	South East	North West	South East	North West	South East	North West	South East
13	120.70	114.30	6.40									
			5.9	13+33	+67.2	+67.7		9-01337		2001 Waco R		11-29-99
					+90	+87.5		#315				4-23-20
14	120.54	114.40	6.14		14+15.8	+13.3				3005 Waco		5-2-20
					+41.1	+38.6		#358				
					+66.8	+64.3				2012 Jackson	2009 Waco	2-28-20
					+92.2	+89.7	#143	#934				8-24-25
15	120.51	114.50	6.01		15+15.6	+13.1				2018 Jackson	2017 Waco	2-28-20
					+40.9	+38.4	#144	#648				3-17-19
			5.95	15+48	+64.8	+62.3	#779					8-23-20
					+91.4	+88.9		#897		2021 Waco		1-19-19
16	120.34	114.50	5.74		16+17.9	+15.4				2027 Waco		1-11-19
					+43	+41.5		#693				
					+67.7	+67.2	#589			2036 Jackson		5-21-22
					+93	+92.5	#1373	#701		2039 Jackson	2037 Waco	9-18-23
17	120.10	114.70	5.40		17+20.1	+17.6						
					+45.6	+43.3	#1948			2020 Jackson		10-8-49
					+71.2	+68.7						
			5.10	17+76.7	+96.7	+94.2	#889	#727		2044 Jackson	2043 Waco	7-18-49
18	120.01	114.80	5.21		18+22.3	+19.8						
					+47.3	+44.8	#2320	#1464				11-2-22
					+72.8	+70.3	#1287			2042 Jackson		10-15-24
					+92.5	+96	#204			2054 Jackson		7-24-91
19	120.11	114.80	5.21		19+24.3	+21.8						
					+49.6	+47.1	#32	#115		1958 Jackson		1-9-23
20			5.90	19+97.7	20+12.1	20+16.6						
	120.43	115.00	5.43		+44.5	+42	#373	#283		2102 Jackson	2101 Waco	4-15-29
					+70.2	+67.7		#1115		2109 Waco		4-6-22
					+93.1	+90.6	#520	#573		2110 Jackson	2105 Waco	12-16-27
21	120.34	115.10	5.24		21+18.5	+16						
					+44.2	+41.7	#671			2112 Jackson		5-28-28
					+62.5	+67						
					+95.2	+92.7	#221	#232		2116 Jackson	2116 Waco	6-25-28
22	120.98	115.20	5.28		22+20.5	+18						
			5.1	22+27.4	+45.8	+43.3	#782	#852		2120 Jackson	2115 Waco	3-23-26
					+68.5	+66	#167			2126 Jackson		10-8-27
					+93.9	+91.4		#506		2137 Waco		11-2-28
23	120.44	115.30	5.14		23+18.8	+16.3						
					+43.0	+41.4	#1091	#1515		2128 Jackson	2141 Waco	4-10-23
					+70	+67.5	#1003			2130 Jackson		10-11-28
					+92.0	+90.4	#915	#1867		2136 Jackson	2145 Waco	9-17-28
24	120.75	115.40	5.35		24+16.9	+14.4						
					+43.5	+41	#864			2144 Jackson		8-27-28
			5.5	24+55.7	+69.5	+67	#1608	#1862		2153 Waco	2155 Waco	8-14-28
					+94.8	+92.3	#2036			2142 Jackson		10-27-21
25	121.84	115.50	6.34		25+20.5	+18						
					+48.5	+45.5	#1466			2157 Waco		11-2-23
					+71.5	+69						10-4-23
					+94.3	+91.8	#2086	#690		2150 Jackson	2101 Waco	12-18-23
26	121.93	115.60	6.33									
			5.25	26+06.7								

1999-01381- 12/7/99- 414 W 19th St N- RD Campbell- 4" SCH40- PVC Saddle- 71' N of MH 13+33(14+04) trap installed, 2 TWIN 60, 2 Kickouts, 1V45

2000-00815- 2043 N WACO AVE- Repair- Rons Plumb- Replaced 4' of 4" clay tile 5' off main with 4' 4" PVC SCH40 - 2-4" CLAY TILE X 4" SCH40 PVC FERRO COUPLINGS

#8523 415 W 21st 6-28-83 : 59 25+42.6

S.O. 045960 #1374 - Tap - 20th West 20th St - 9-16-29 - H.S. Biale - 7-30-94
 #2041 - Tap - 2024 Jackson - 5-9-45 - R. Lo Fay
 #2781 - Tap - 410 West 20th St - 11-26-54 - Coleman Pkg.
 #4950 - Tap - 2157 N Waco - 7-31-57
 S.O. C34534 - 419 1/2 20th - Al Henning - 8/28/72
 N.C. #92-7740-7 - 2108 N Jackson - 4" PVC 40 - 4" City tap - 110.5 north
 Replaced lower 60' 1/4" pt - shallow - dirt alley cut

S.O. 2004-1128 4/21/04 2157 1/2 N WACO (Rear) Sto
 AF Henning
 N/C S.O. 2000-00275 - 2-13-06 - 2153 N Waco - 14' s of mth, Predco, (C) 450,
 (1) twin clay shallow 4" sch 40 - Brand PIM