


LAT. E - DIST. T - S. S. NO. 20
 DOBSON & HUMPHREY
 1930

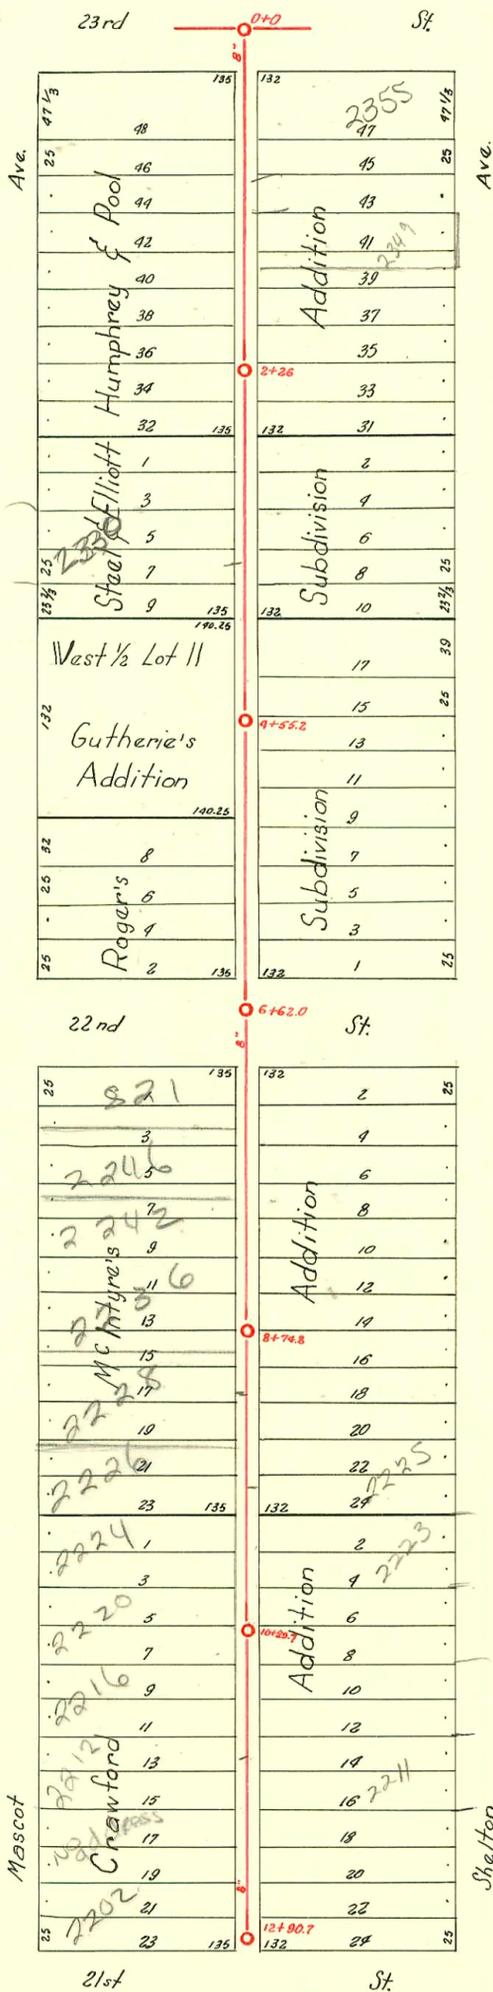

D-61

CONSTRUCTION RECORD							SERVICE RECORD					
STATION	ELEVATION		Depth	MANHOLE	4-INCH "Y" BRANCHES		No. of Permit		House Number		DATE OF PERMITS	
	Ground	Grade			North West	South East	North West	South East	North West	South East	North West	South East
0+0	123.29	116.26	7.00	0+0	0+49 0+74.1	0+46.5 0+71.6	#921	#30433	2356 Mascof	2355 Shelton	8-2-50	7-21-92 7-25-30
1+0	123.64	116.35	7.29		0+98.7 1+24.3 1+49.2 1+73	0+96.2 1+21.8 1+46.7 1+70.5	#822	#840	2352 Mascof	2351 Shelton	8-2-50	9-8-30 6-23-30
2+0	123.84	116.45 116.47	7.39	2+26	1+99 2+19 2+51 2+76	1+96.5 2+16.5 2+48.5 2+73.5	#171	#883	2344 Mascof	2347 Shelton	3-21-50	9-20-30 6-23-30
3+0	122.94	116.55	6.39		2+76 3+0 3+25.9 3+50.7	2+73.5 2+97.5 3+23.4 3+48.2	#169	#3122	2340 Mascof	2331 Shelton	3-21-50	11-14-50
4+0	123.55	116.65 116.70	6.90	4+55.2	3+76.5 4+01.1 4+26.3 4+49.8 4+76.5	3+74 3+98.6 4+23.8 4+47.3 4+74.0	#2589	#2862	2338 Mascof	2335 Shelton	10-6-50	10-16-52
5+0	123.62	116.75	6.87		4+01.1 4+26.3 4+49.8 4+76.5 5+01 5+28.3 5+51.8 5+76.3	3+98.6 4+23.8 4+47.3 4+74.0 4+98.5 5+25.8 5+74.3 5+73.8	#3439	#3438	2328 Mascof	2317 Shelton	12-20-50	1-8-50
6+0	123.6	116.85 116.91	6.75	6+62.0	4+76.5 5+01 5+28.3 5+51.8 5+76.3 6+01 6+28.3	4+74.0 4+98.5 5+25.8 5+74.3 5+73.8 5+98.5 6+25.8	#6900	#455	2311 Shelton	2301 Shelton	11-14-55	5-1-72 5-3-30
7+0	122.99	116.95	5.54		6+01 6+28.3 7+41.5 7+68.5 7+93.8	5+98.5 6+25.8 7+39 7+66 7+91.3	#3822	#704	821 West 22nd	2257 Shelton	3-8-55	7-11-30
8+0	121.69	117.05 117.12	4.64	8+74.8	7+41.5 7+68.5 7+93.8 8+18 8+46.8 8+68.5 8+93.5	7+39 7+66 7+91.3 8+15.5 8+44.3 8+66 8+91	#787	#606	2242 Mascof	2237 Shelton	8-7-30	7-10-30
9+0	122.29	117.15	5.14		8+46.8 8+68.5 8+93.5 9+18 9+43.5 9+68.9	8+44.3 8+66 8+91 9+15.5 9+41 9+66.4	#697	#656	2235 Mascof	2231 Shelton	7-10-30	6-30-30 6-30-30
10+0	122.29	117.25 117.33	5.04	10+85.7	9+18 9+43.5 9+68.9 9+93 10+13.5 10+38.1	9+15.5 9+41 9+66.4 9+90.5 10+11 10+35.6	#721	#5595	2228 Mascof	2229 Shelton	7-17-30	11-3-67
11+0	121.59	117.35	4.24		9+43.5 9+68.9 9+93 10+13.5 10+38.1 10+64 10+93.2	9+41 9+66.4 9+90.5 10+11 10+35.6 10+61.5 10+90.7	#779	#282	2226 Mascof	2211 Shelton	7-17-30	6-30-30 6-24-30 5-22-51 5-22-51
12+0	121.11	117.45	3.66		10+64 10+93.2 11+16 11+41 11+68.5 11+91	10+61.5 10+90.7 11+13.5 11+38.5 11+66 11+88.5	#280	#4878	2216 Mascof	2217 Shelton	4-3-50	4-17-53
12+00.7	121.91	117.59	9.47	12+90.7	11+41 11+68.5 11+91 12+16 12+40.5 12+65.5	11+38.5 11+66 11+88.5 12+13.5 12+38 12+63	#2925	#726	2212 Mascof	2211 Shelton	12-23-40	12-29-77
					12+16 12+40.5 12+65.5 12+87	12+13.5 12+38 12+63 12+84.5	#2113	#187	2208 Mascof	2208 West 21st	7-17-30	3-1-40 5-9-49 8-22-40

Reconnect - 2003-01685-7/2/03-2228 Mascof - Cummings + Fitzsimmons - City tap 4" Predco 50.8' S of MH 8+74.8 (9+35.6) 4" PVC

2002-01443 6/12/02 2330 N Mascof Wichita Ex - City repair 4" Predco 104.5' N of MH 4+55 (3+50.5) 1/4" PVC

5/0 596 2225 N Shelton 7-5-91 measuring s/o dist alley cut top 115.5' S of MH

Jap #34195-2301 Shelton - 8-10-72 - J.P. Lewis (5+29)

#815 - Tap - 2259 Shelton - 8-25-30 - M.L. Lansdowne

Jap #24032-806 W 22nd - 4-29-71 - Al Hemming