

Street

Washington

Ida

Laura

Pattie


Lulu

Ellis

Fannie (now Greenwood)

Hydraulic

Indianapolis

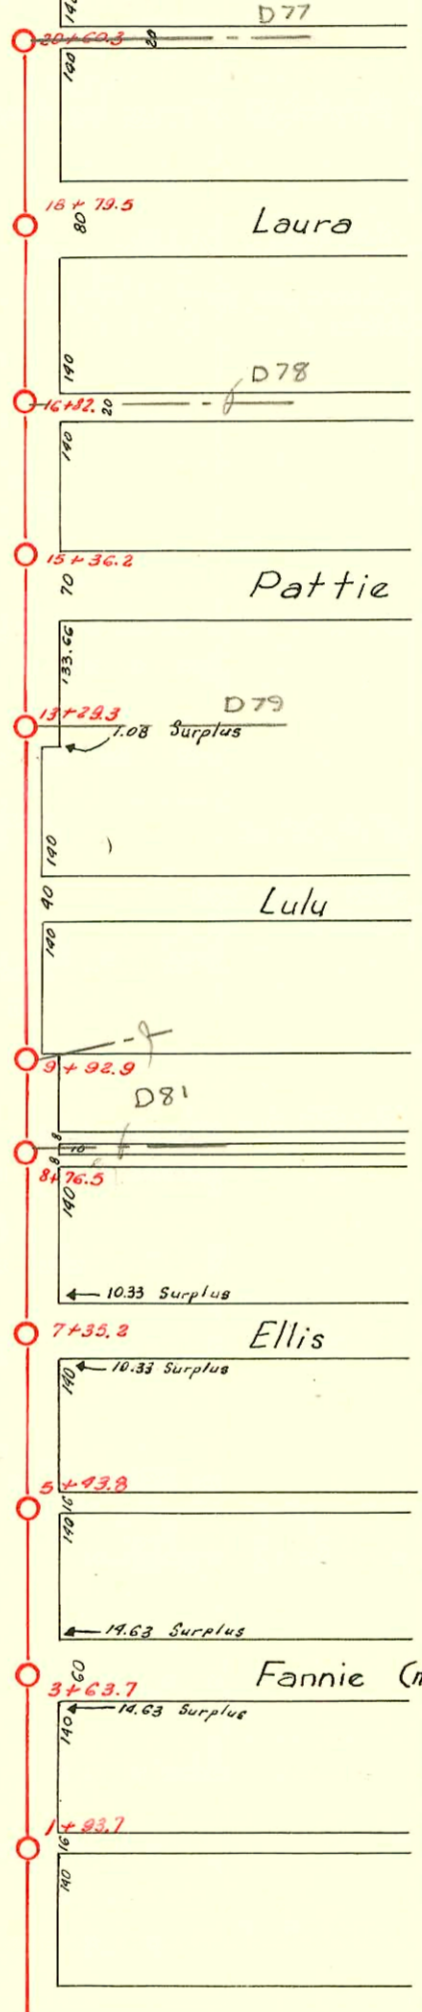

CONSTRUCTION RECORD

SERVICE RECORD

LAT 21 MAIN 4 SWI (CONT)

STATION	ELEVATION		Depth	MANHOLE	4-INCH "Y" BRANCHES		No. of Permit		House Number		DATE OF PERMITS	
	Ground	Grade			North West	South East	North West	South East	North West	South East	North West	South East
3+00	116.4	107.96	8.4	2+99.5		3+06.5		C72642		428 Meadowhaven	433-35 Carlton	6-29-79
4+00	117.2	108.16	9.0		3+22.2	3+84.5		C72642 9591		428 Meadowhaven	425-28 Carlton	2-13-79 9-24-80
5+00	117.4 117.7	108.36 108.51	9.0 9.2	5+73.3		4+37.4 5+29.3		C72641 7189		421-23 Carlton	418-15 Carlton	6-29-79 12-15-82
6+00	117.8	108.56	9.2			5+87.8		7188			405-7 Carlton	12-15-82
7+00	118.0 118.4	108.76 108.91	9.2 9.5	7+76.6	4" STUB NW	6+88.6 see below		C69639 93-12859-7 272701		346 Meadowhaven		12-1-78 5-25-93 7-3-79
20	107.80	99.99	5.81		+60.3							
19	107.90	99.89	6.06		+79.5							
18	107.73	99.69	8.04									
17	107.83	99.54	8.29									
16	108.23	99.39	8.84		+82.0							
15	109.10	99.16	9.94		+36.2							
14	108.60	99.09	9.51									
13	108.65	98.94	9.71		+29.3							
12	108.88	98.79	10.09									
11	108.03	98.64	9.44									
10	107.88	98.49	9.39									
9	109.13	98.34	5.79		+92.9							
8	103.53	98.19	5.34		+76.5							
7	103.26	98.04	5.22		+35.2							
6	103.26	97.89	5.37									
5	102.80	97.74	5.06		+43.8							
4	102.60	97.59	5.01									
3	102.00	97.44	4.56		+63.7							
2	101.98	97.29	4.69									
1	101.88	97.14	4.74		+93.7							
0+00	103.58	96.99	6.59									

#93-12859-7 - Replace - 3/4" S. Meadowhaven - 5/25/93 - 4" PVC 40' 1/4" - Replaced 25 ft. of pipe from house out towards main