


RECORD

DATE OF RECORD
DATE OF PLAN

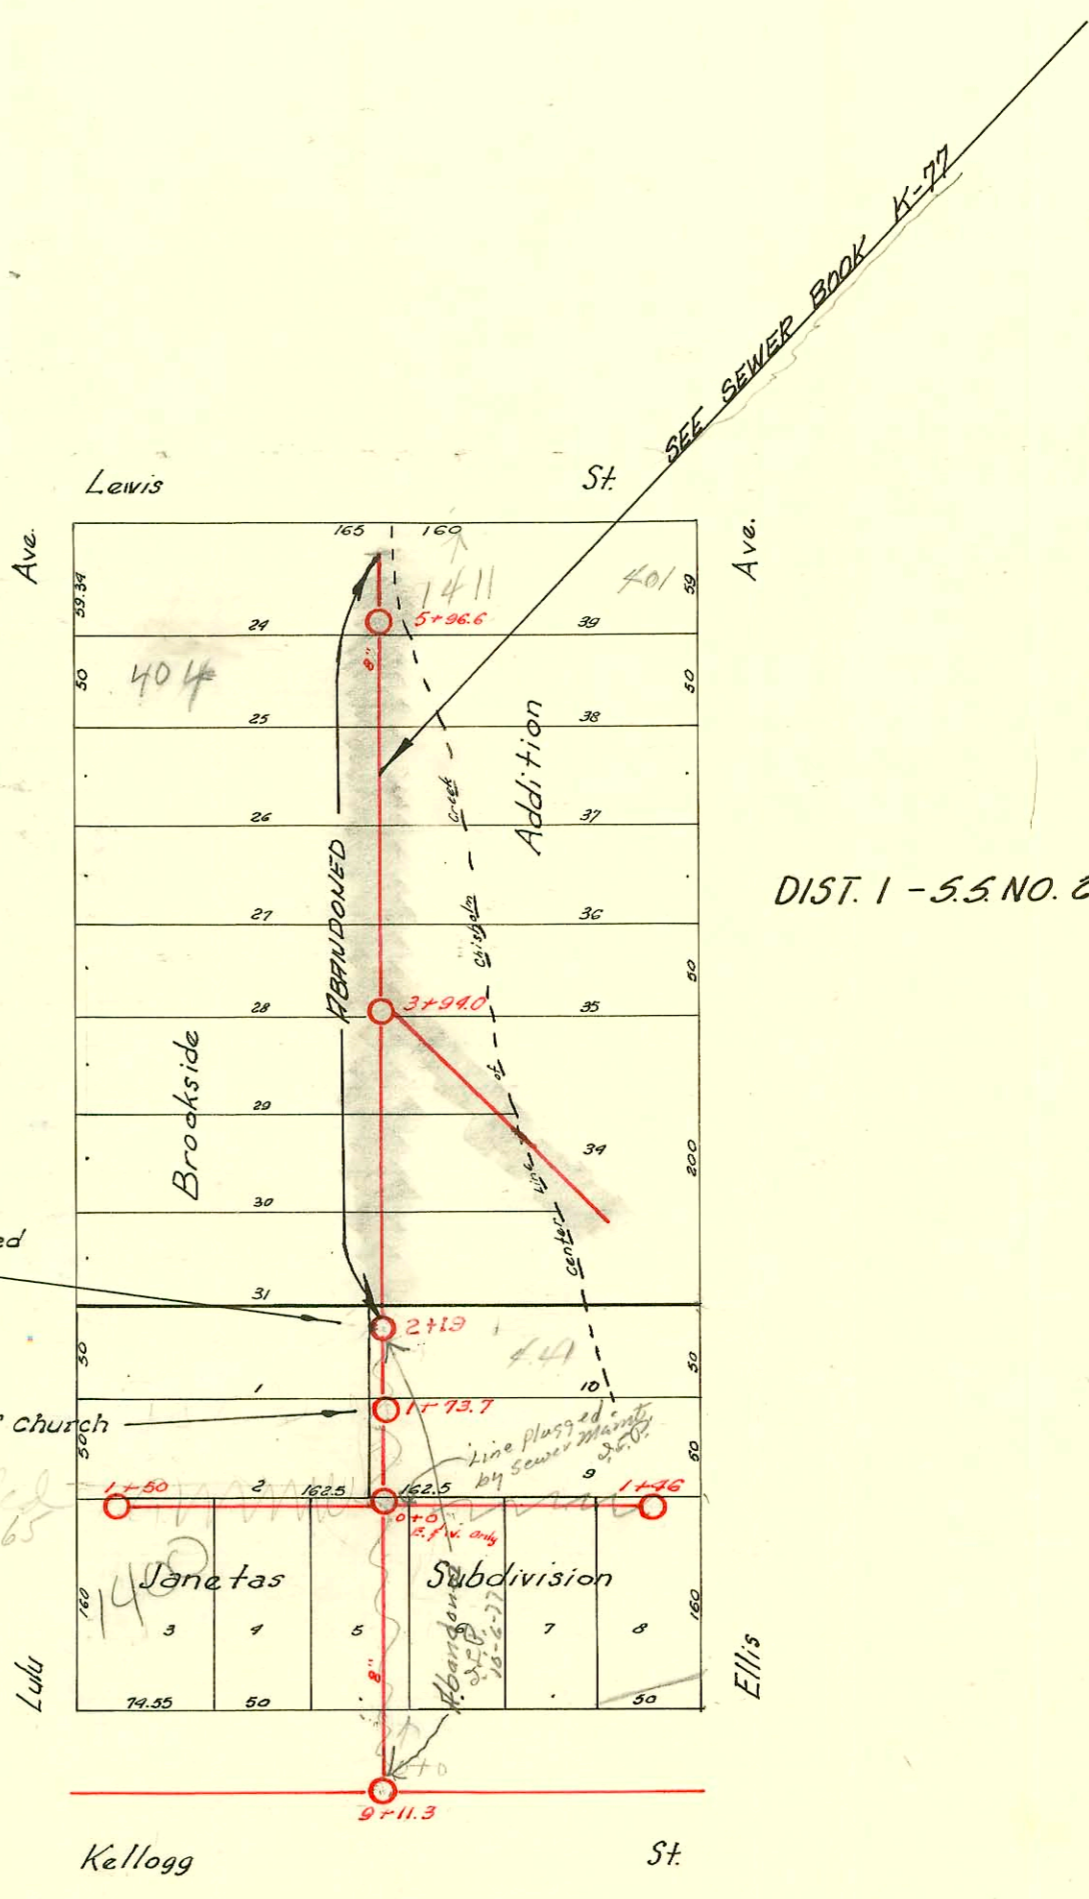

DIST. 1 - S.S. NO. 20 - 1919

New Tank M.H. constructed Aug. 12, 1965

Note: M.H. partly under conc. steps of Church

filled 8-6-65 (Planned)

Line Plugged by Sewer Main 2-6-65

Abandoned 2-1-65 20-5-77

CONSTRUCTION RECORD

SERVICE RECORD

Line East from Sta. 0+0
105' N. of Kellogg

Line West from Sta. 0+0
105' N. of Kellogg

STATION	ELEVATION		Depth	MANHOLE	4-INCH "Y" BRANCHES		No. of Permit		House Number		DATE OF PERMITS		
	Ground	Grade			North West	South East	North West	South East	North West	South East	North West	South East	
0+0	104.14	99.02	5.12	0+0		0+19		#182		1412 E. Kellogg		3-10-25	
+50	104.41	99.08	5.33		0+50	+45		#183		1416 E. Kellogg		3-10-25	
1+0	101.23	99.14	2.09			+96							
+46	104.75	99.20	5.55	1+46		+39.5		#1393		457 Ellis		9-21-23	
0+0	104.14	99.02	5.12	0+0		0+19		#181		1410 E. Kellogg		3-10-25	
+50	105.18	99.08	6.10		0+61	+73		#105	450 Lulu	1430 E. Kellogg		2-12-26	
1+0	104.53	99.14	5.39			+98.5		#1204		1406 E. Kellogg		11-4-25	
+50	105.03	99.20	5.88	1+50		+42							
1+65	102.46	99.88	2.58	End of stub	West	East		#1740		431 Ellis		1-9-16-23	
1	102.98	99.74	3.24			+42.0		2. #16578		429 Ellis		1-16-63	
3+94.0				0+00.0		+52.0		#1052		425 Ellis		8-21-22	
0+00	103.18	99.64	3.54			+14.0		#1037				8-18-22	
Stub S.E. from Sta. 3+94.0													
6	105.40	99.75	5.65			+18.5	+16.0						
					+96.6	+97.5	+95.0	#212	#195	445 Lulu	1411 E. Kellogg	2-26-52	3-17-22
						+70.3	+67.8	#628	#187	429 Lulu	417 Ellis	8-9-20	3-18-21
						+45.5	+43.0						
5	104.56	99.65	4.91			+418.7	+16.2						
					#	+93.5	+91.0	#803	#741	412 Lulu	409 Ellis	7-10-22	6-27-22
						+66.5	+64.0						
						+41.5	+39.0		#1139		417 Ellis		3-1-22
4	104.69	99.55	5.14			*+16.5	+13.0	#1126	#1095	424 Lulu	421 Ellis	7-15-24	8-25-22
					+94.0	+96.5	+89.0						
						+66.0	+63.5	#292		438 Lulu		4-19-20	
3	105.06	99.50	5.56			+14.5	+12.0						
						+89.6	+87.1	#281				2-26-23	
						+61.5	+59.0	#300				3-1-23	
						+36.5	+34.0						
2	104.53	99.70	5.13			+11.5	+9.0	#1114	#184	446 Lulu	441 Ellis	5-15-24	3-10-25
					+73.7								
						+58.3	+55.8	#1111		448 Lulu		5-14-24	
						+33.5	+31.0						
1	104.15	99.30	4.85			+82.5	+80.0						
						+58.0	+55.5		#119		445 Ellis		2-25-25
0+00	104.94	99.20	5.74										

* - 14' Spur West
 + = 20' " "
 # = 14' " "
 @ = 14' " "

2145 - Private Line - 441 Ellis - 7-9-45 - Jensen Pkg. Co.
 # 895 - used old connection - 1400 E. Kellogg - 5-18-54 - Craekmore Pkg. Co.
 # 1029 - Tap - 1400 E. Kellogg - 5-21-54 - Craekmore Pkg. Co.
 # 541 - Tap - 1430 E. Kellogg - 4-17-56 - Kendall Pkg. Co.
 # 4775 - Tap - 431 Ellis - 7-9-57 - Craekmore Pkg. Co.
 # 4775 - Tap - 431 Ellis - 7-9-57 - Craekmore Pkg. Co.
 # B4605 - Tap - 1400 E. Kellogg - Gerald Thompson - 11-22-65 (16' S. of 0+0)
 # 636334 63634 - Tap 1400 E. Kellogg - Dean Laffer - 10-21-77